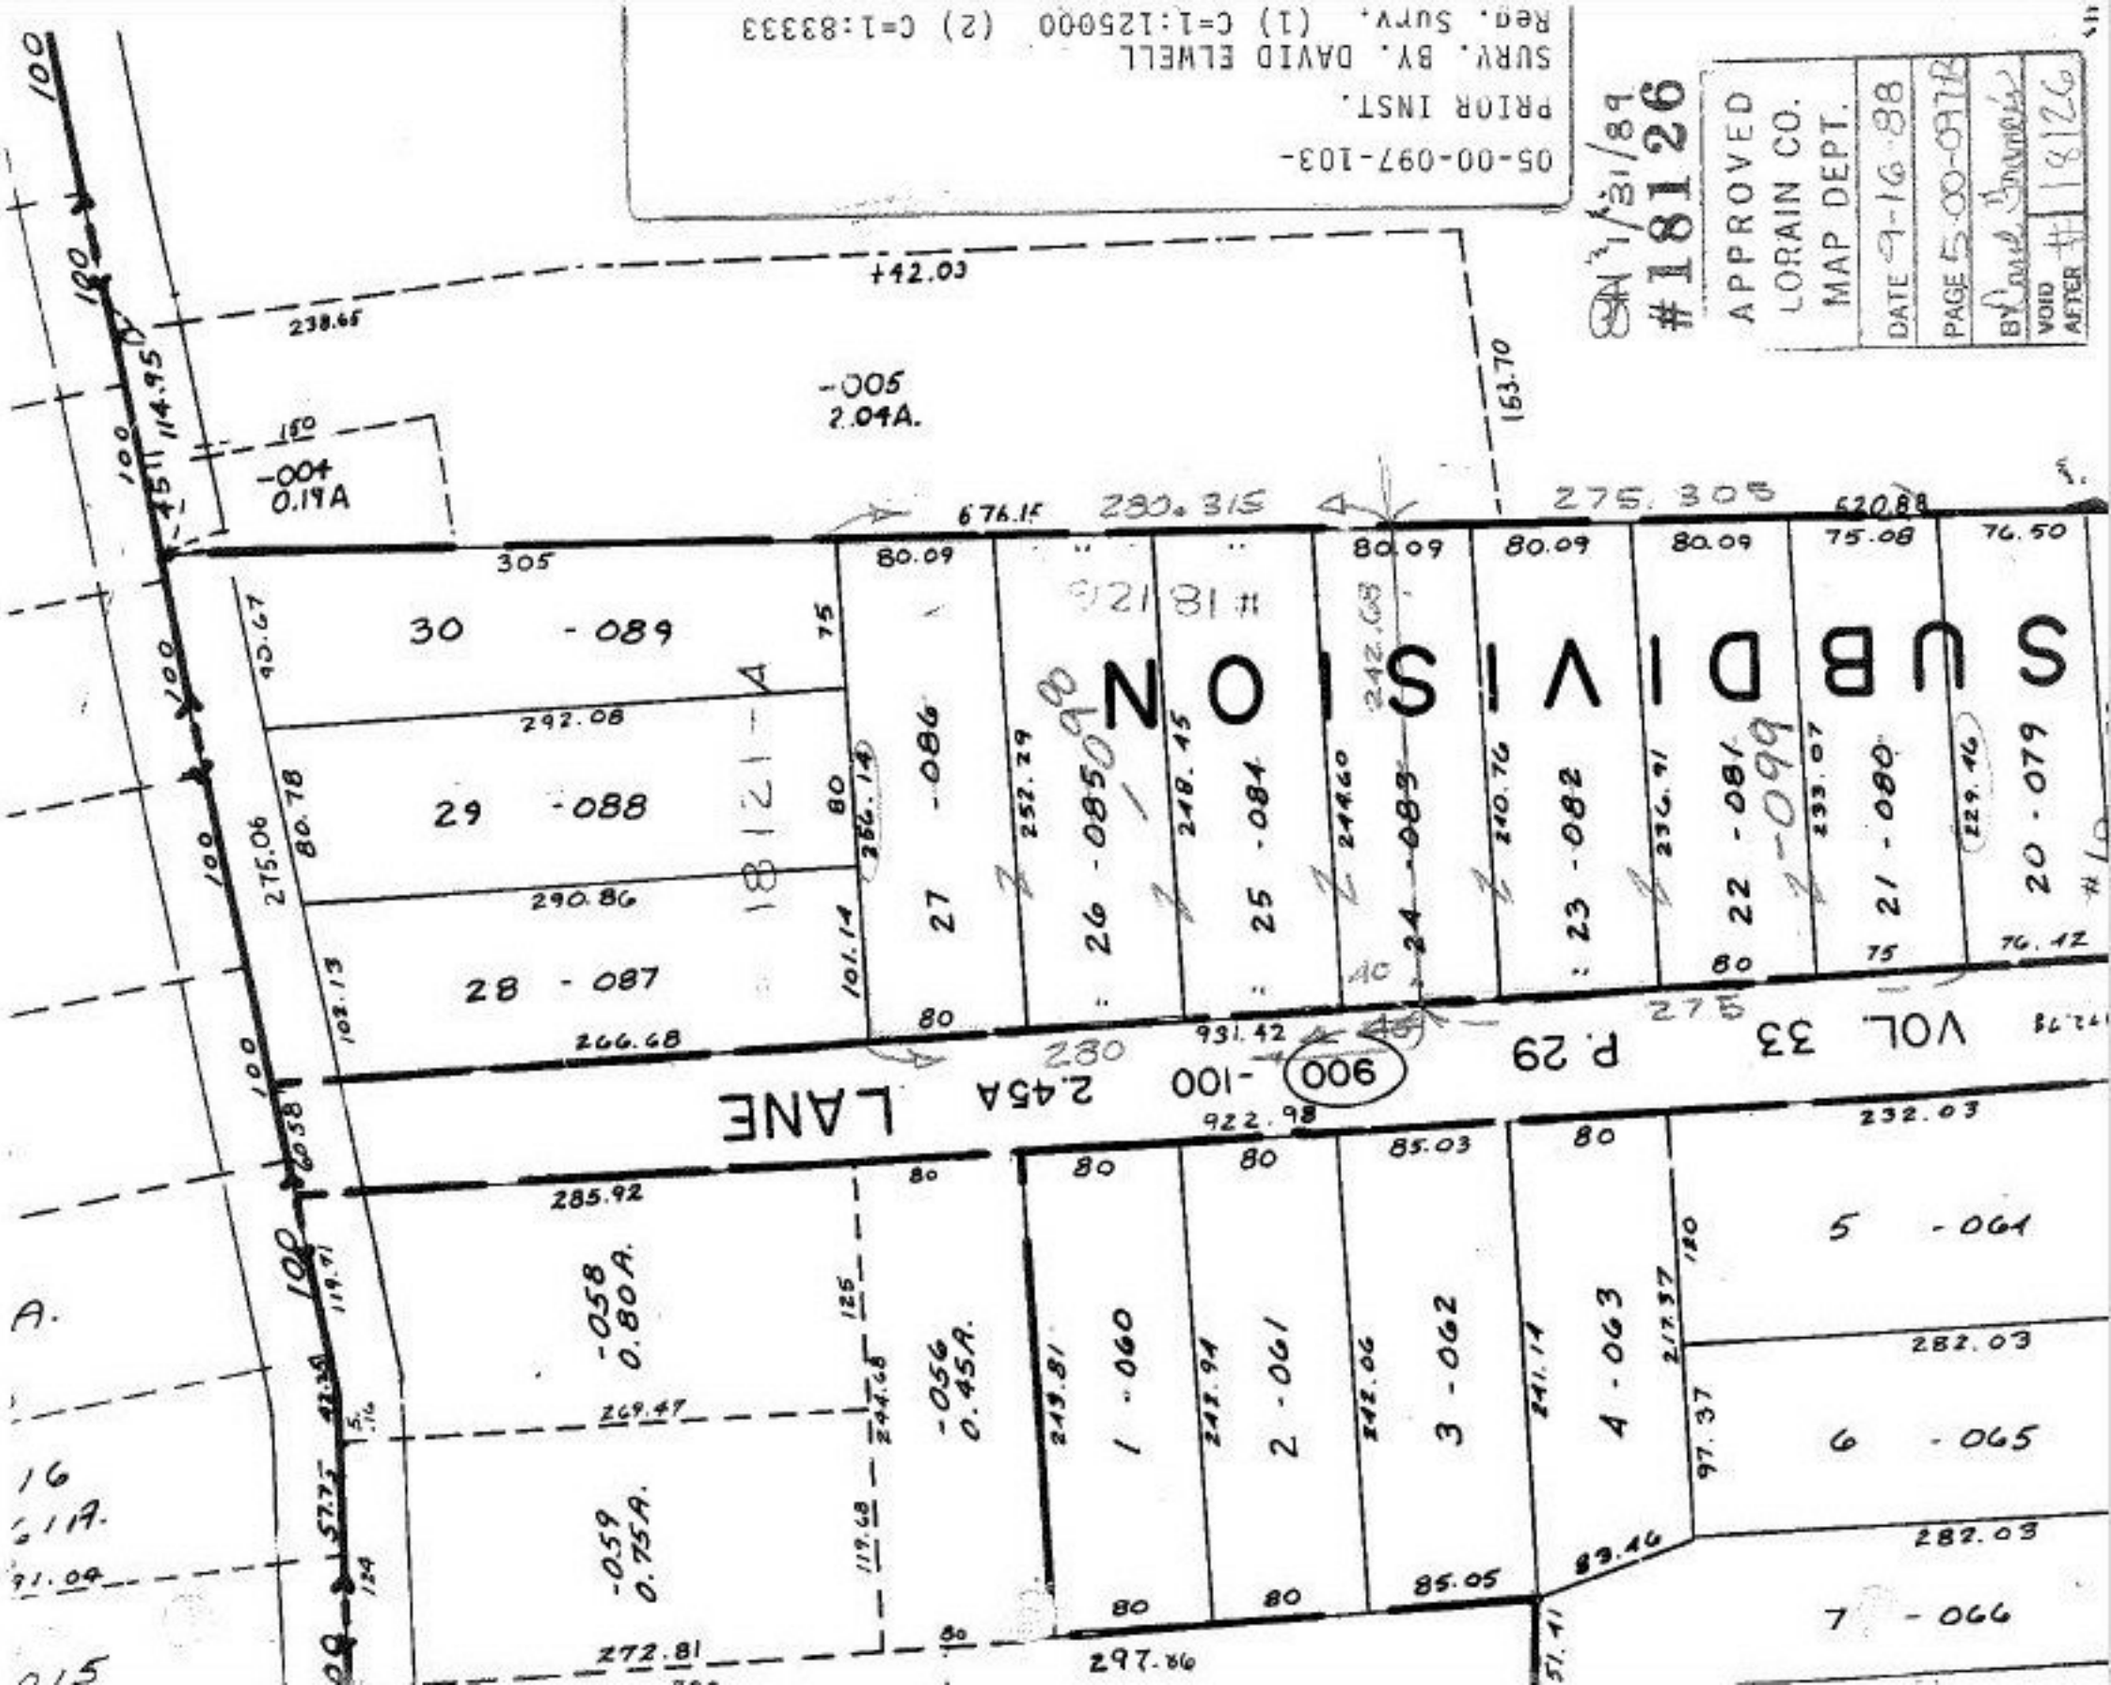
05-00-097-103-
PRIOR INST.
SURV. BY. DAVID ELWELL
Reg. Surv. (1) C=1:125000 (2) C=1:83333
APPROVED
LORAIN CO.
MAP DEPT.
DATE 9-16-88
PAGE 5-00-097B
BY
VOID AFTER
#18126
1/31/89
#18126
SUBDIVISION
VOL 33 P 29
LANE
2.45A
-100
900
-005
2.04A.
-004
0.19A
-058
0.80A.
-056
0.45A.
-059
0.75A.
30 - 089
29 - 088
28 - 087
27 - 086
26 - 085
25 - 084
24 - 083
23 - 082
22 - 081
21 - 080
20 - 079
1 - 060
2 - 061
3 - 062
4 - 063
5 - 064
6 - 065
7 - 066
#18121-A
#18121
#18098
-099
#18
676.15
280.315
275.305
620.88
163.70
242.68
238.65
114.95
305
292.08
290.86
285.92
275.06
266.68
931.42
922.98
272.81
297.86
269.47
232.03
282.03
282.03
212.37
97.37
89.46
80.09
75.08
76.50
76.42
85.03
85.05
80
75
100
180
125
124