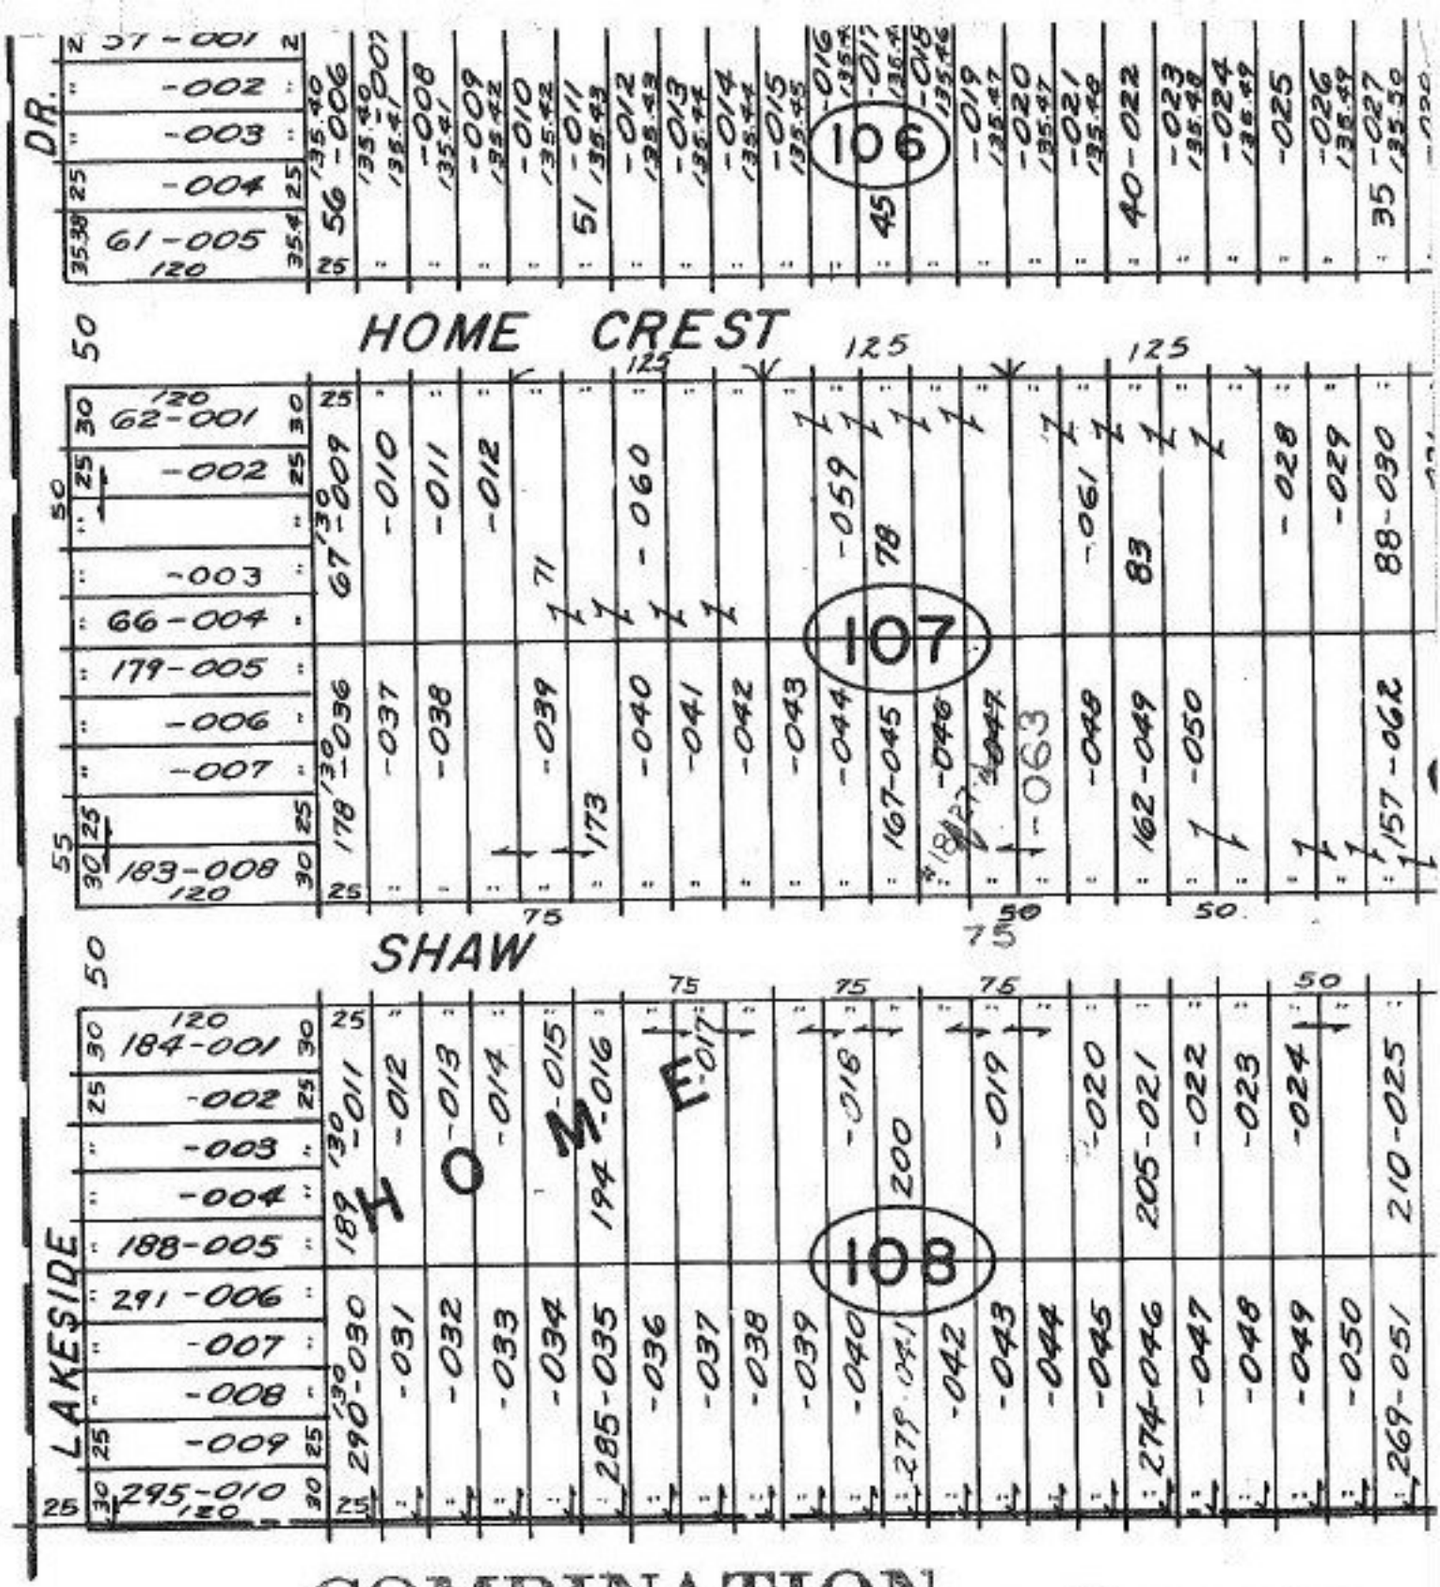

10/14/88

#18127-A

APPROVED
LOR[illegible]
MAP DEPT.

DATE 10-6-88

PAGE 7-00-026 D

BY CAROL-FRANCES

VOID AFTER # 18127-A

RIDGEVILLE TWP.

SCALE: 1" = 100'