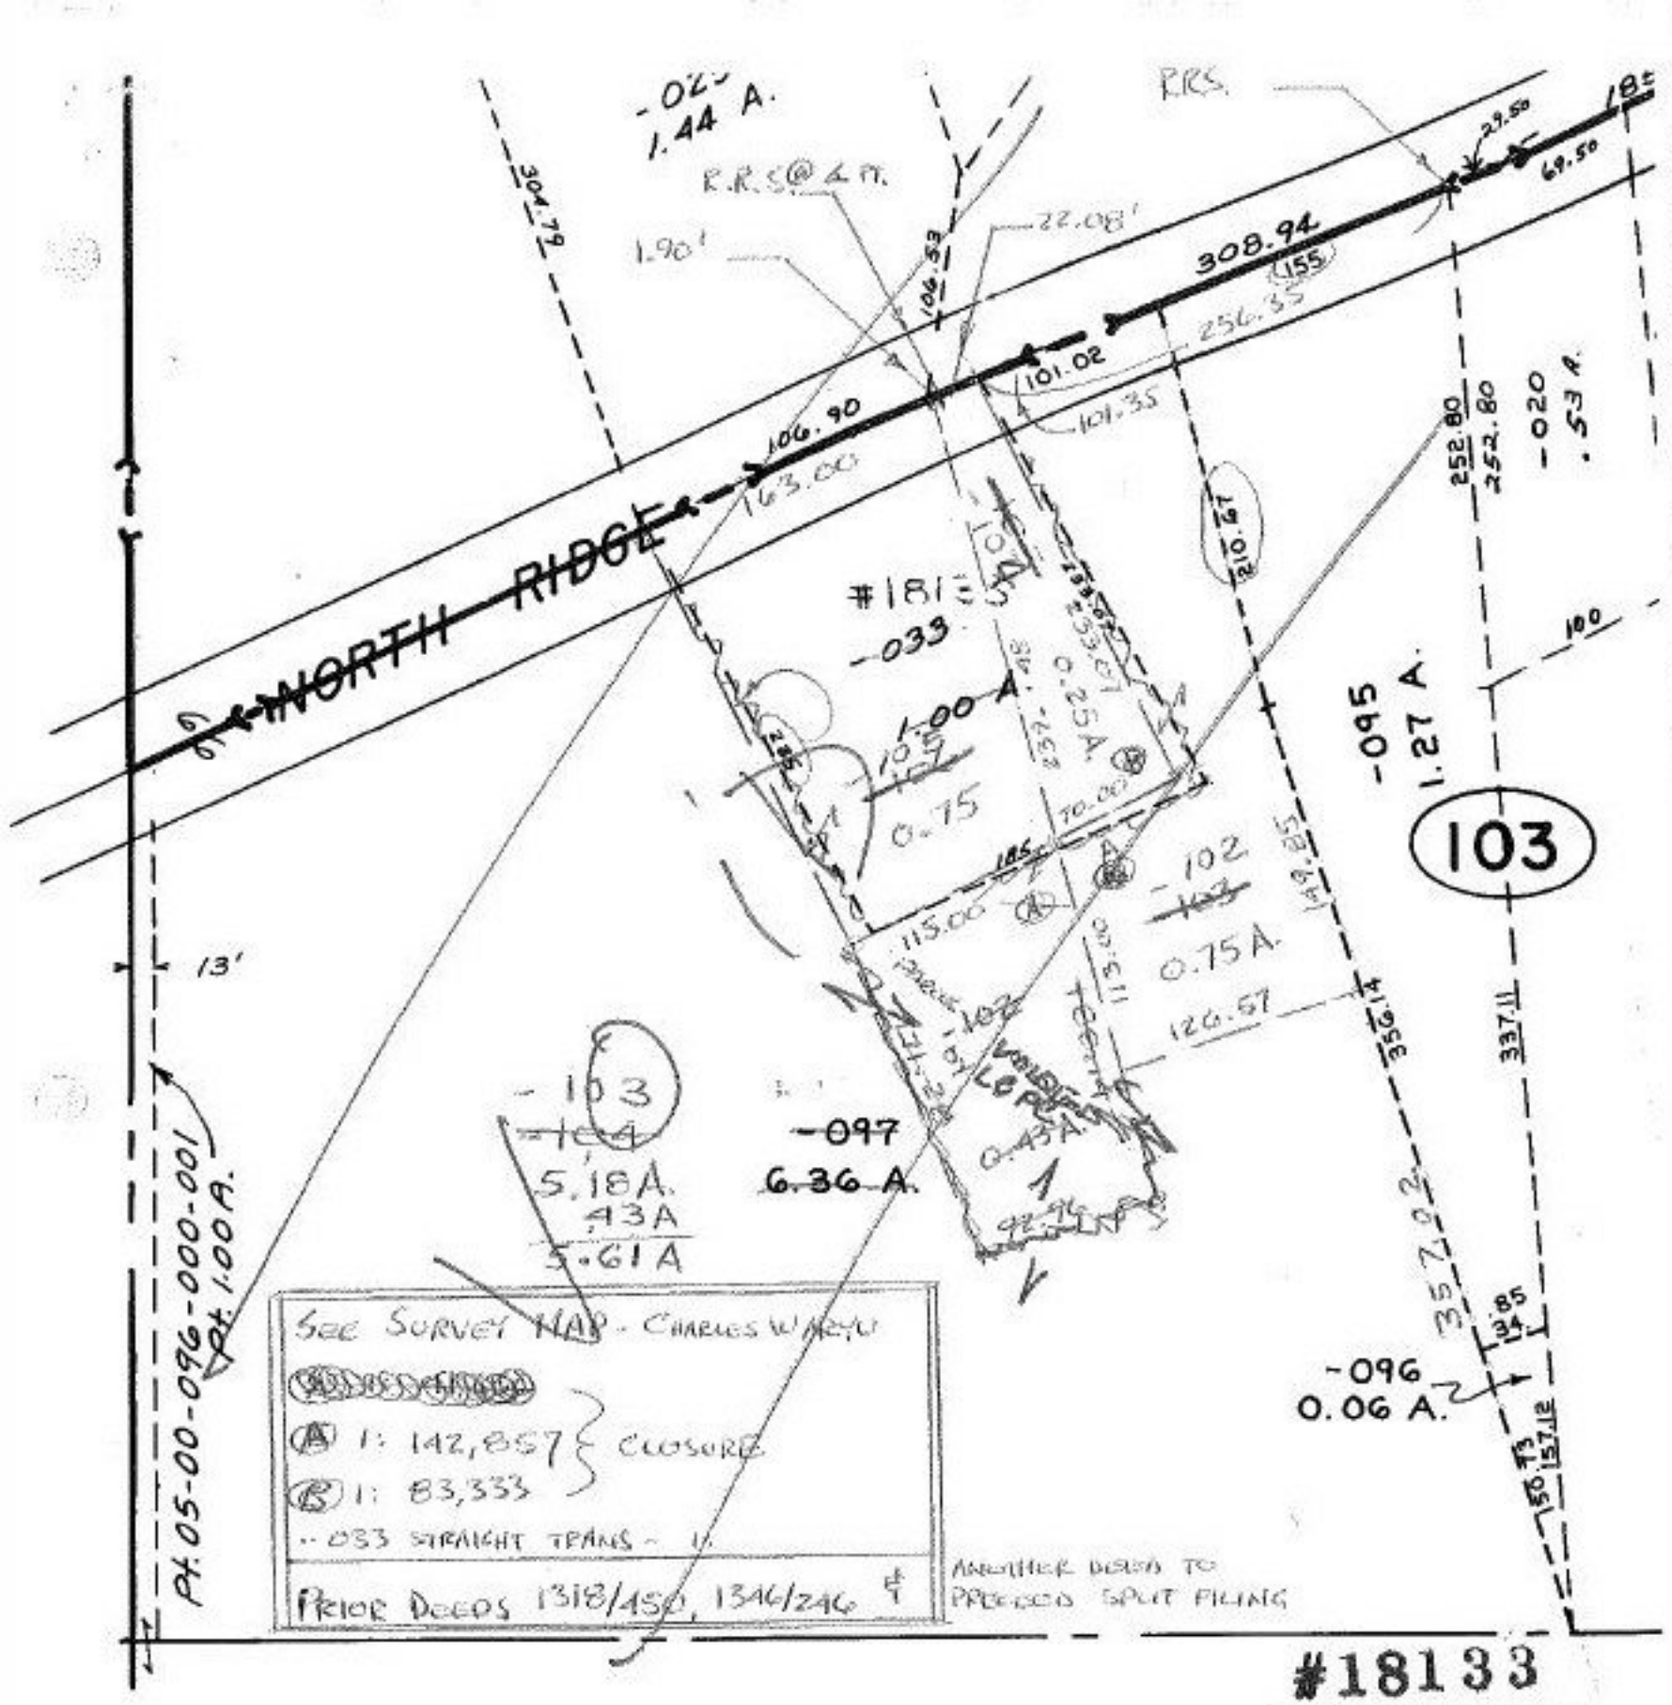

#18133

APPROVED
LORAIN CO.
MAP DEPT.

DATE 9-21-88

PAGE 5-00-077-A

BY T. McClain

VOID AFTER 18133