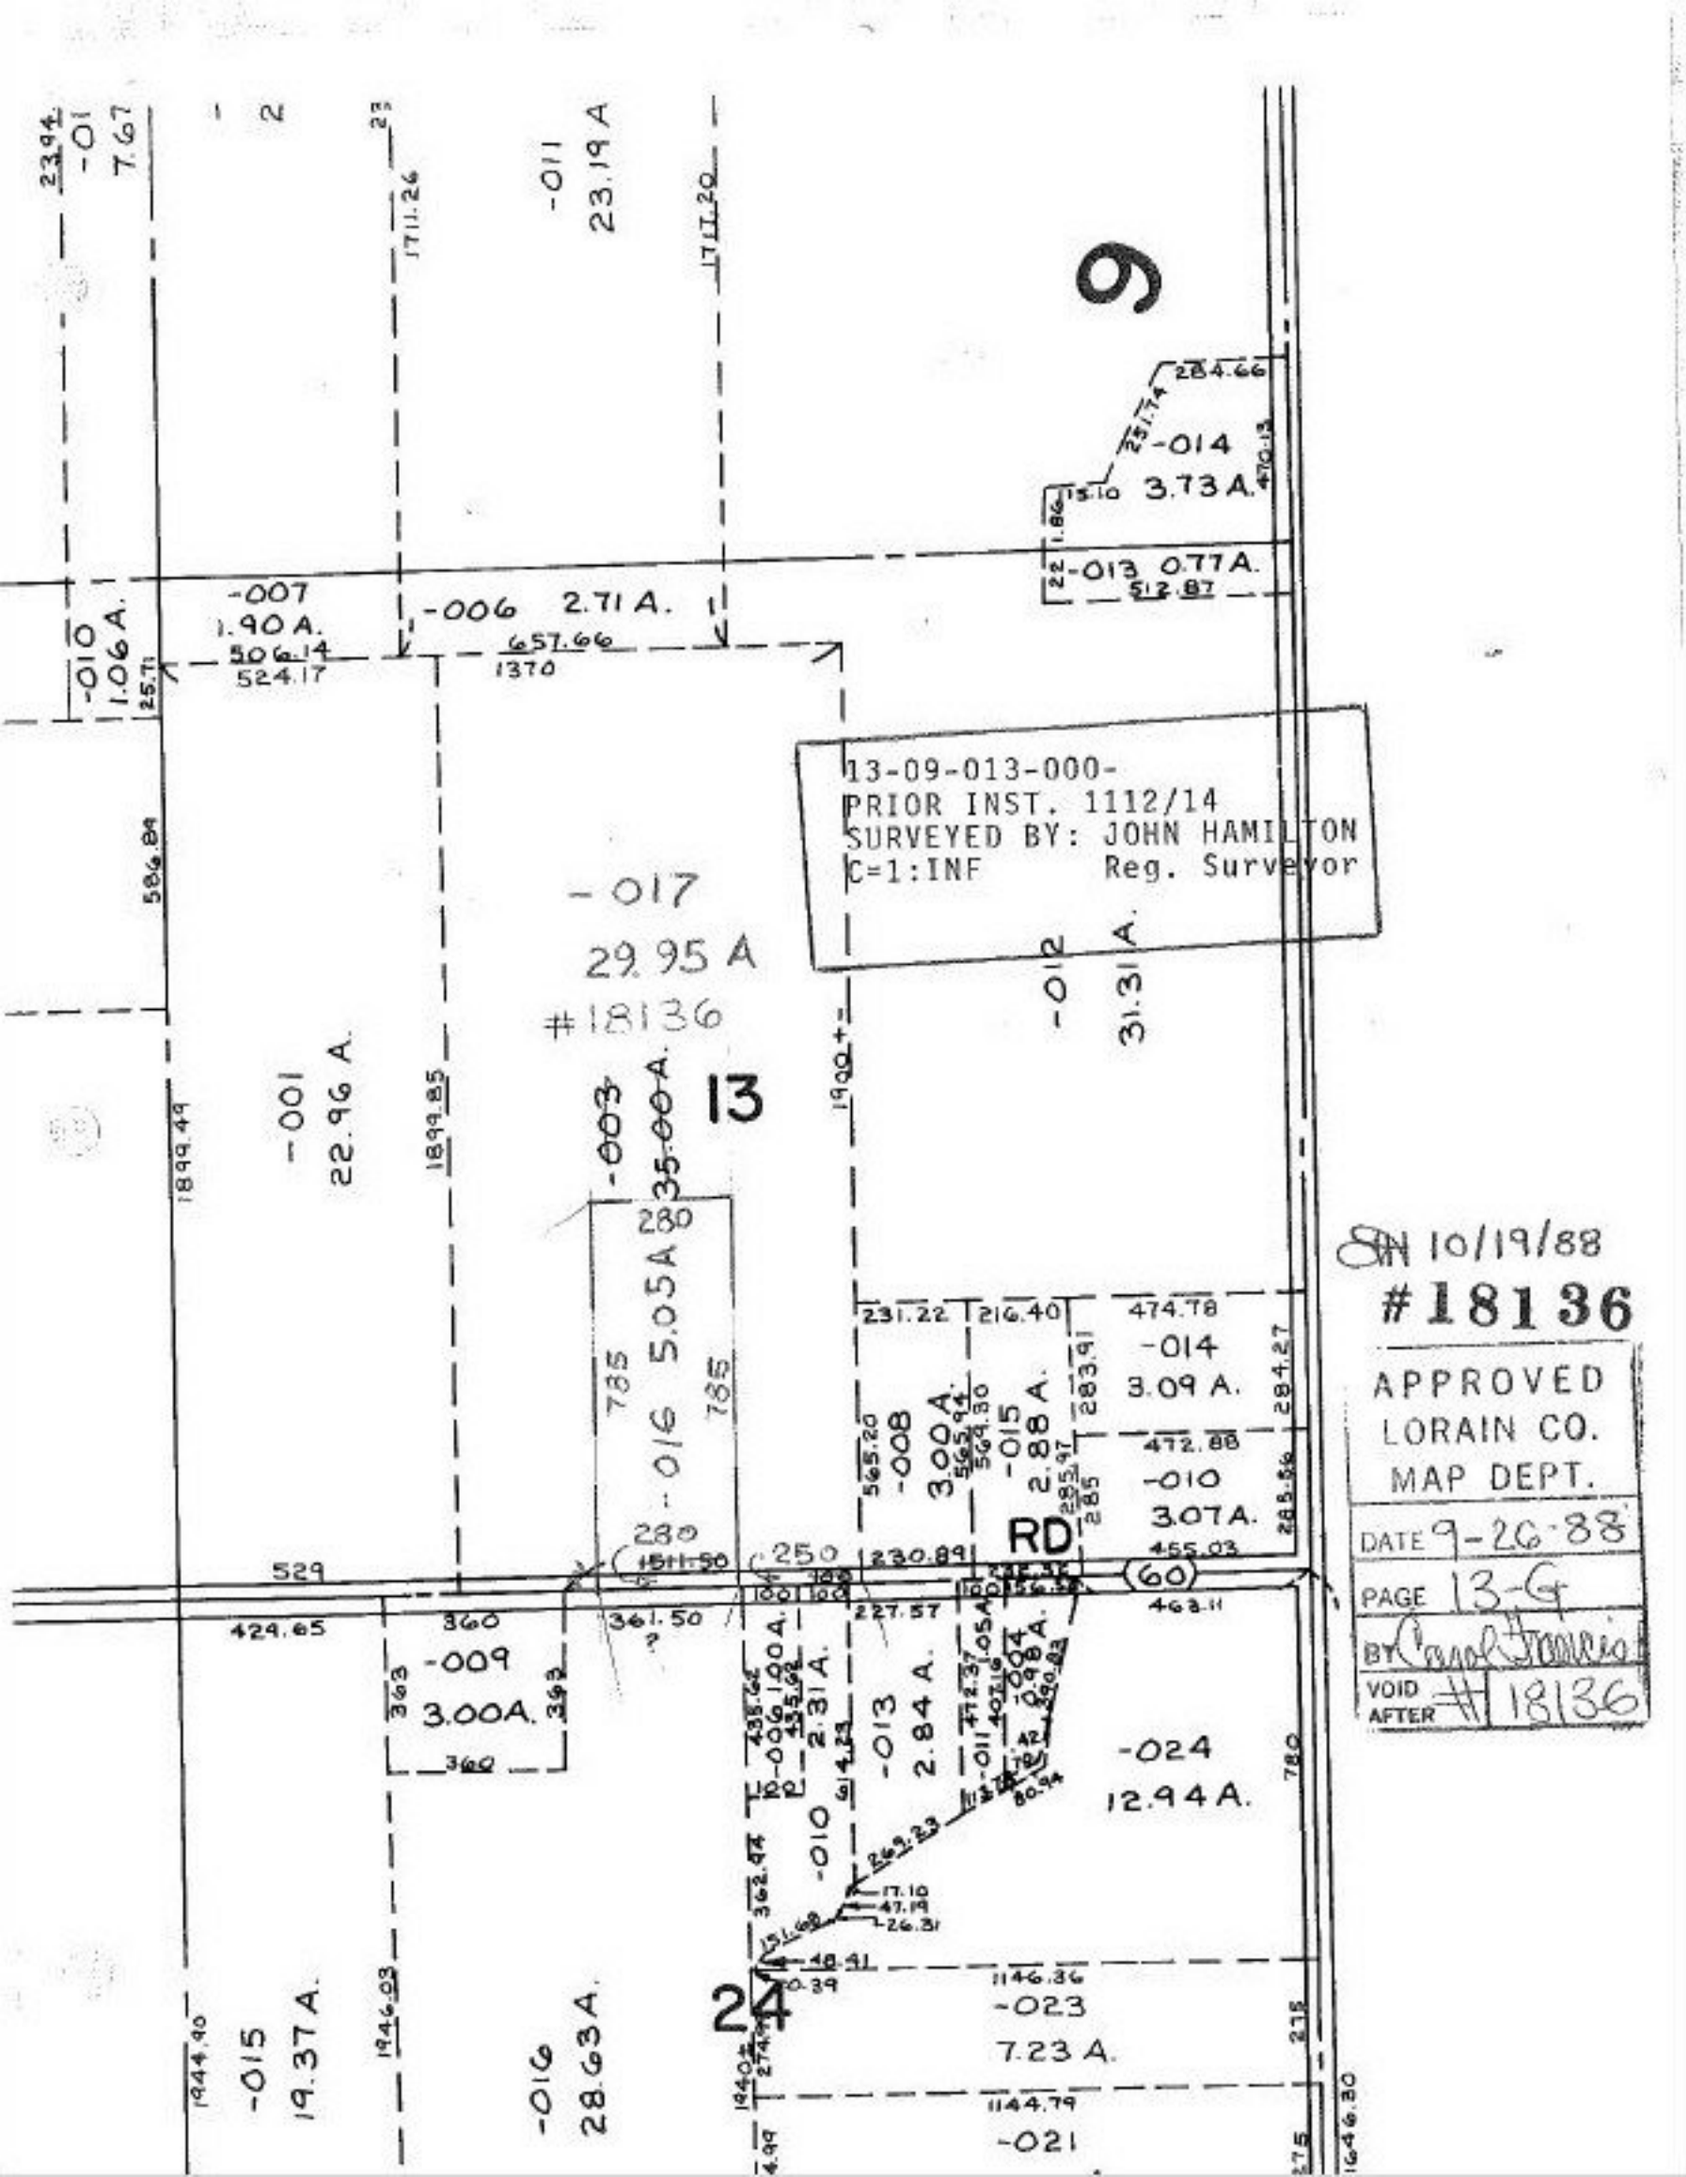
9
13
24
RD
13-09-013-000-
PRIOR INST. 1112/14
SURVEYED BY: JOHN HAMILTON
C=1:INF Reg. Surveyor
-017
29.95 A
#18136
-016 5.05A
-003 35.00A
-001
22.96 A
-007
1.90 A.
-006 2.71 A.
-010
1.06 A.
-011
23.19 A
-014
3.73 A.
-013 0.77A.
-012
31.31 A.
-014
3.09 A.
-010
3.07A.
-008
3.00 A.
-015
2.88 A.
-009
3.00A.
-006 1.00 A.
2.31 A.
-013
2.84 A.
-010
-024
12.94 A.
-023
7.23 A.
-021
-015
19.37 A.
-016
28.63 A.
SN 10/19/88
#18136
APPROVED
LORAIN CO.
MAP DEPT.
DATE 9-26-88
PAGE 13-G
BY Carol Francis
VOID AFTER # 18136