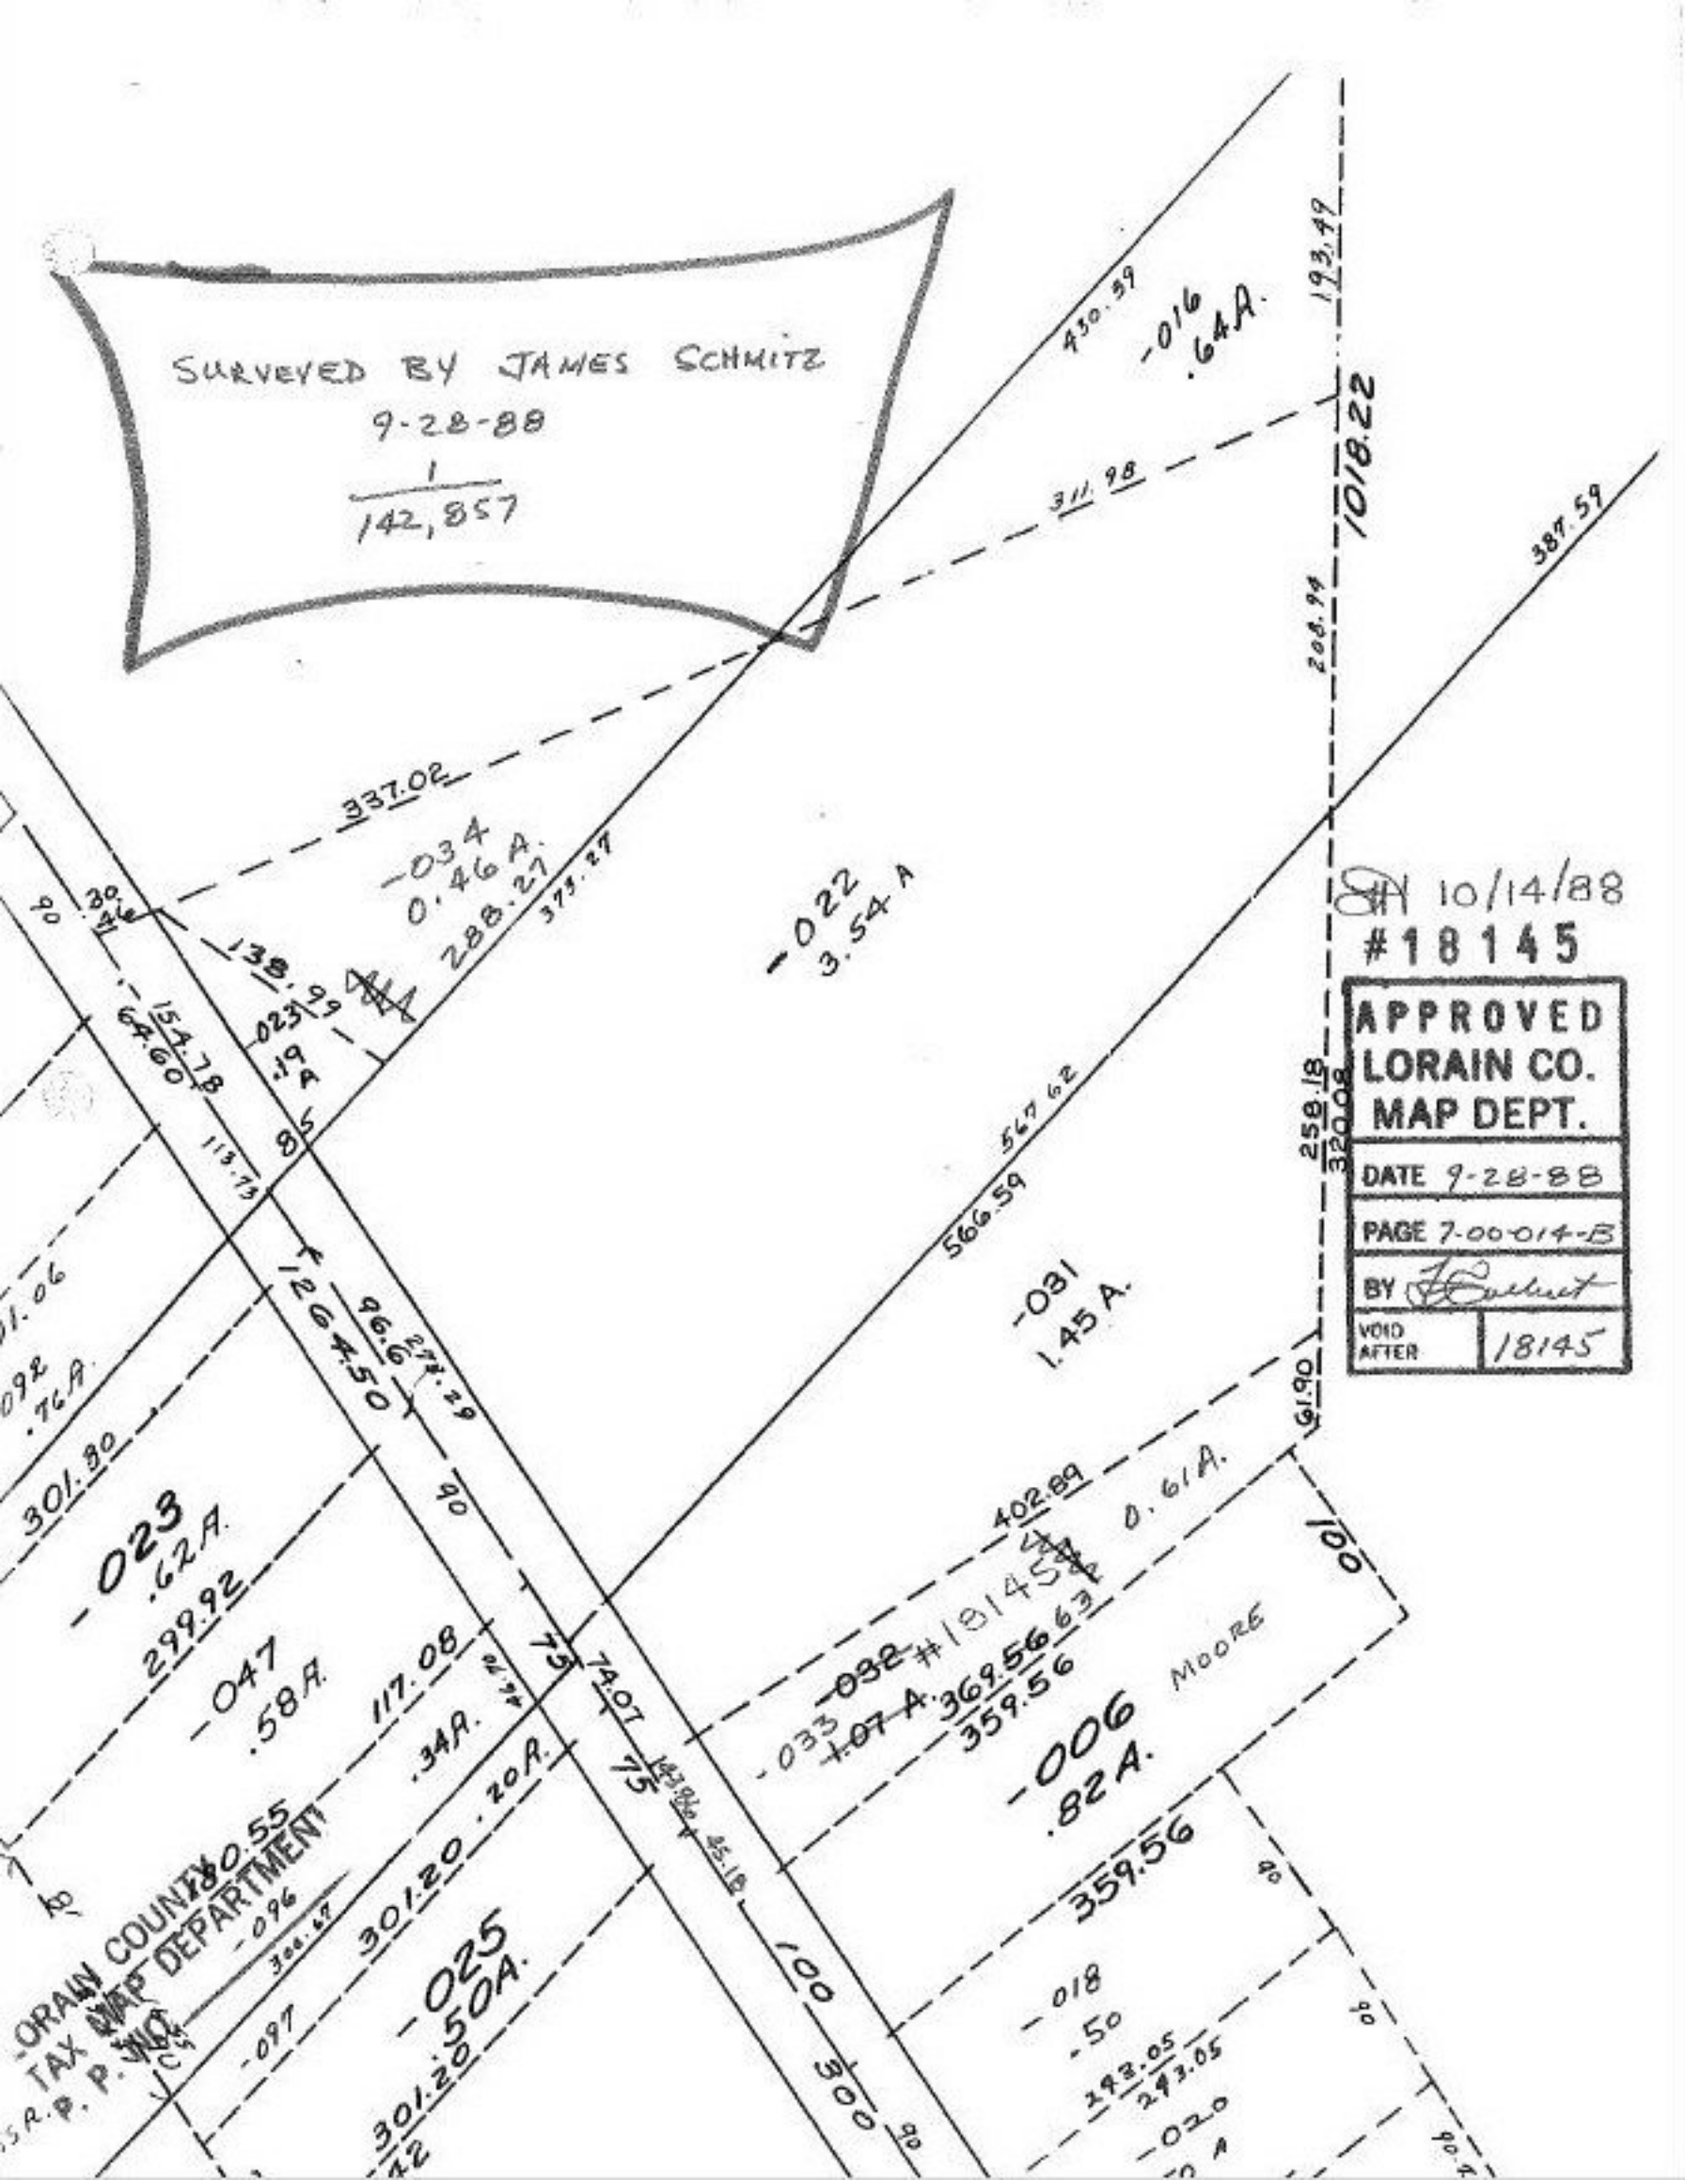
SURVEYED BY JAMES SCHMITZ
9-28-88
1
142,857
-016
.64A.
430.59
193.49
1018.22
311.98
387.59
208.94
-034
0.46A.
288.21
337.02
-022
3.54A
-023
.19A
154.78
64.60
113.75
-031
1.45A.
567.62
566.59
259.18
320.08
61.90
10/14/88
#18145
APPROVED
LORAIN CO.
MAP DEPT.
DATE 9-28-88
PAGE 7-00-014-B
BY
VOID AFTER 18145
-023
.62A.
299.92
301.90
-047
.58A.
117.08
.34A.
-025
.50A.
301.20
.20A.
180.55
-096
-097
300.67
-033
-032
#18145
1.07A.
369.56
359.56
0.61A.
402.89
-006
.82A.
MOORE
359.56
-018
-50
293.05
293.05
-020
.90A
LORAIN COUNTY
TAX MAP DEPARTMENT
P.P. 9/16/88