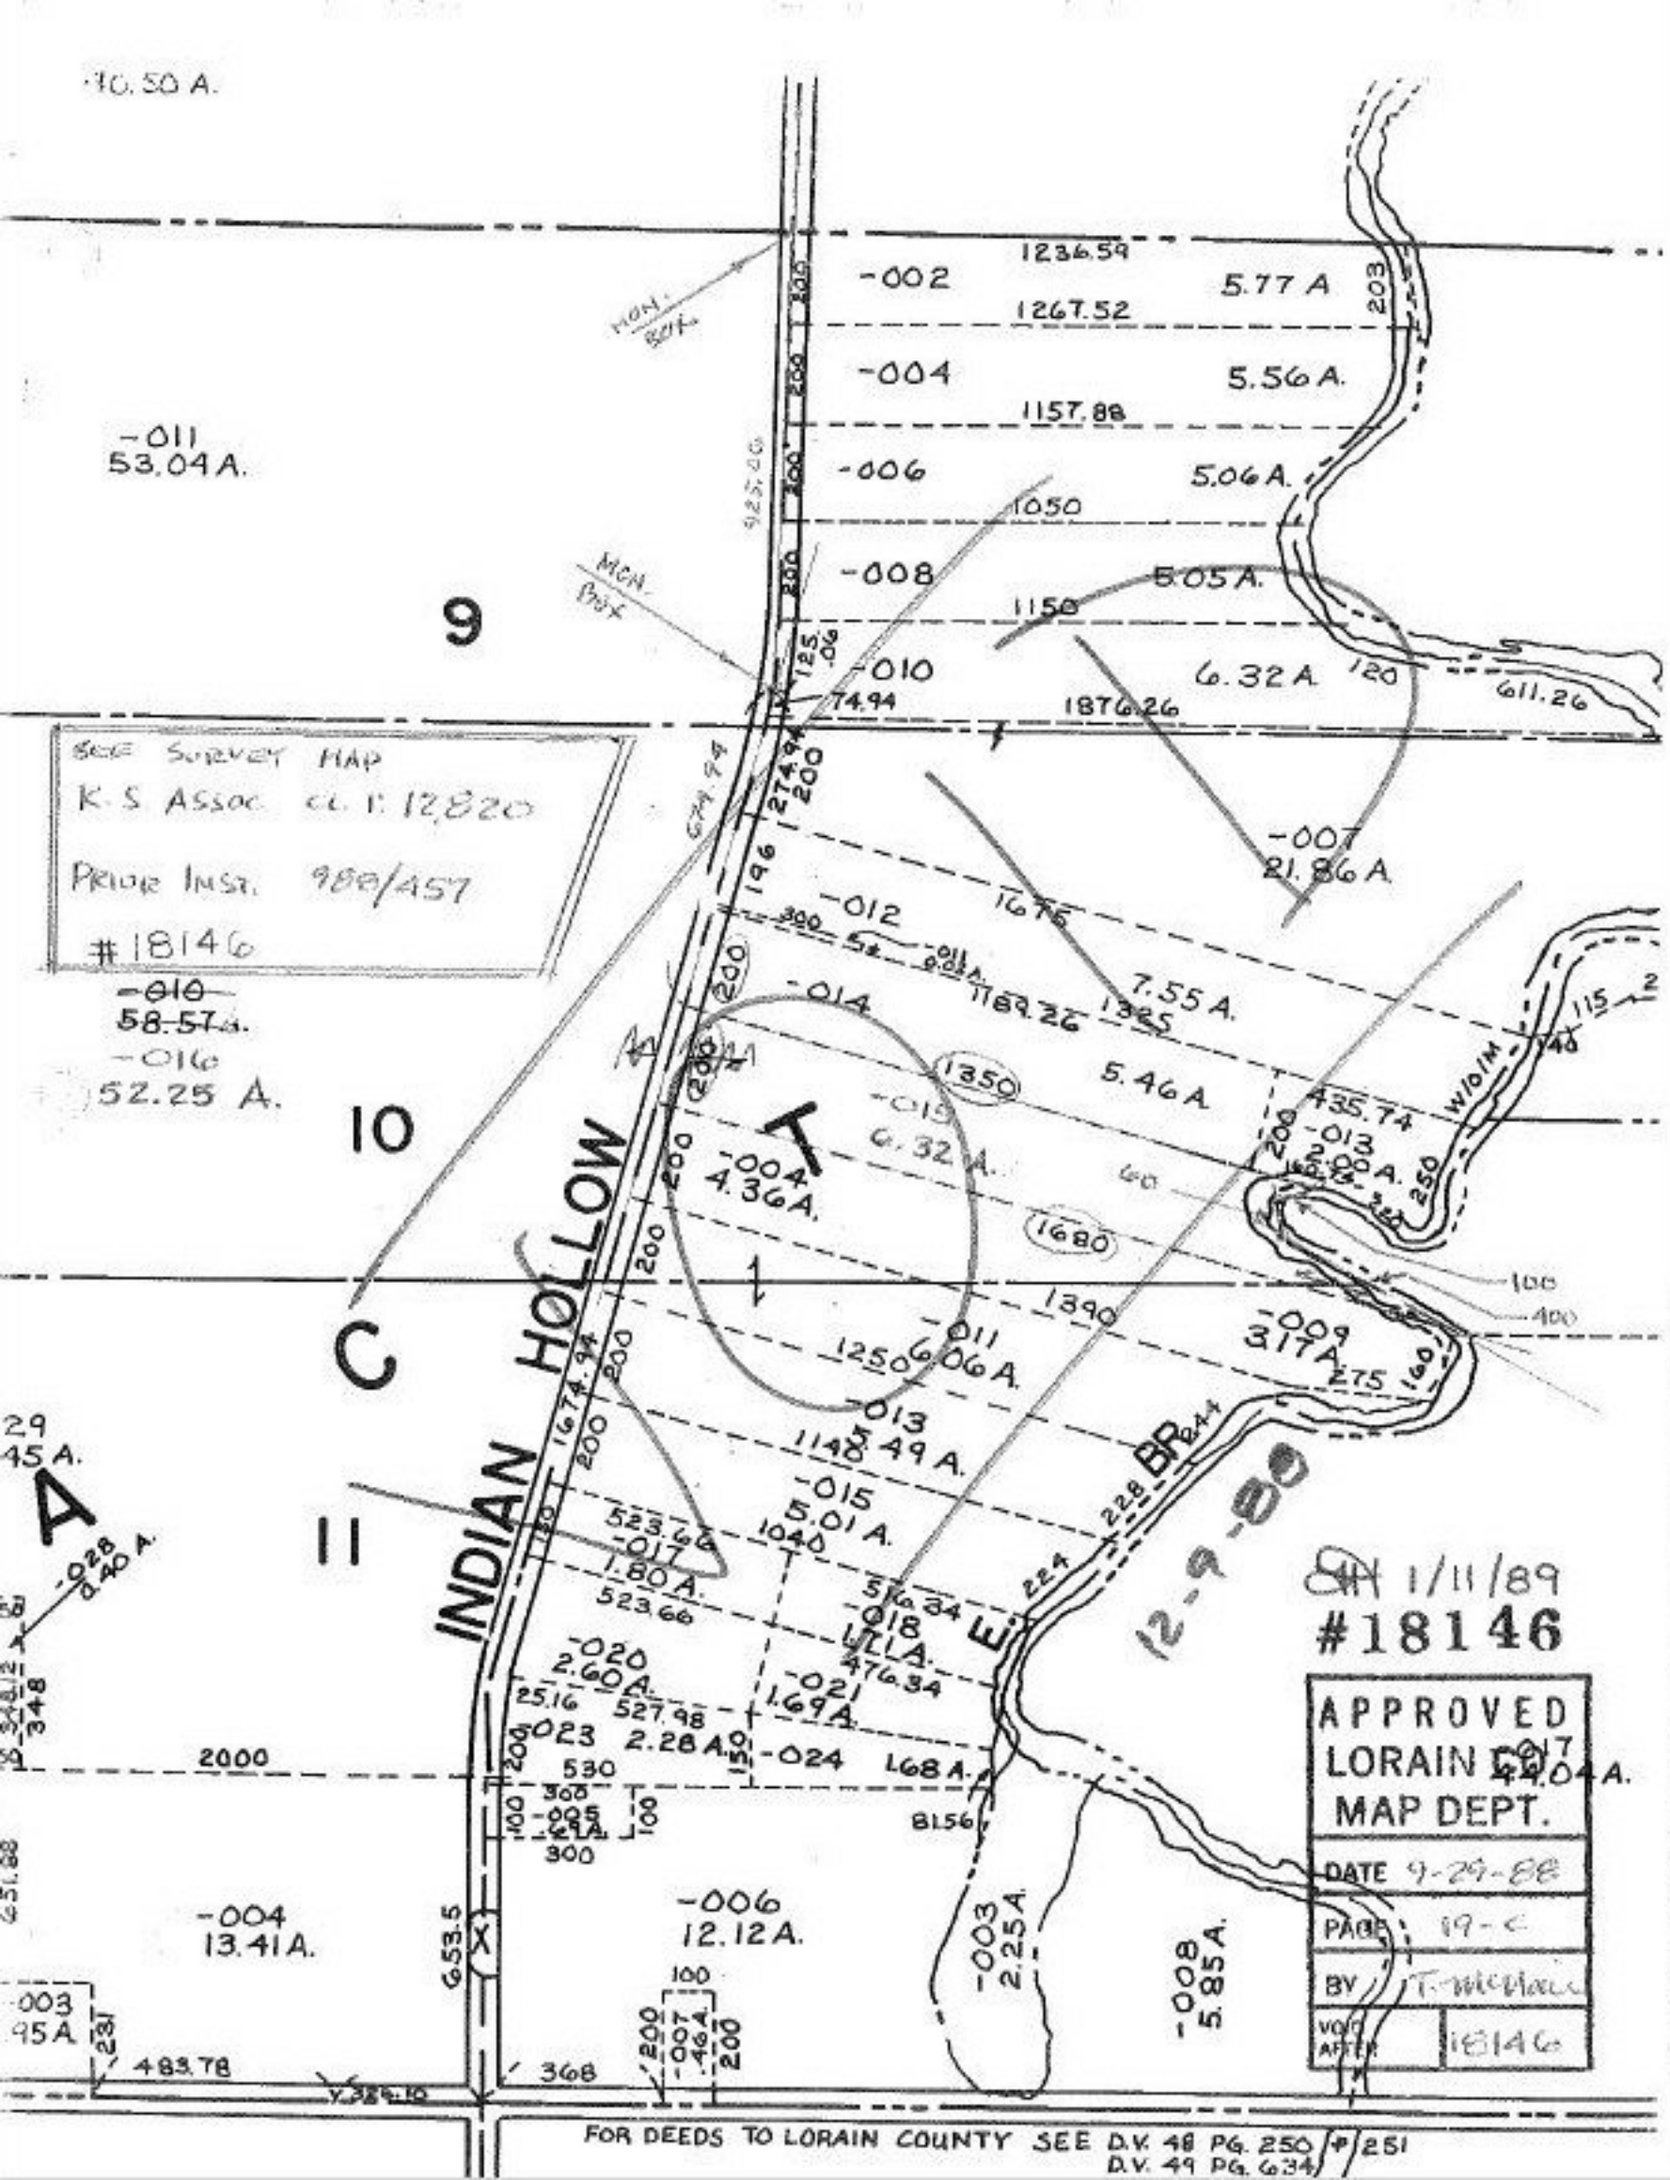
70.50 A.
-011
53.04 A.
9
10
11
INDIAN HOLLOW
-002
1236.59
5.77 A
1267.52
-004
5.56 A.
1157.88
-006
5.06 A.
1050
-008
5.05 A.
1150
-010
6.32 A.
1876.26
-007
21.86 A.
-012
7.55 A.
1189.26
-014
5.46 A.
-015
6.32 A.
-004
4.36 A.
-011
6.06 A.
-013
5.49 A.
-015
5.01 A.
-017
1.80 A.
-018
4.76 A.
-021
1.69 A.
-020
2.60 A.
-023
2.28 A.
-024
1.68 A.
-005
2.14 A.
-009
3.17 A.
-013
2.00 A.
-028
0.40 A.
-004
13.41 A.
-006
12.12 A.
-003
2.25 A.
-008
5.85 A.
-003
95 A.
29
45 A.
SEE SURVEY MAP
K.S ASSOC. CL. I: 12,820
PRIOR INST. 988/457
#18146
-010
58.57 A.
-016
52.25 A.
1/11/89
#18146
APPROVED
LORAIN CO.
MAP DEPT.
DATE 9-29-88
PAGE 19-C
BY T. Michaels
VOL AFTER 18146
FOR DEEDS TO LORAIN COUNTY SEE D.V. 48 PG. 250 & 251
D.V. 49 PG. 634