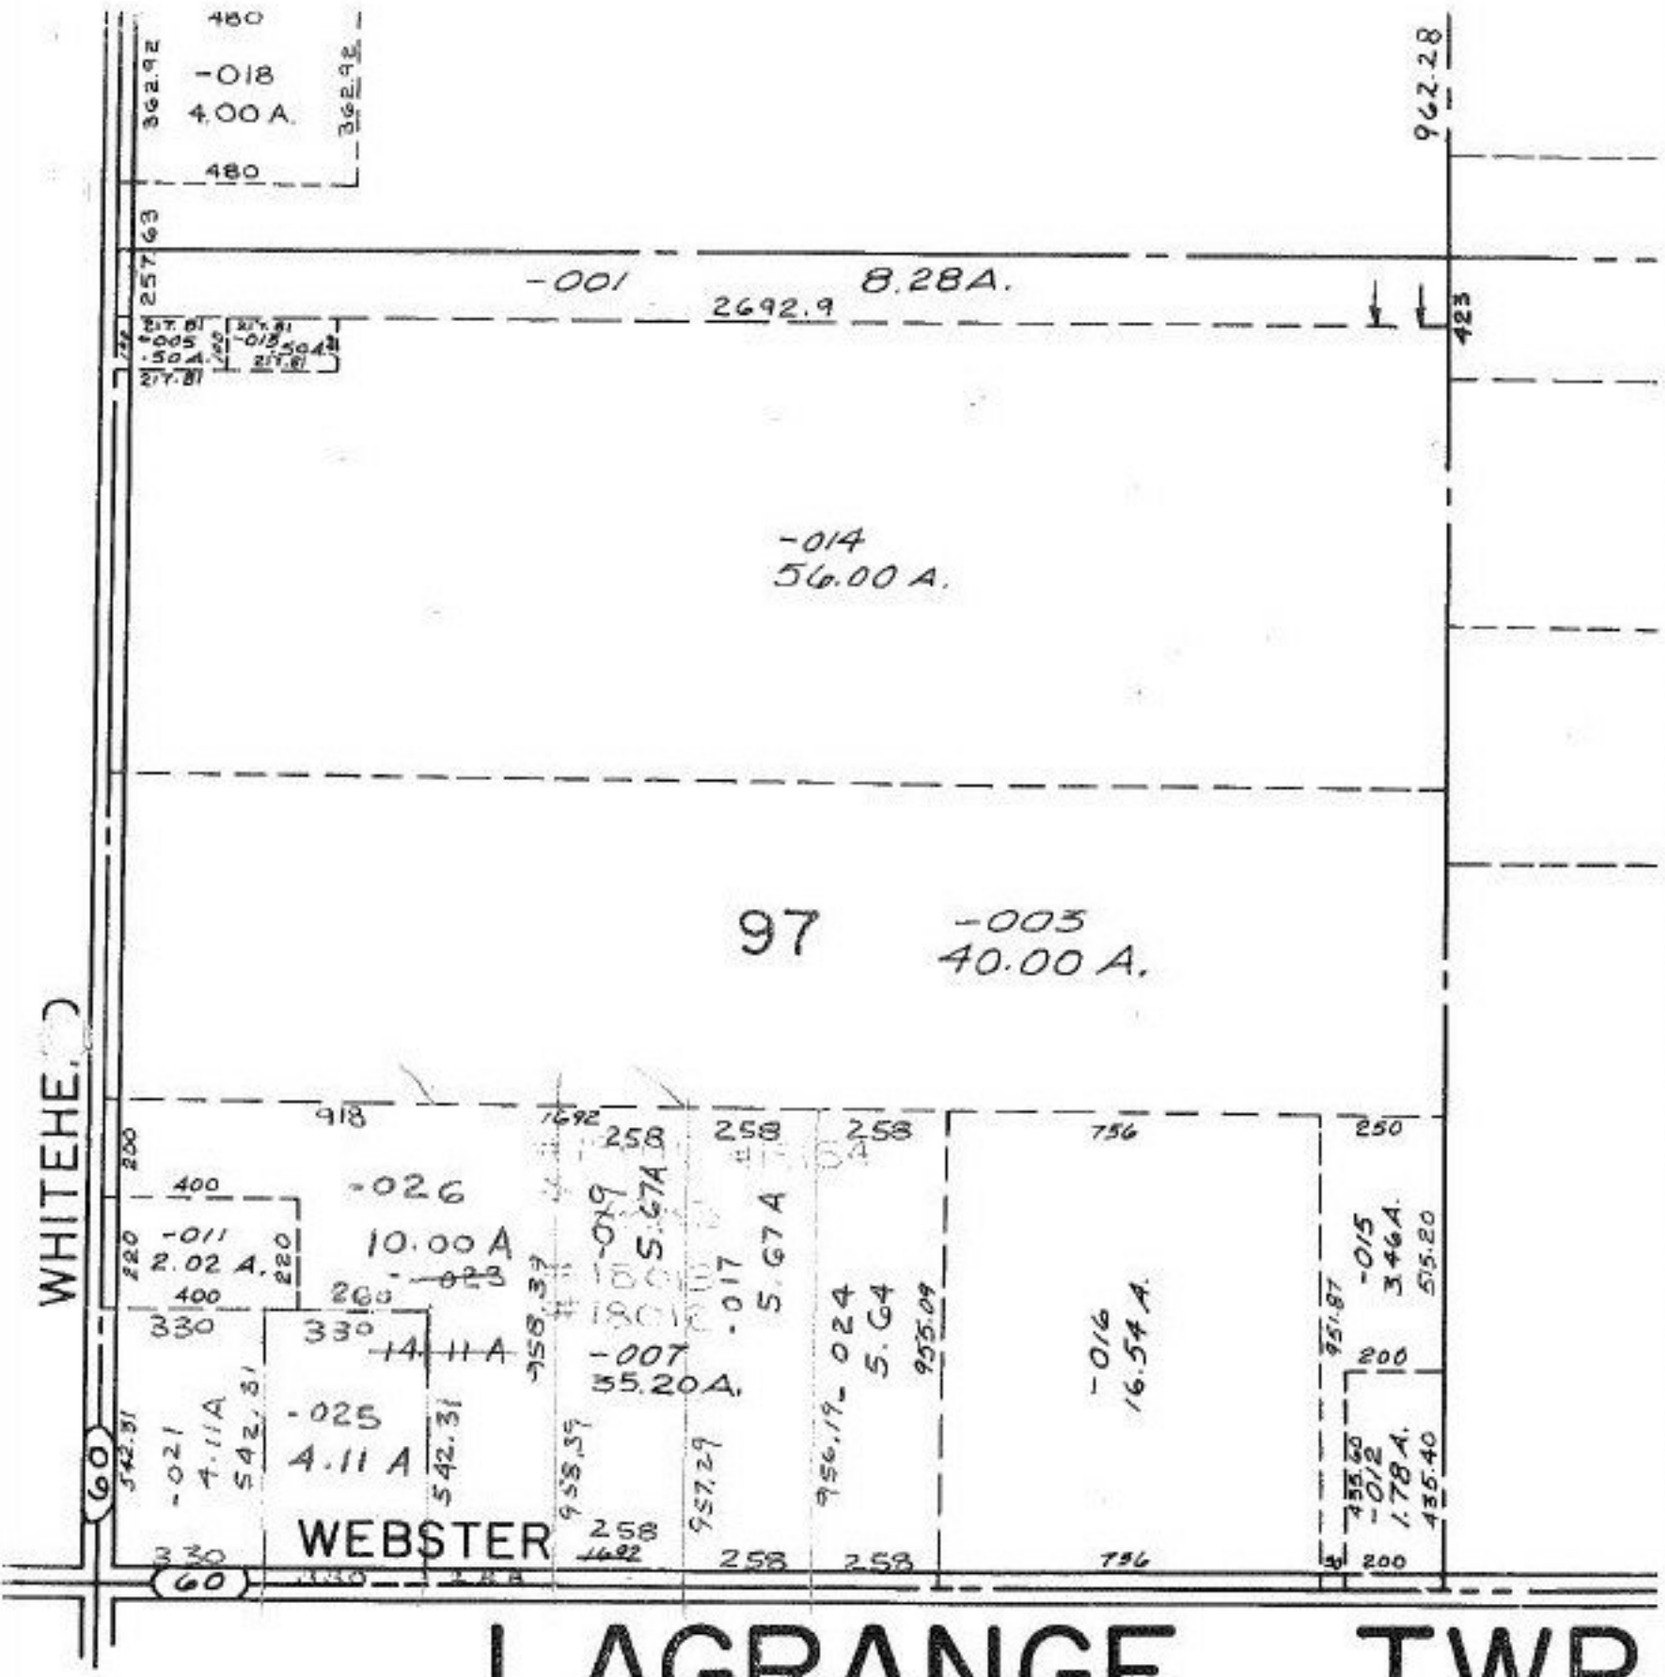

LAGRANGE TWP.

SCALE: 1" = 400'

SM 10/19/88

15-00-097-000-
PRIOR INST. O.R.V.108/564
SURVEYED BY: DOUG MOSLEY
C=1:INF Reg. Surveyor

#18154

APPROVED
LORAIN CO.
MAP DEPT.
DATE 10-3-88
PAGE 15-F
BY Carol Francis
VOID AFTER # 18154