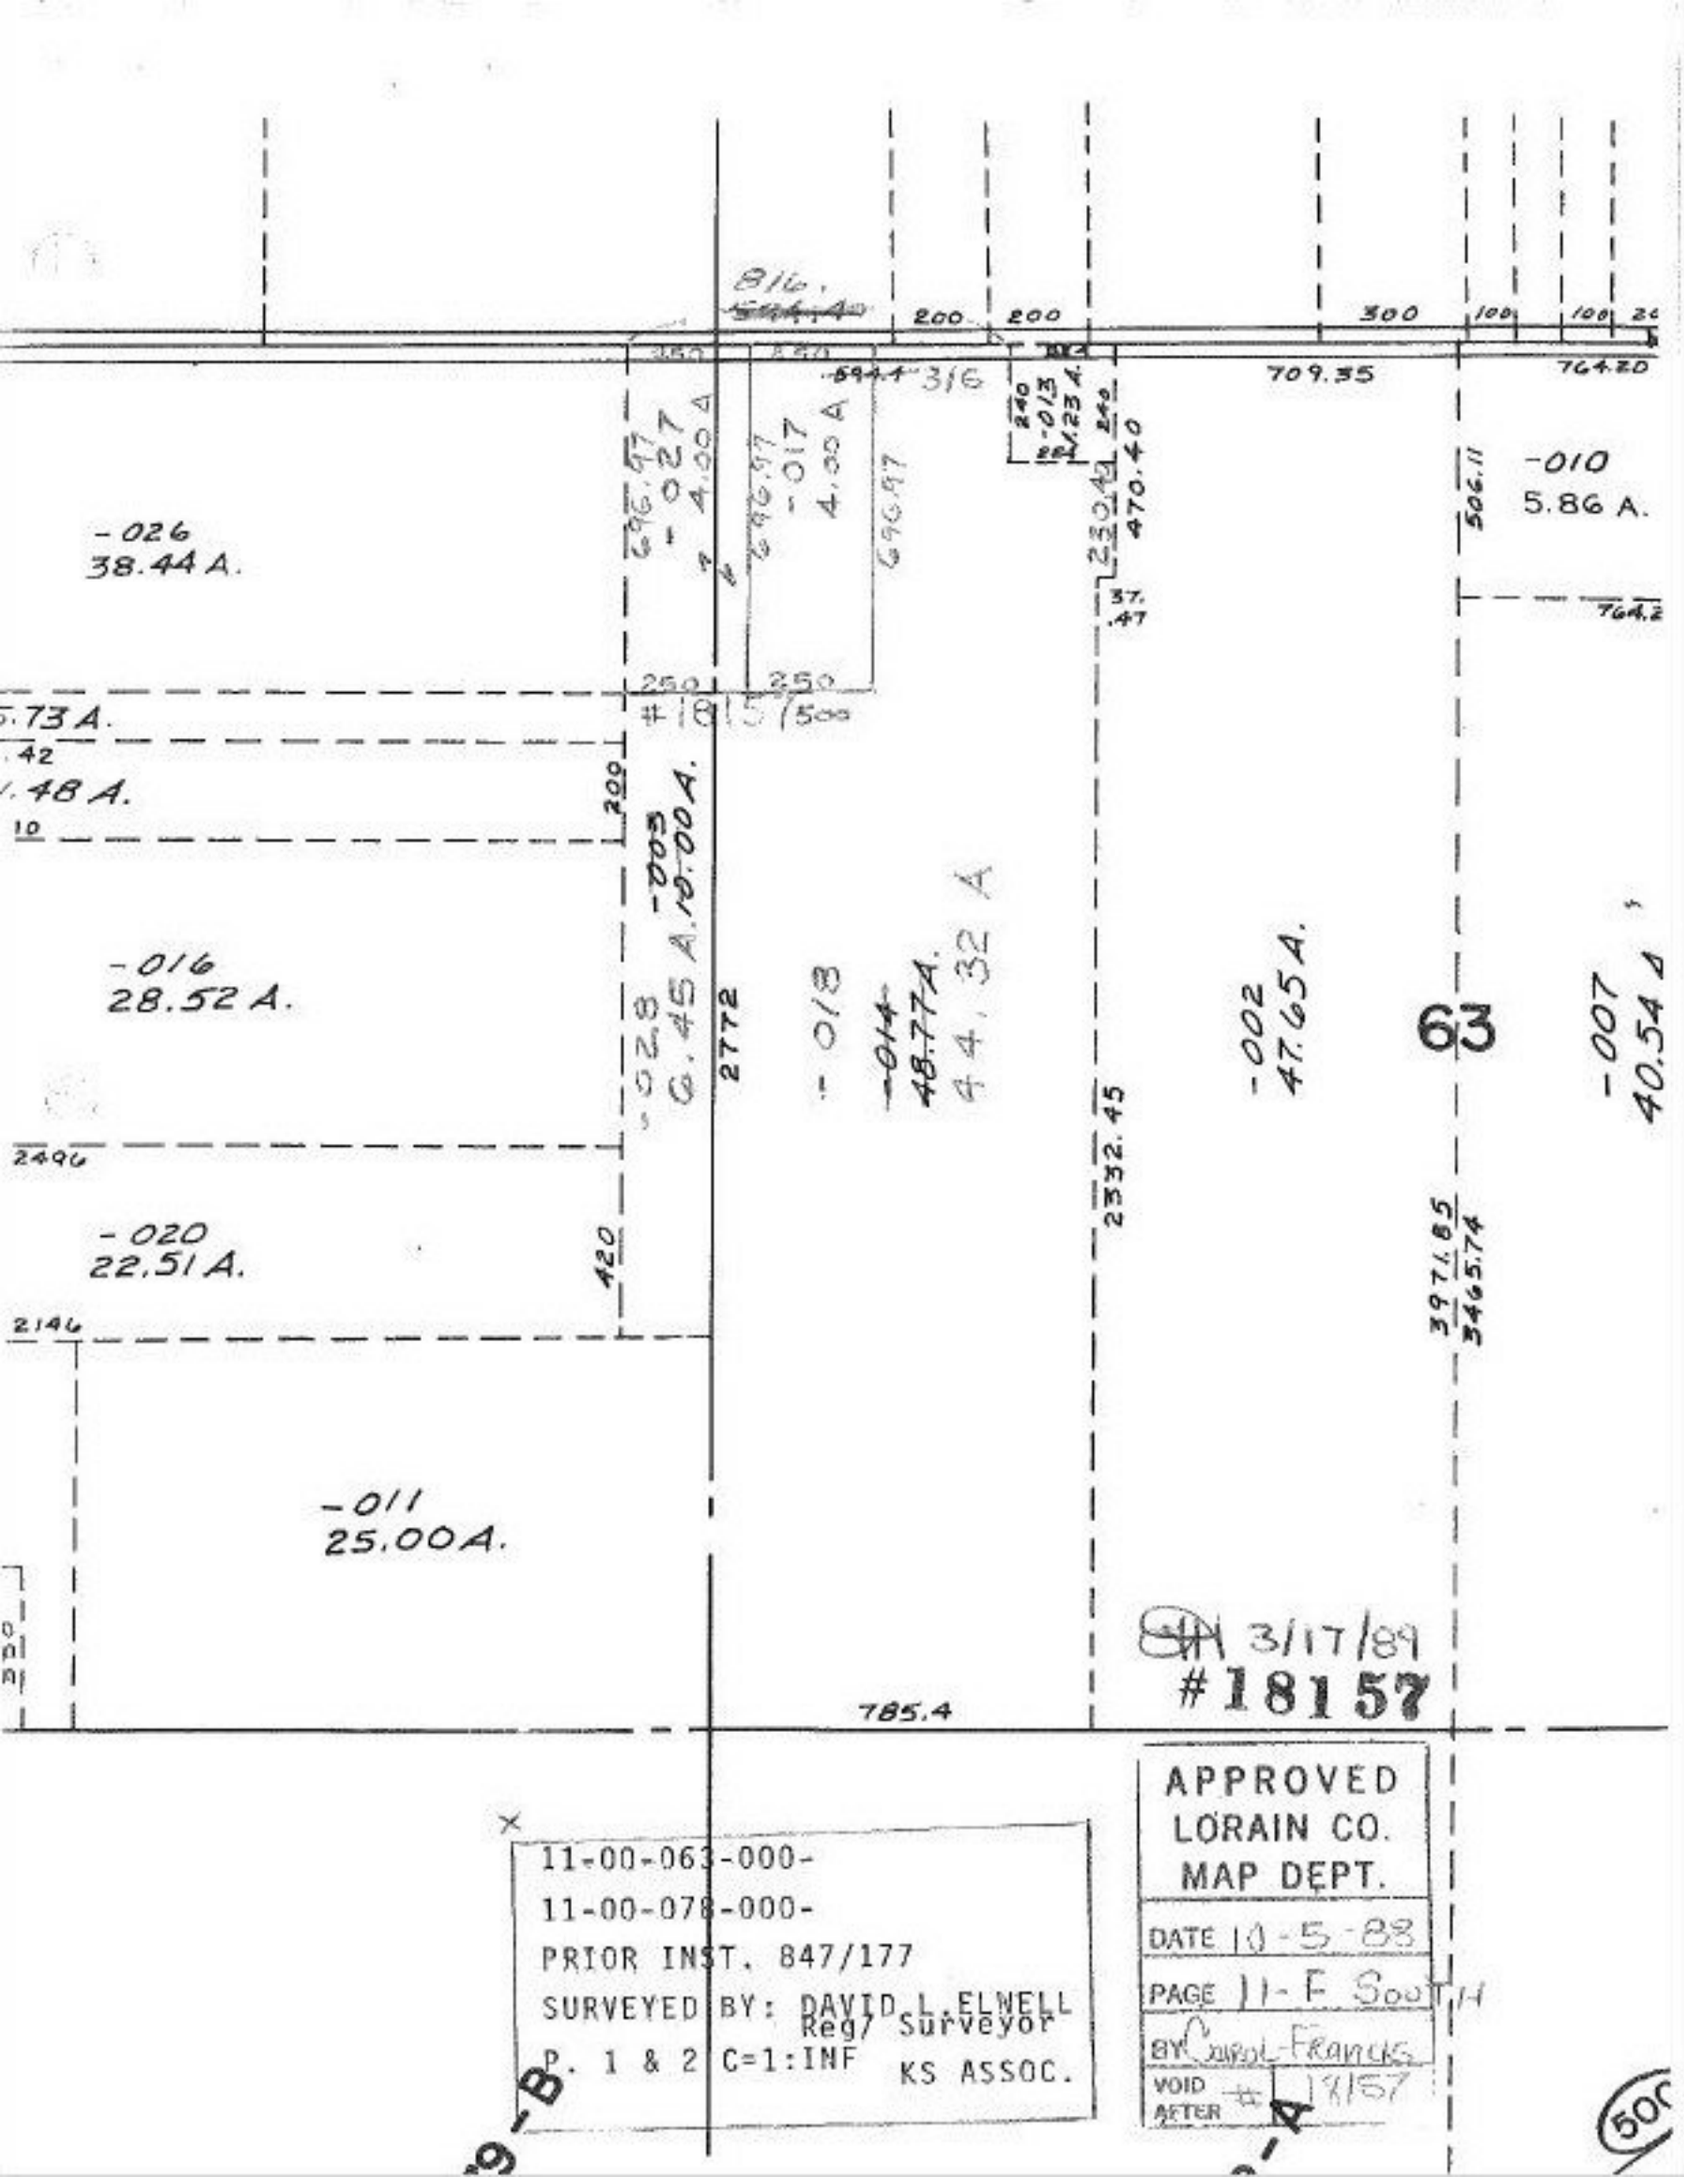
200
200
300
100
100
709.35
764.20
-026
38.44 A.
-027
4.00 A.
-017
4.00 A.
-010
5.86 A.
470.40
506.11
764.2
-028
6.45 A.
-003
10.00 A.
-016
28.52 A.
-018
44.32 A.
-014
48.77 A.
-002
47.65 A.
-007
40.54 A
2772
2332.45
-020
22.51 A.
-011
25.00 A.
785.4
3971.85
3465.74
3/17/89
#18157
11-00-063-000-
11-00-078-000-
PRIOR INST. 847/177
SURVEYED BY: DAVID L. ELNELL
Reg'l Surveyor
P. 1 & 2 C=1:INF KS ASSOC.
APPROVED
LORAIN CO.
MAP DEPT.
DATE 10-5-88
PAGE 11-F SOUTH
BY Carol Francis
VOID AFTER # 18157