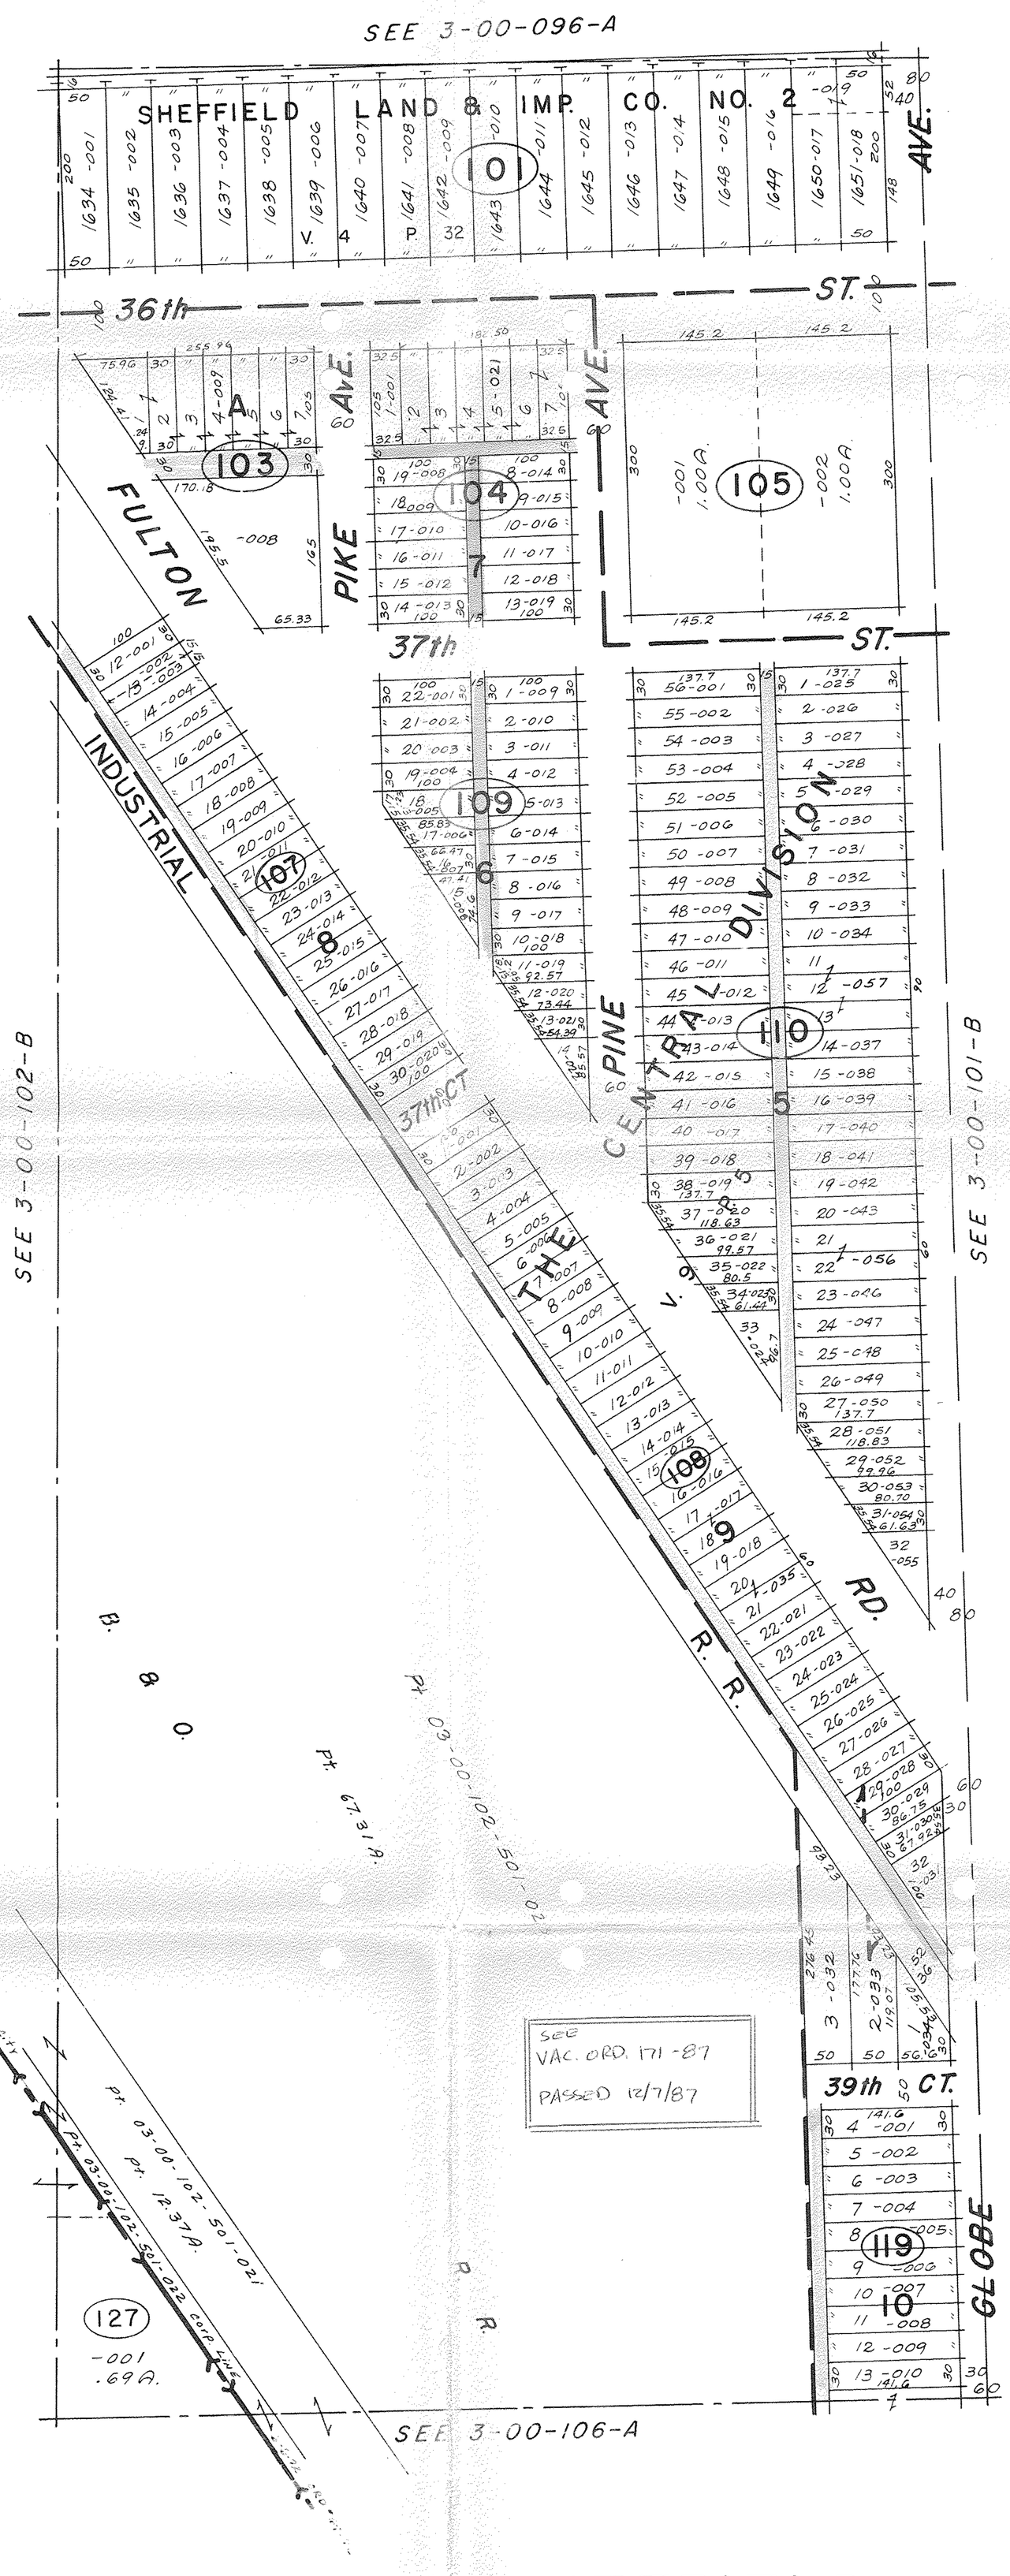

SHEFFIELD TWP.

3-00-101-A

SCALE 1" = 100'

W. PT. LOT 101

1964

3-80

10-101-A

SN 3/3/89
ALLEY VACATION
#18166-A

APPROVED
LORAIN CO.
MAP DEPT.
DATE 10-20-88
PAGE 3-00-101-A
BY T. McGain
VOID AFTER 18166A