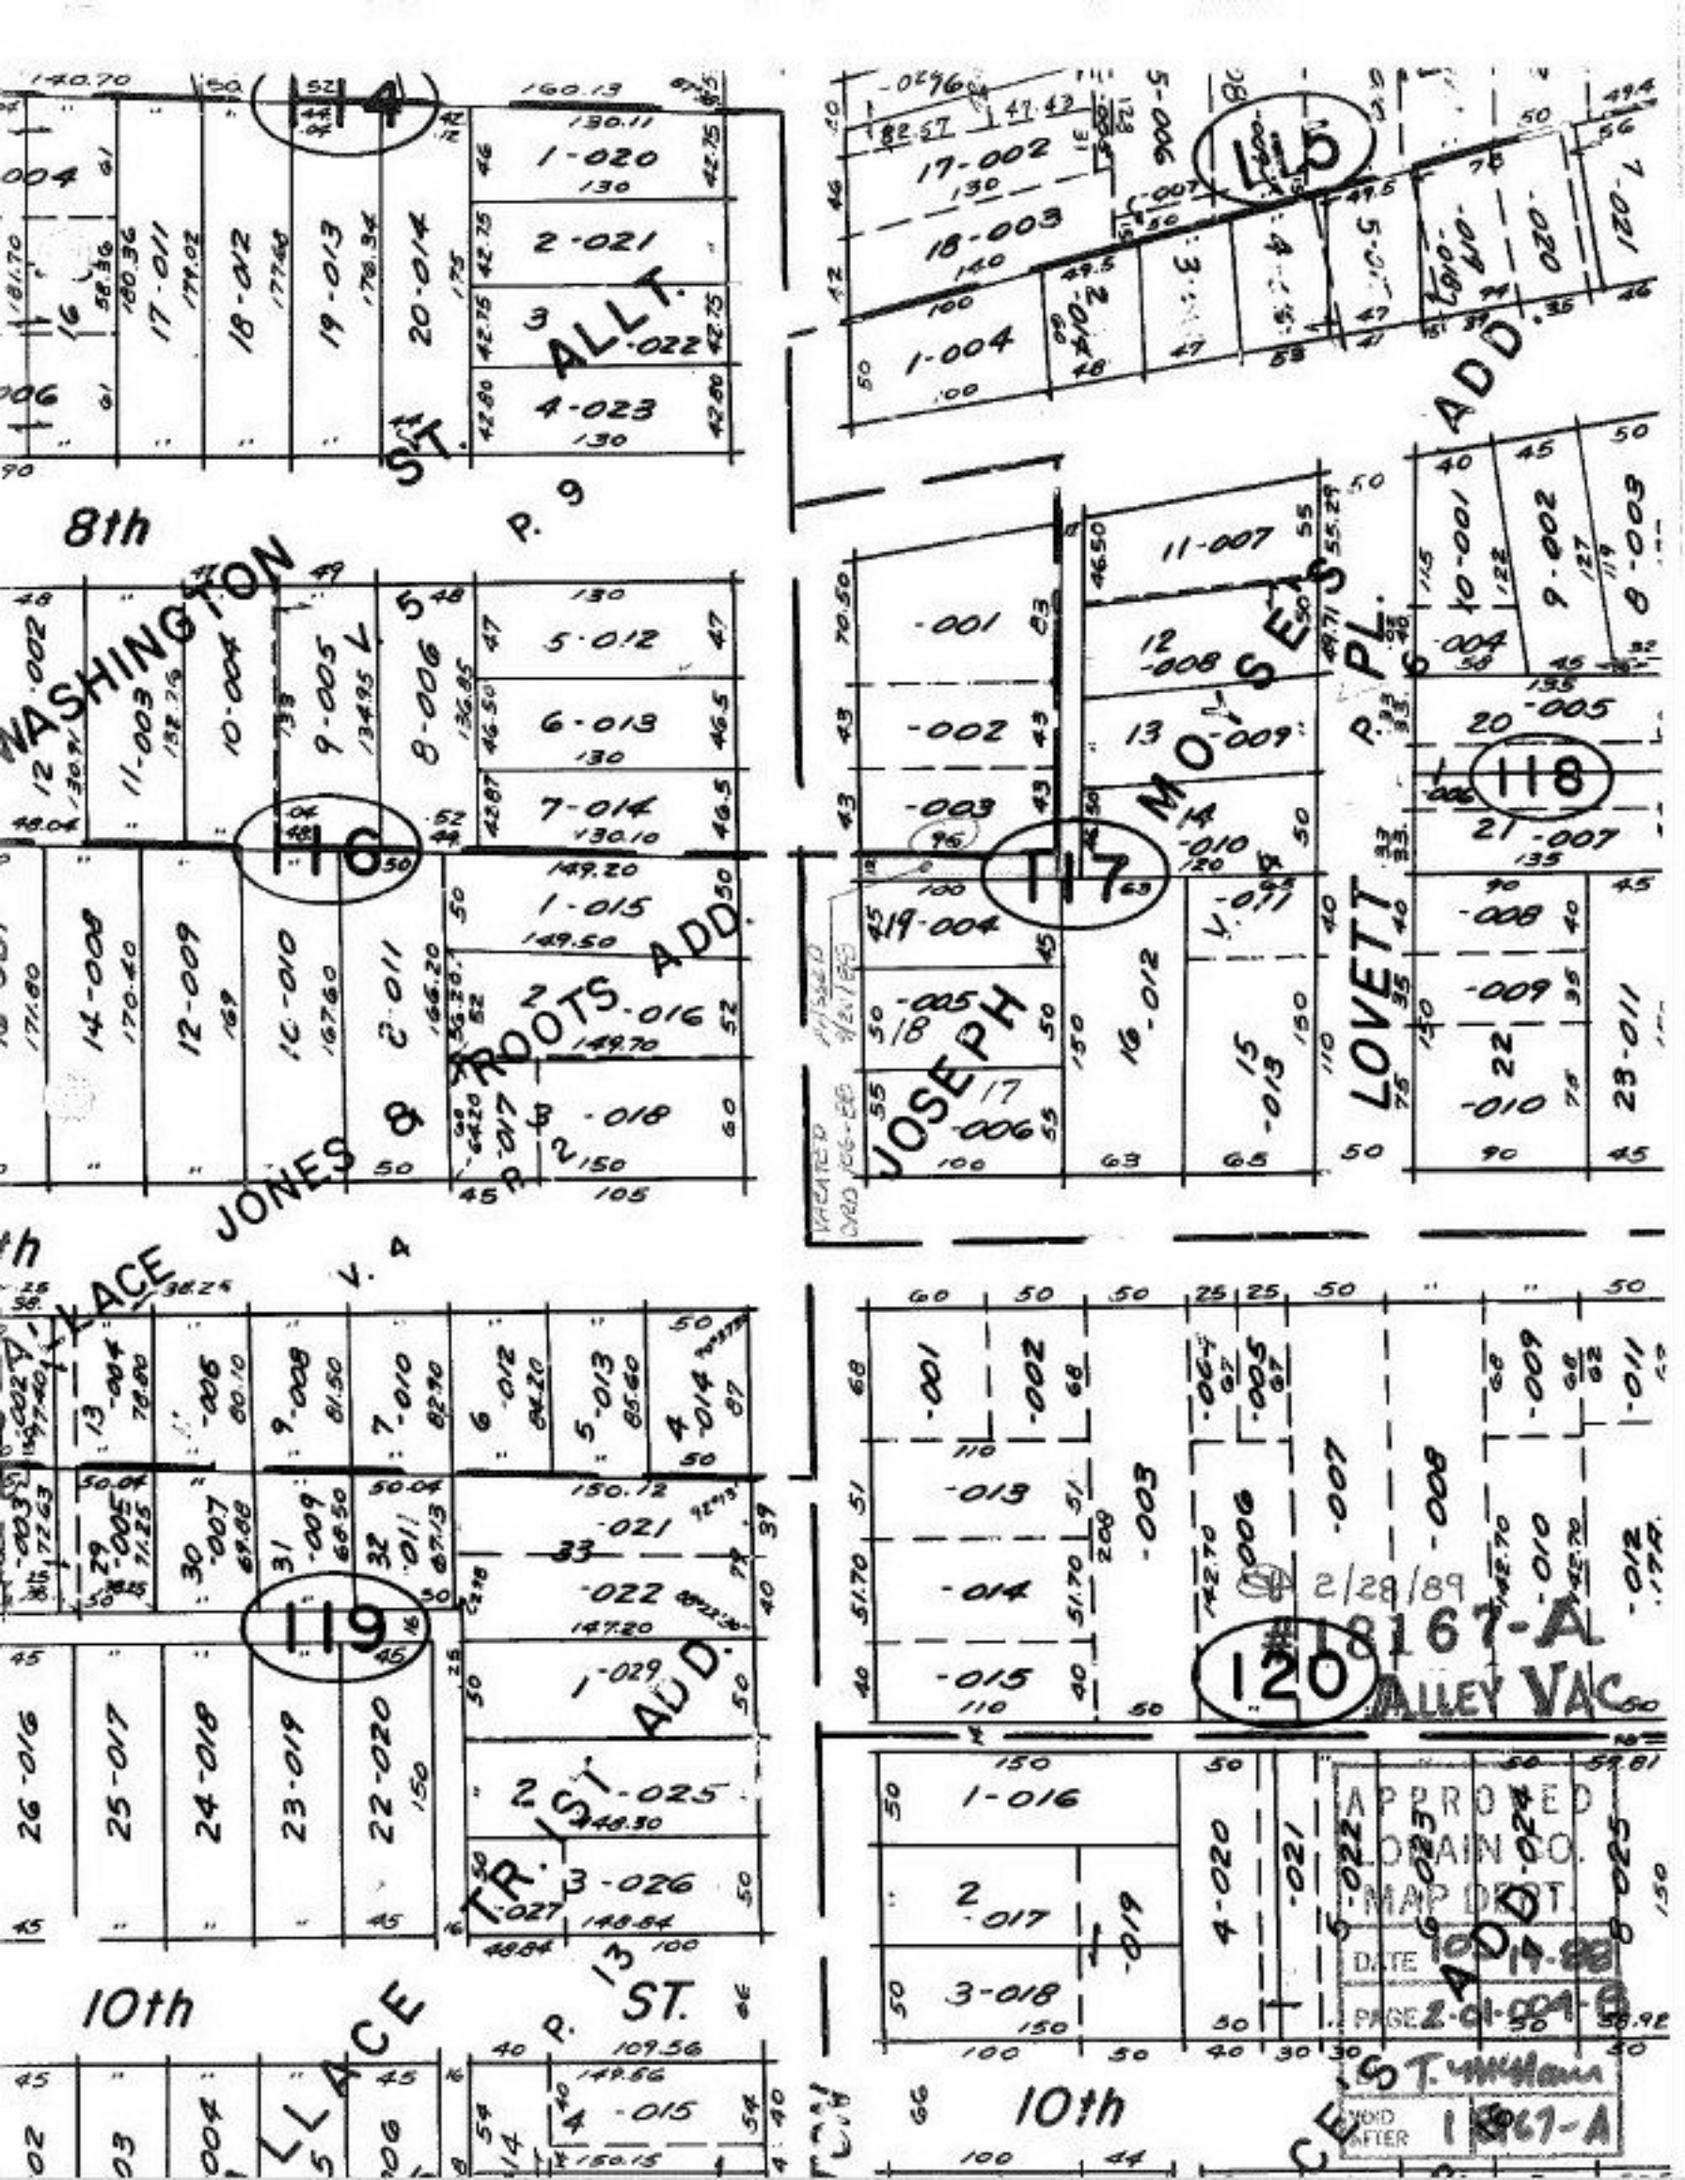

114
115
116
117
118
119
120
8th
10th
WASHINGTON ST. ALLT.
JONES & ROOTS ADD.
JOSEPH MOISES PL.
LOVETT ADD.
TR. 1ST ADD.
ALLACE
ST.
P. 9
P. 13
2/28/89
#18167-A
ALLEY VAC
APPROVED
LORAIN CO.
MAP DEPT.
DATE 10-19-88
PAGE 2-01-004-B
VOID AFTER 18167-A