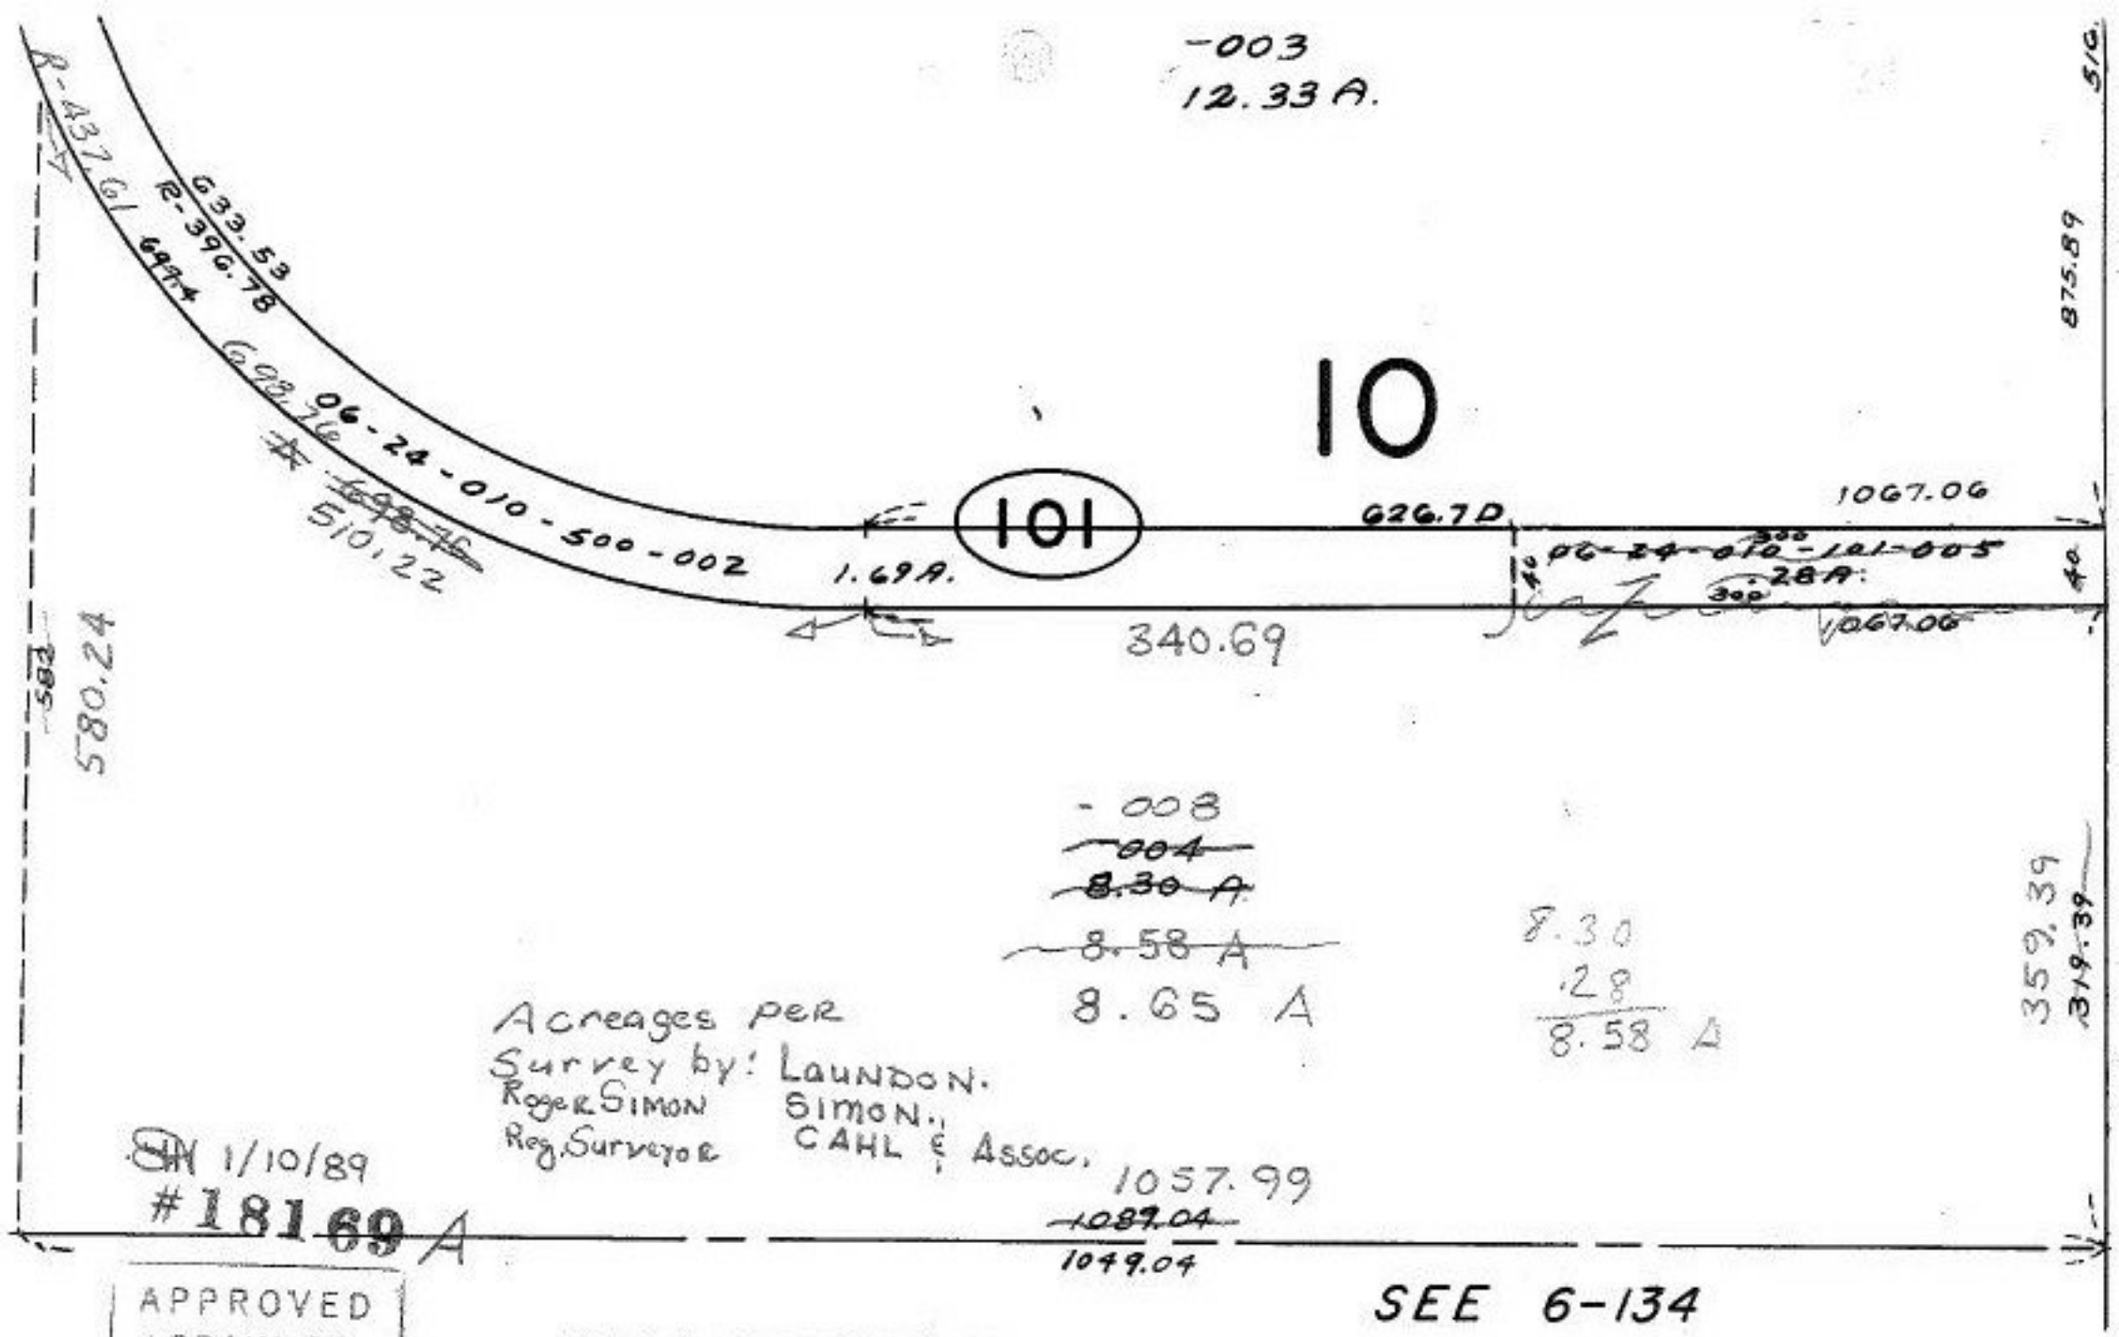

1/10/89
#18169 A

APPROVED
LORAIN CO.
MAP DEPT.
DATE 10-20-88
PAGE 6-116
BY Carol Francis
VOID AFTER # 18169A

COMBINATION
&
Acreage Corr.
06-24-010-101-