


MILAN


500  
-004  
10A

SEE 5-00-017-A

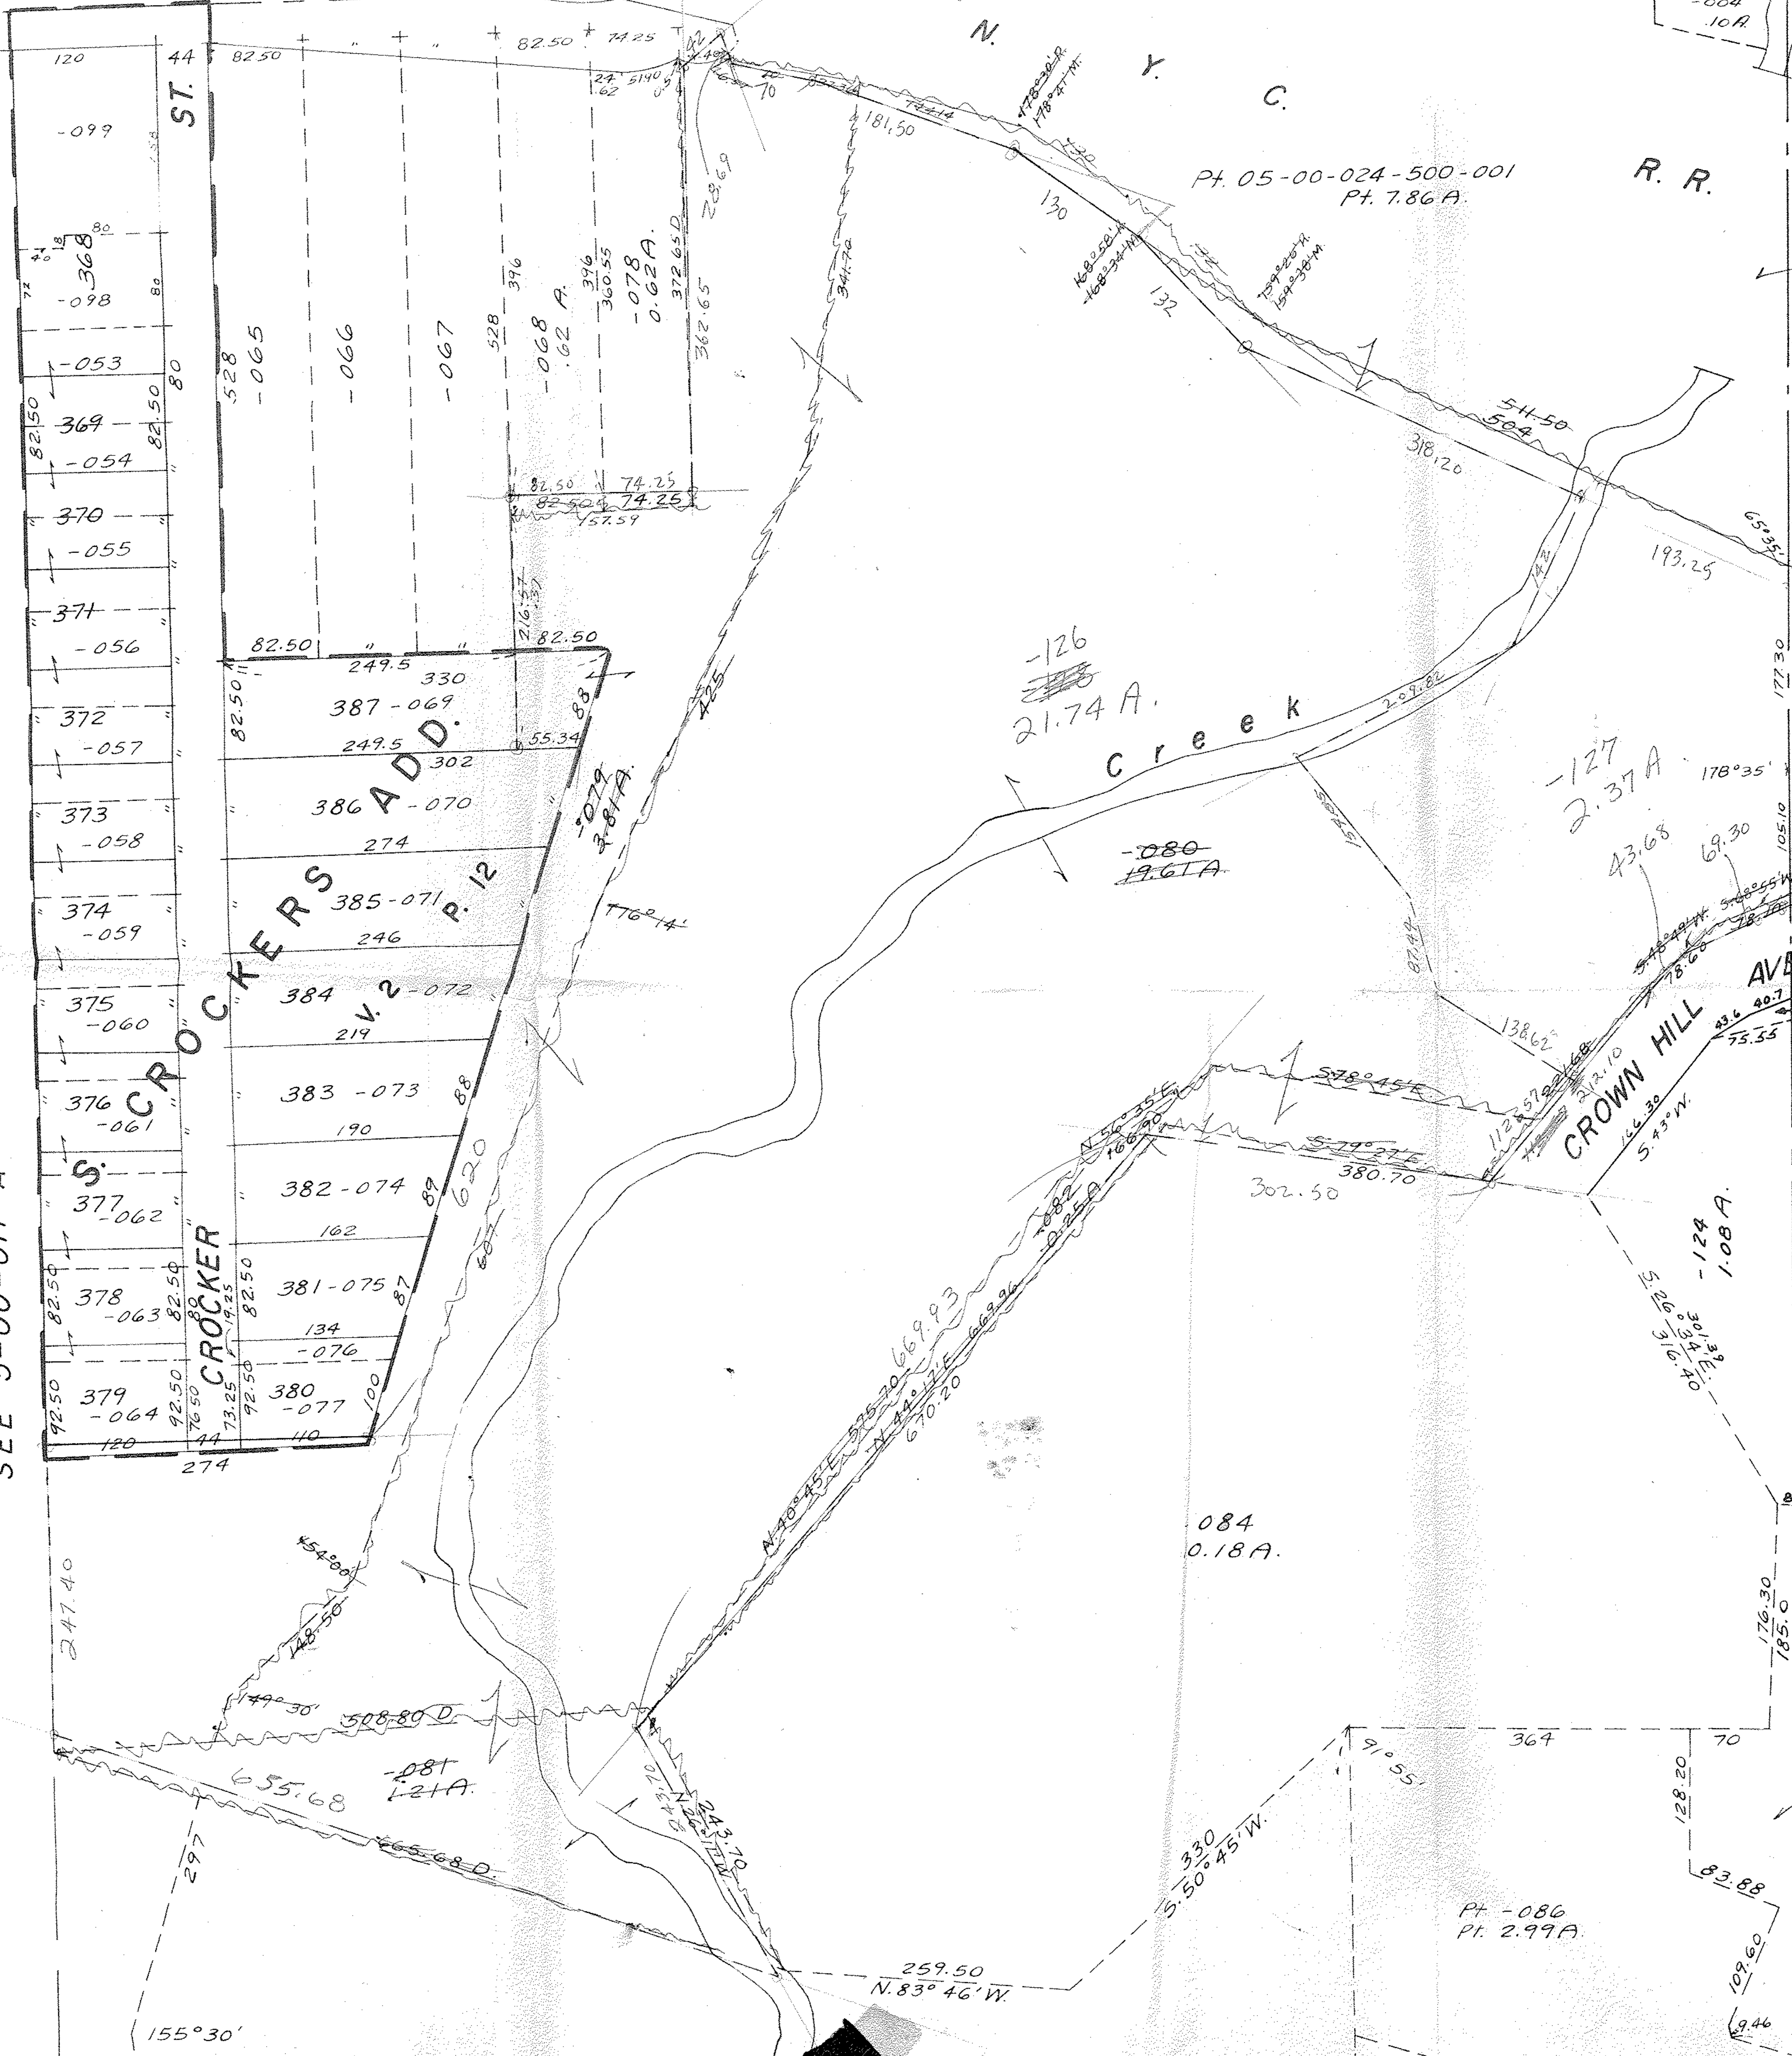

WHEN COMPLETED  
SEND NEW PAGE TO  
ON CROMAFLEX  
APP DEPT.

SEE 5-00-024-A

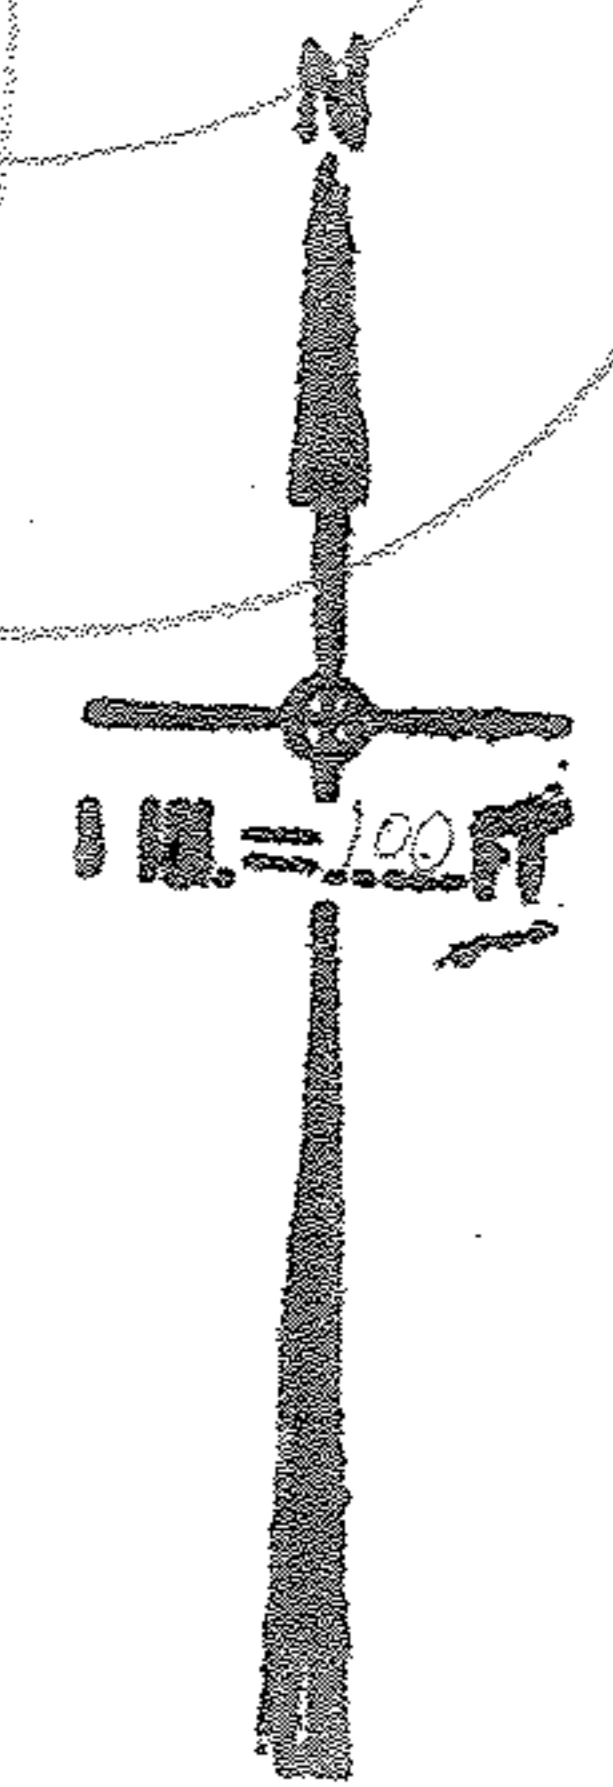

1817

APPROVED  
LORAIN CO.  
MAP DEPT.  
DATE 5-31-68  
5-00-017-B  
BY *Hollbert*

*Done 7/19/68*  
*Jim Lease*

T-11-816

Pt -086  
Pt. 2.99A

084  
0.18A

-081  
1.21A

-127  
2.37A

-126  
21.74A

-080  
19.61A

-124  
1.08A

155°30'

259.50  
N. 83° 46' W.

330  
S. 50° 45' W.

364

128.20

83.88

109.60

9.46

44.12

80.32

176.30

185.0

177.30

105.10

69.30

43.68

193.25
















318.20

130

132

181.50












