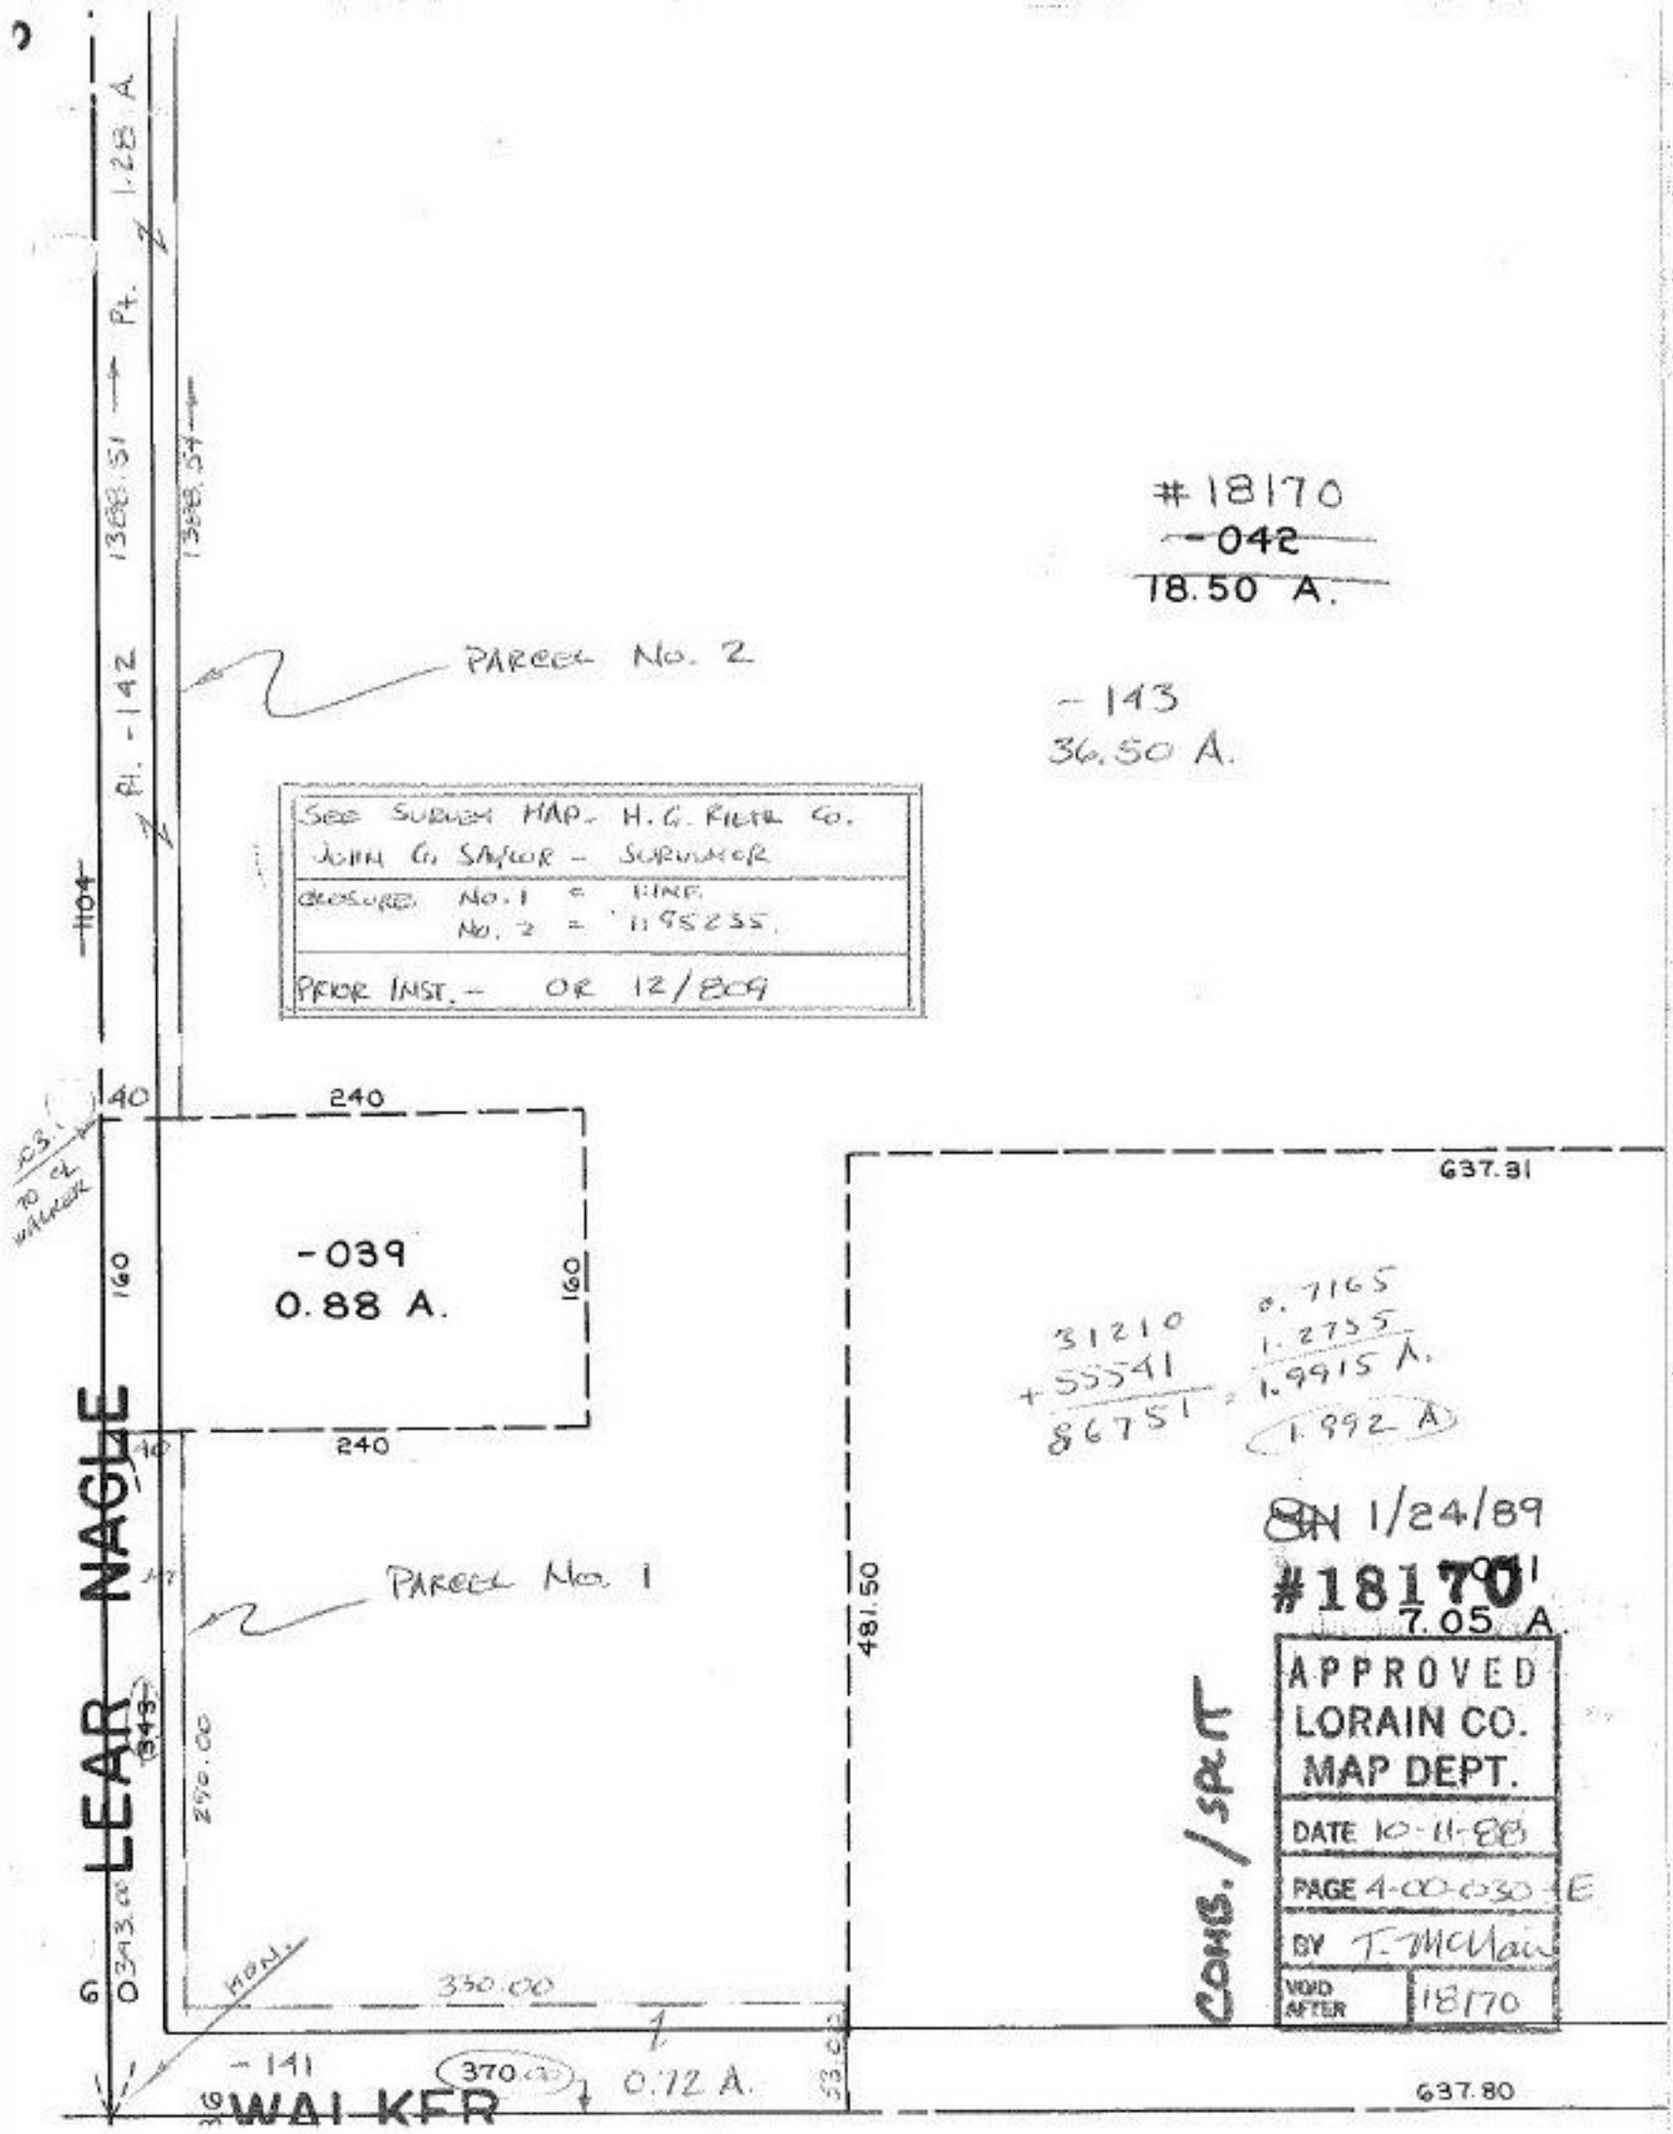
1.28 A.
Pt.
1368.51
1368.54
Pt. -142
#18170
-042
18.50 A.
PARCEL No. 2
-143
36.50 A.
SEE SURVEY MAP - H.G. RIETH CO.
JOHN G. SAYLOR - SURVEYOR
CLOSURE NO. 1 = BINF.
NO. 2 = 1195255.
PRIOR INST. - OR 12/809
-104
40
240
-039
0.88 A.
160
160
240
637.31
31210
+55541
86751
.7165
1.2755
1.9915 A.
1.992 A
SN 1/24/89
#18170
7.05 A
APPROVED
LORAIN CO.
MAP DEPT.
DATE 10-11-88
PAGE 4-00-030-E
BY T. McMain
VOID AFTER 18170
CONS. / SPLIT
481.50
PARCEL No. 1
270.00
330.00
N89°
-141
370.00
0.72 A.
53.69
637.80
LEAR NAGLE
WALKER