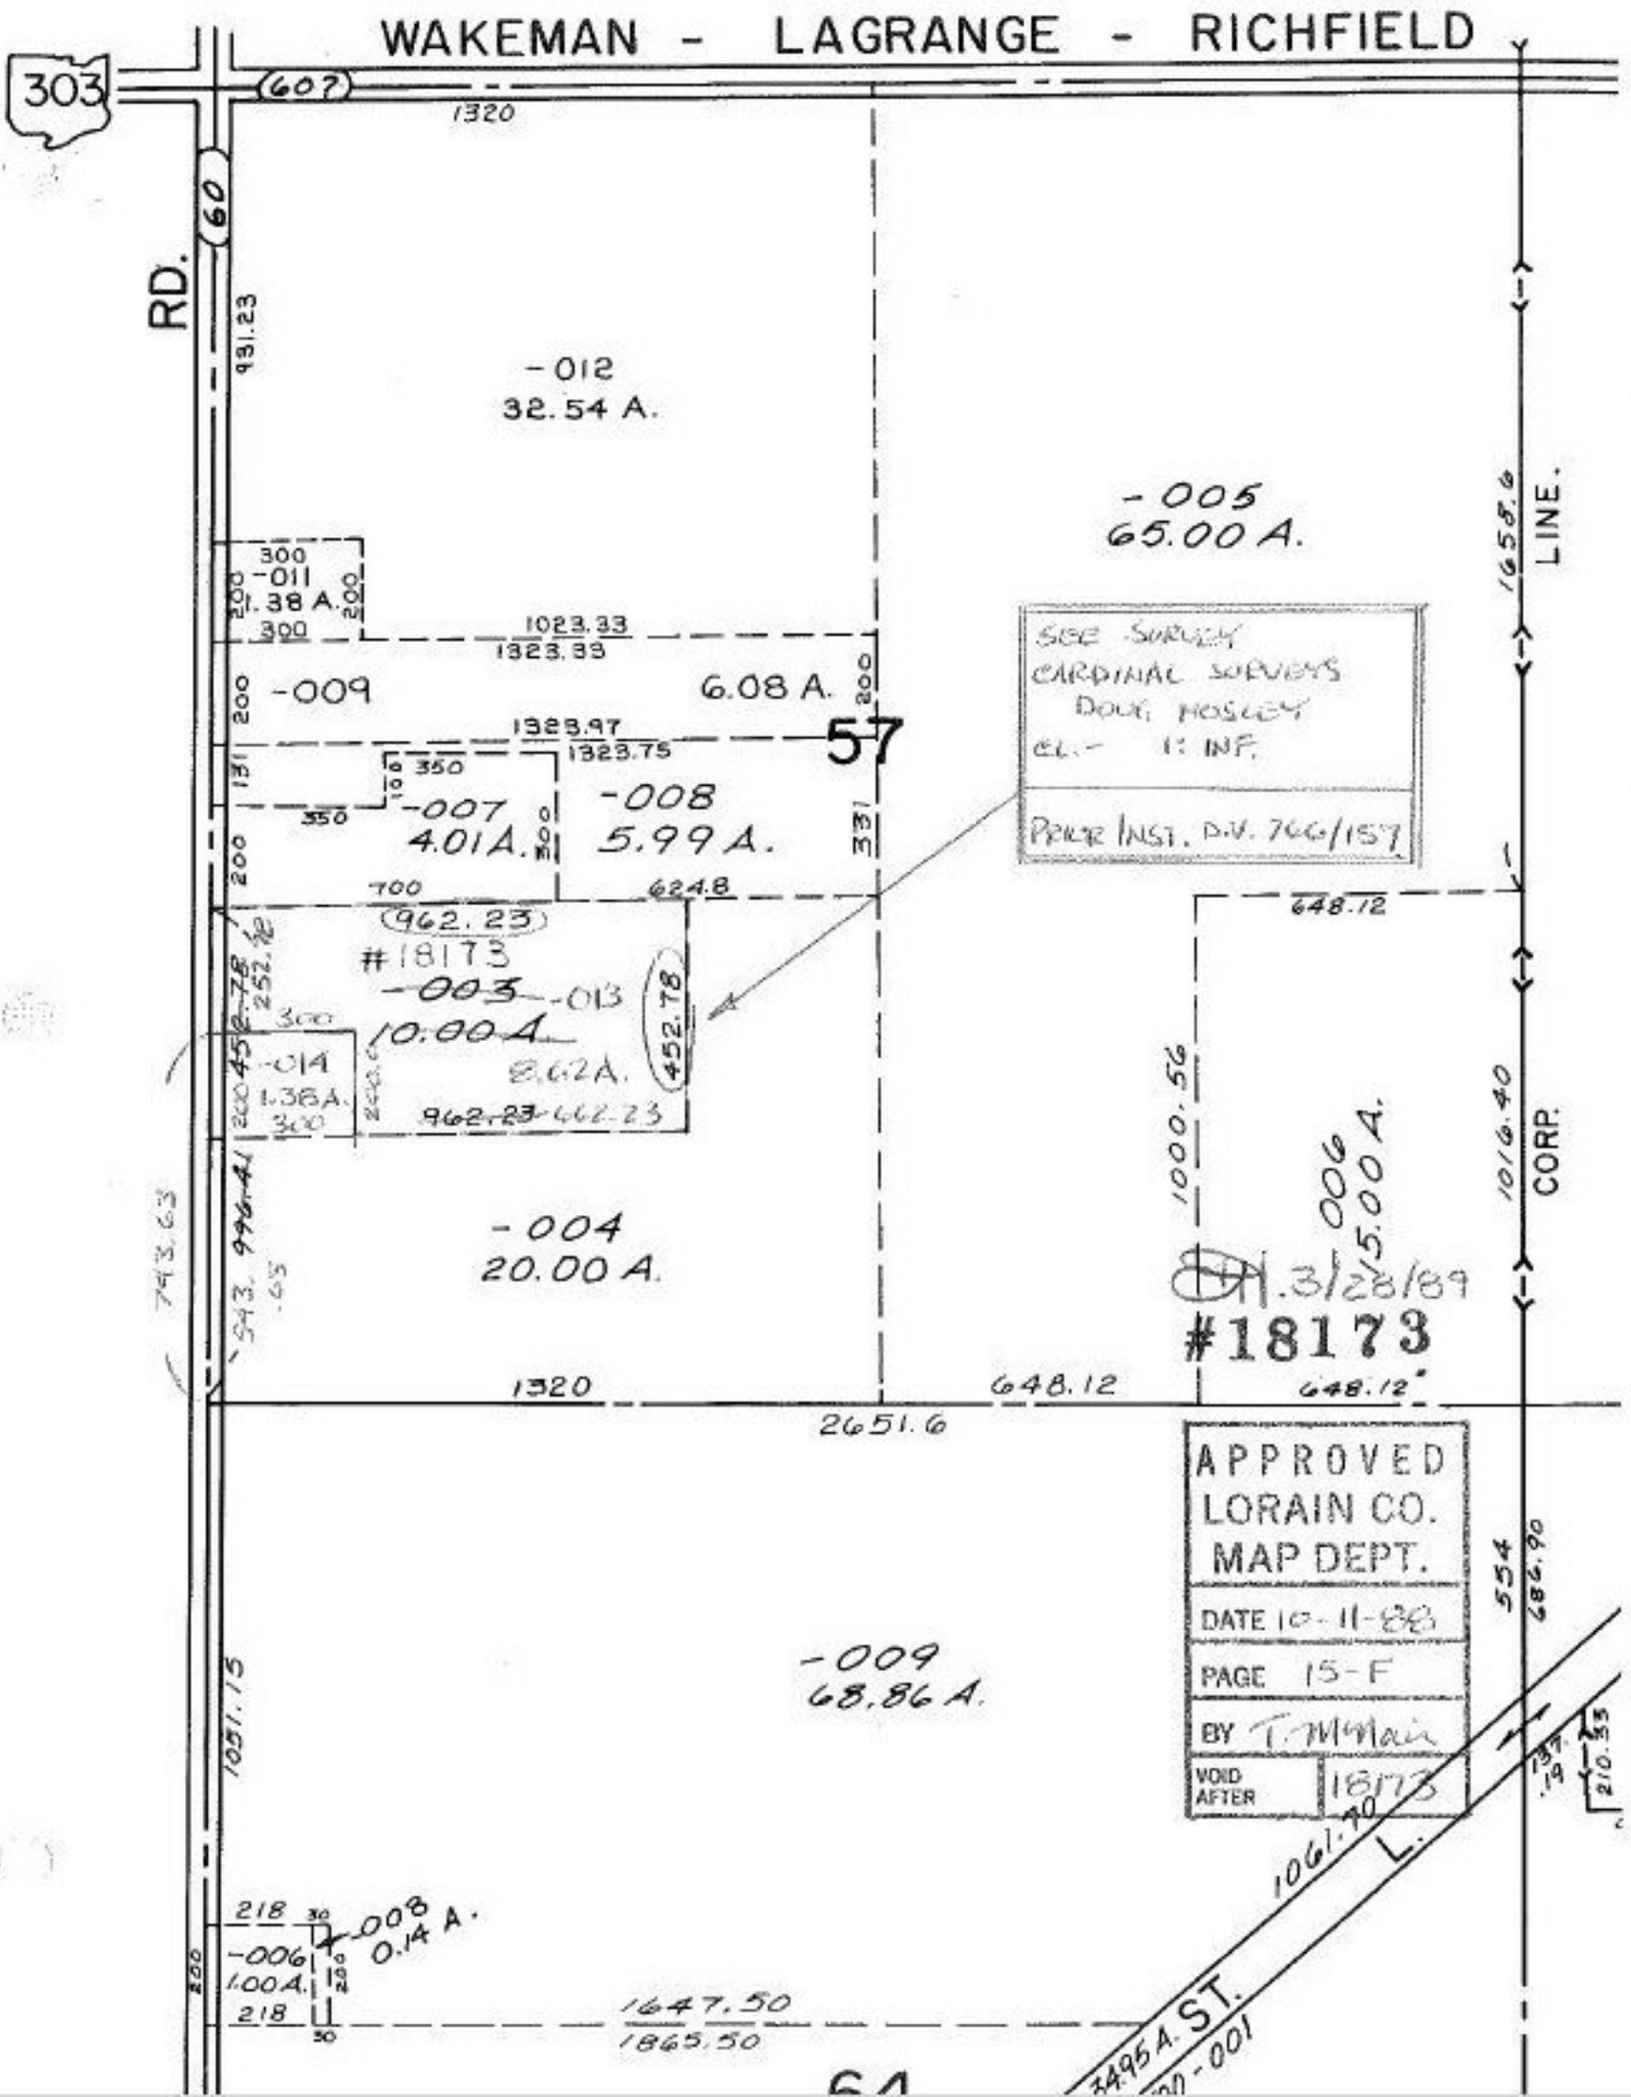

WAKEMAN - LAGRANGE - RICHFIELD
303
(607)
1320
60
RD.
931.23
-012
32.54 A.
-005
65.00 A.
1658.6
LINE.
300
-011
1.38 A.
200
1023.33
1323.33
-009
6.08 A.
1323.97
1323.75
57
SEE SURVEY
CARDINAL SURVEYS
DOUG MOSLEY
CL.- 1: INF.
PRIOR INST. D.V. 766/157
350
-007
4.01A.
-008
5.99 A.
331
700
624.8
648.12
(962.23)
#18173
-003
-013
10.00 A.
8.62A.
452.78
-014
1.38A.
962.23
662.23
1000.56
006
15.00 A.
1016.40
CORP.
-004
20.00 A.
743.63
996.41
543.
.65
3/28/89
#18173
1320
648.12
648.12
2651.6
APPROVED
LORAIN CO.
MAP DEPT.
DATE 10-11-88
PAGE 15-F
BY T. McMain
VOID AFTER 18173
554
686.90
-009
68.86 A.
1051.15
137.
.19
210.33
1061.70
L.
218
-008
0.14 A.
-006
1.00A.
218
1647.50
1865.50
34.95 A. ST.
-001
64