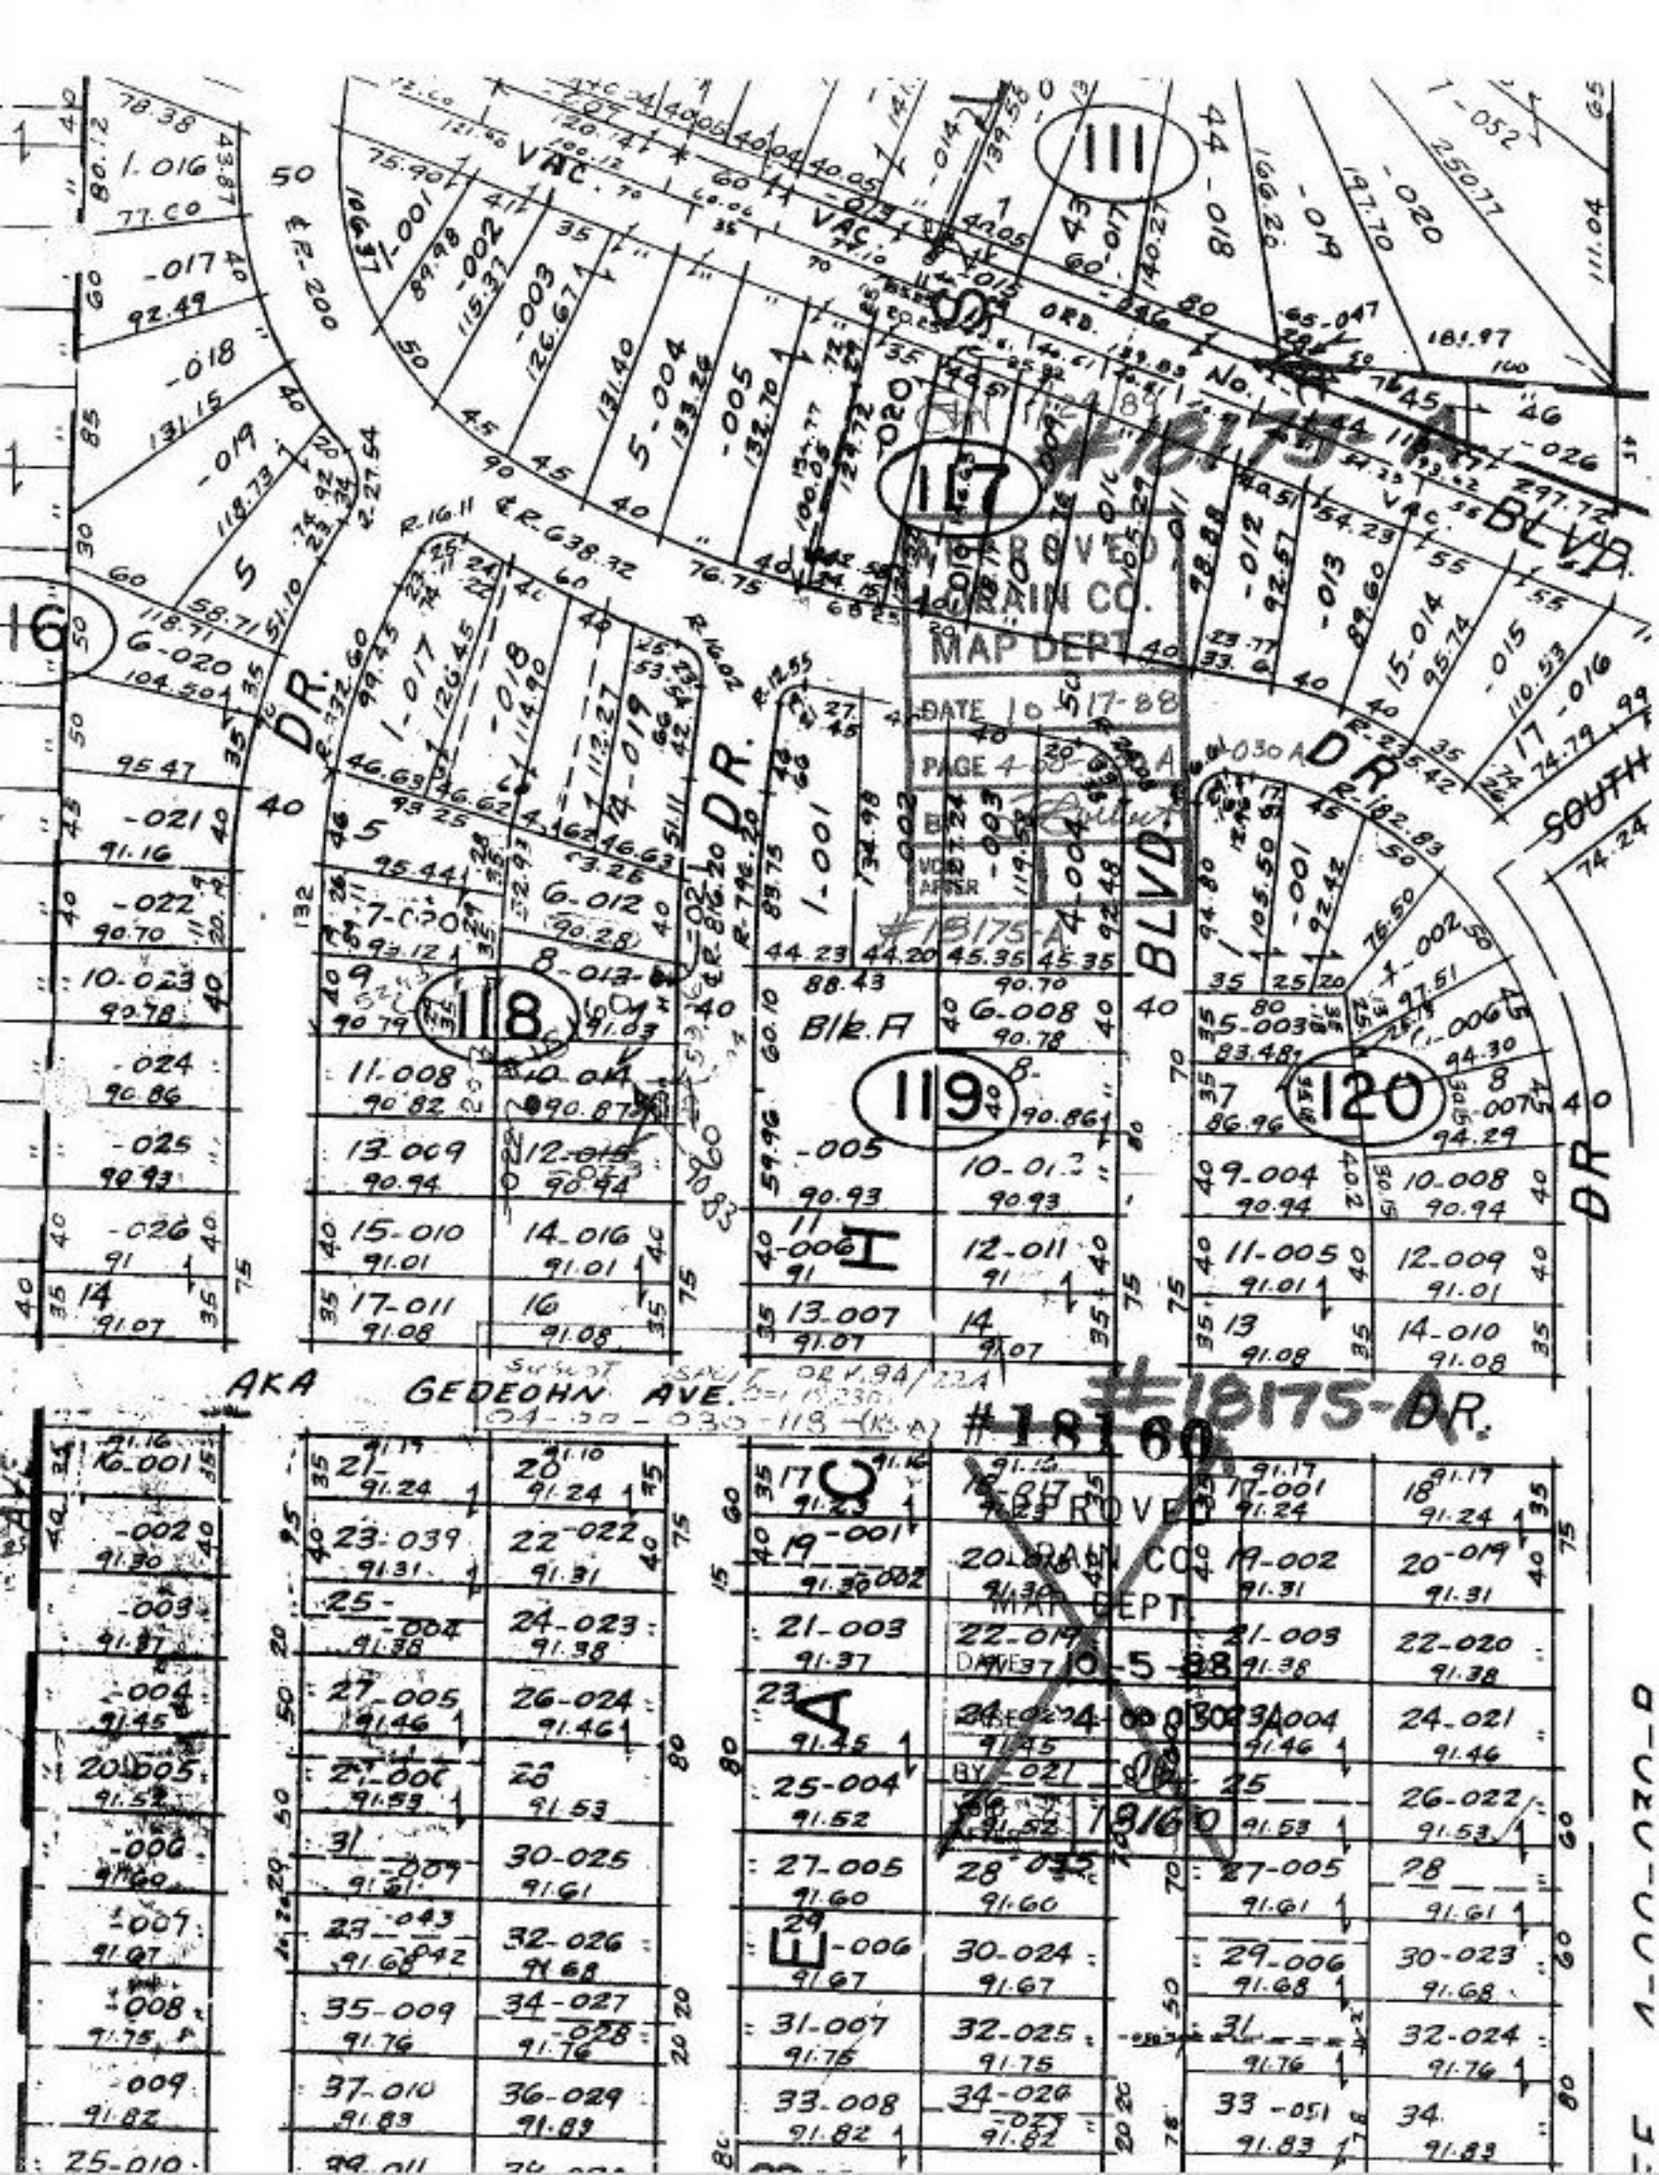

111
117
118
119
120
#18175-A
APPROVED
MAP DEPT
DATE 10-17-88
PAGE 4-00-030A
BY
VOID AFTER
#18175-A
BLVD
DR.
SOUTH
AKA GEDEOHN AVE.
#18160
#18175-A
DR.
APPROVED
MAP DEPT
DATE 10-5-88
PAGE 4-00-030A
BY
18160