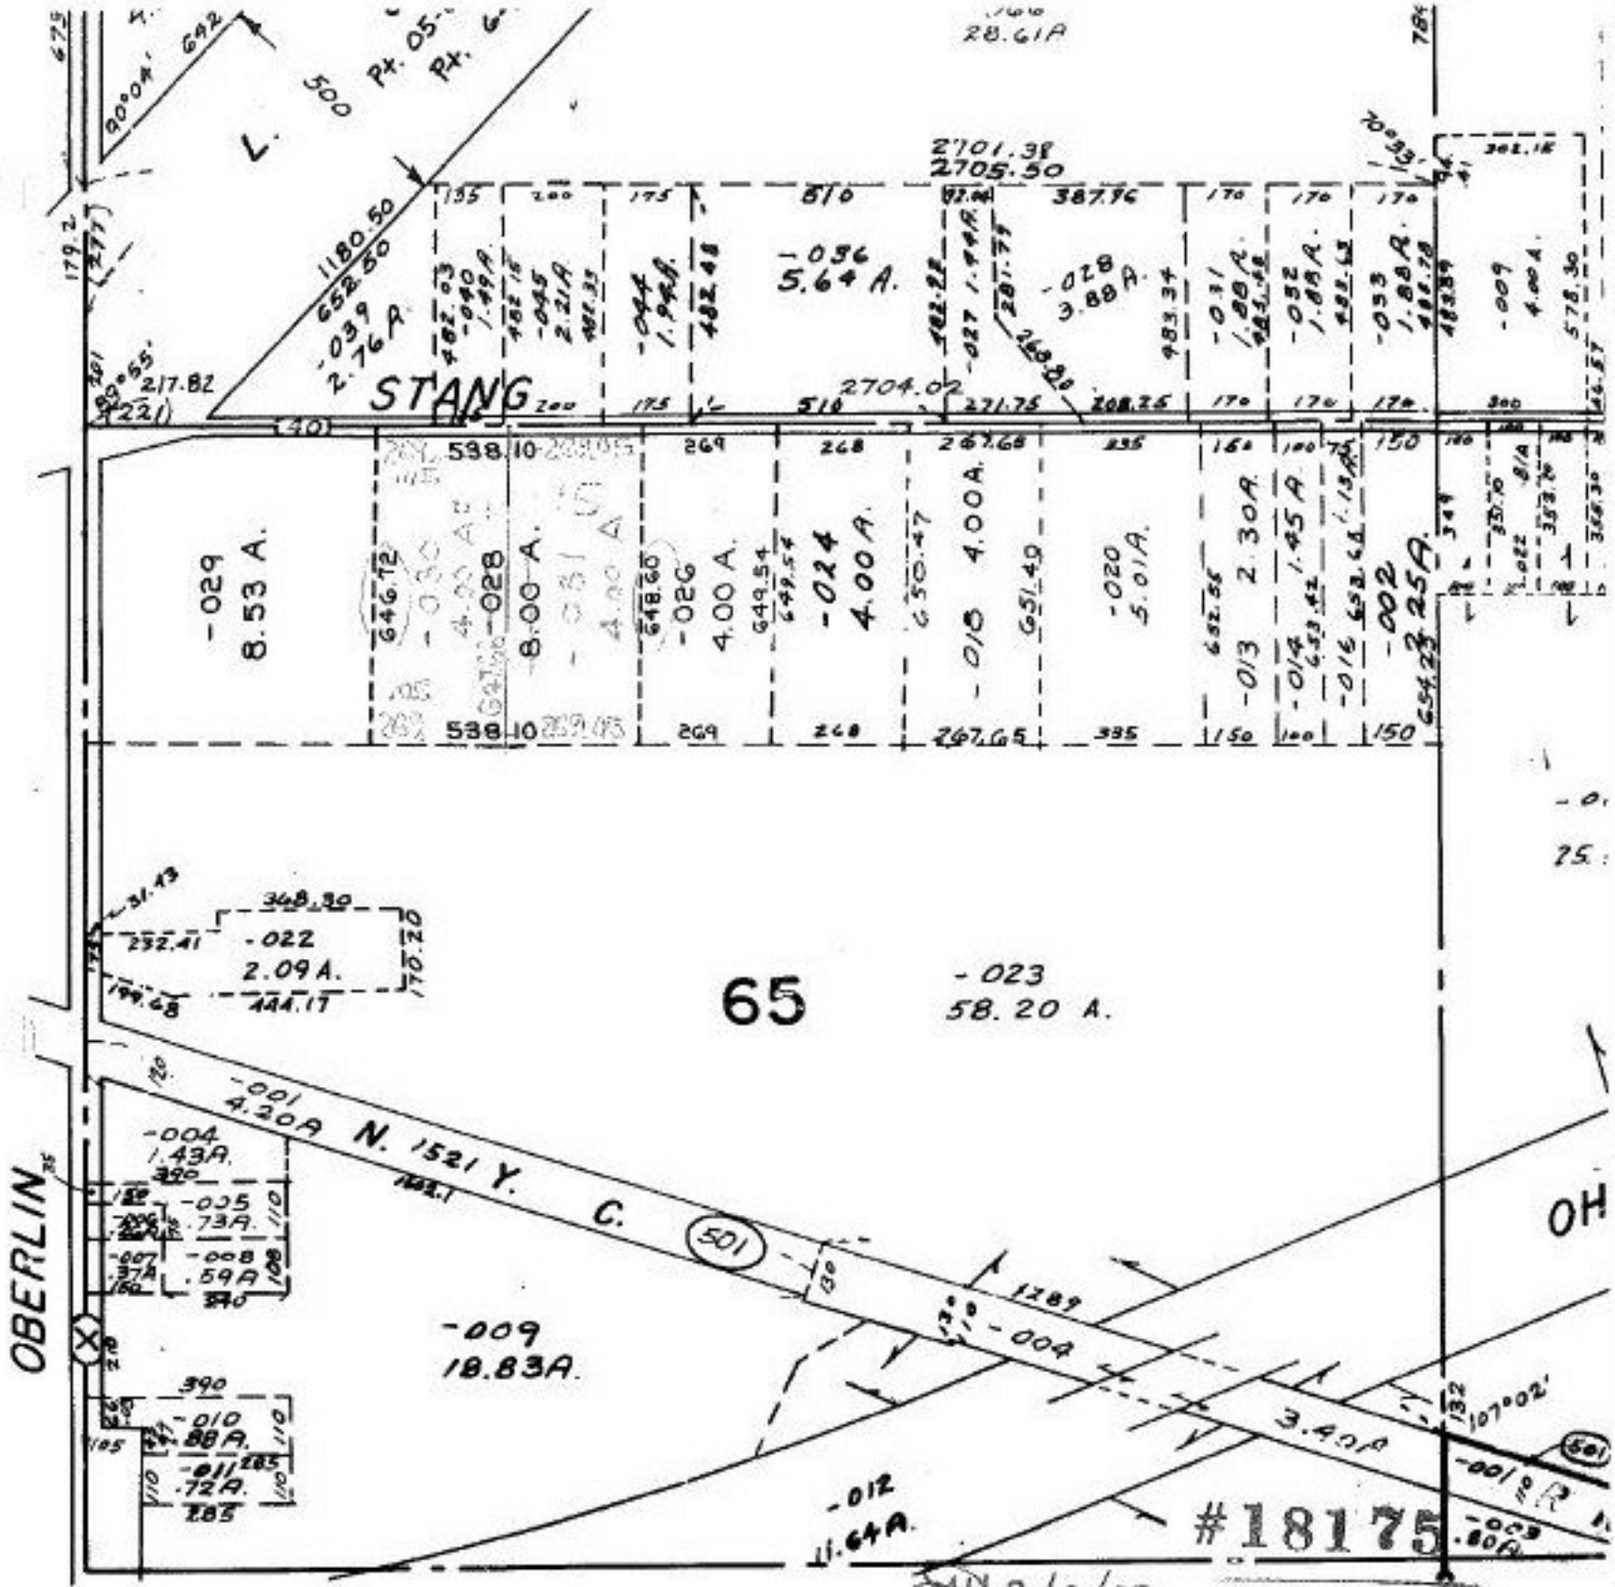

05-00-065-000-
PRIOR DEED: OR. V. 78/875
SURVEYED BY: ARNOLD KOEPP
C=1:200000 REG. SURV.*

AMHERST TWP.

SCALE : 1" = 400'