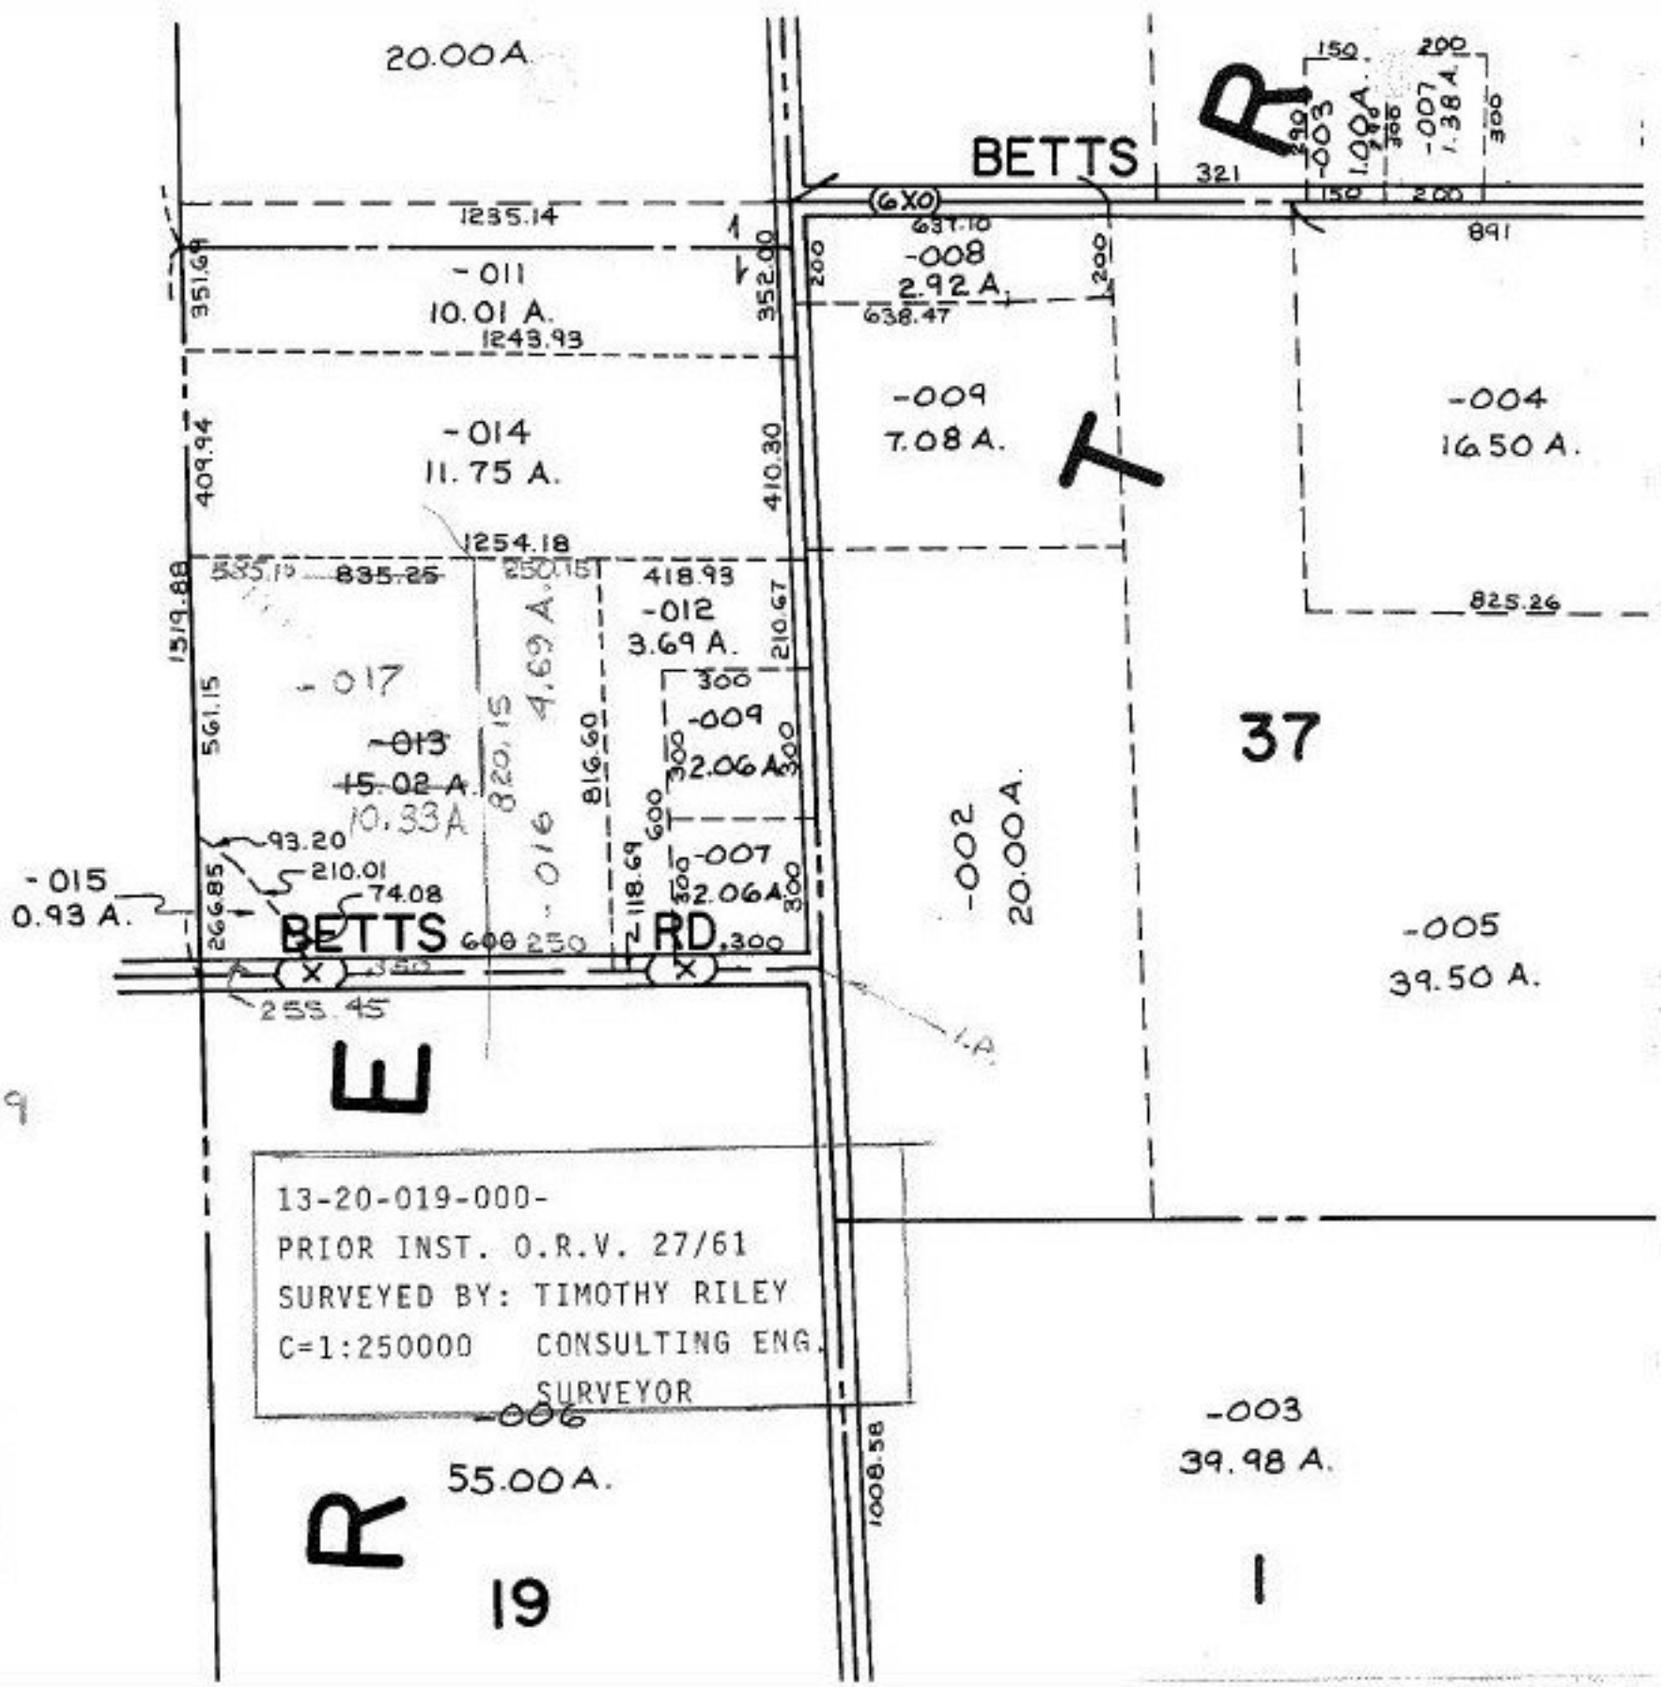

3/27/89
#18177

APPROVED
LORAIN CO.
MAP DEPT.

DATE 10-18-88
PAGE 13-E
BY Carol Franks
VOID AFTER # 18177