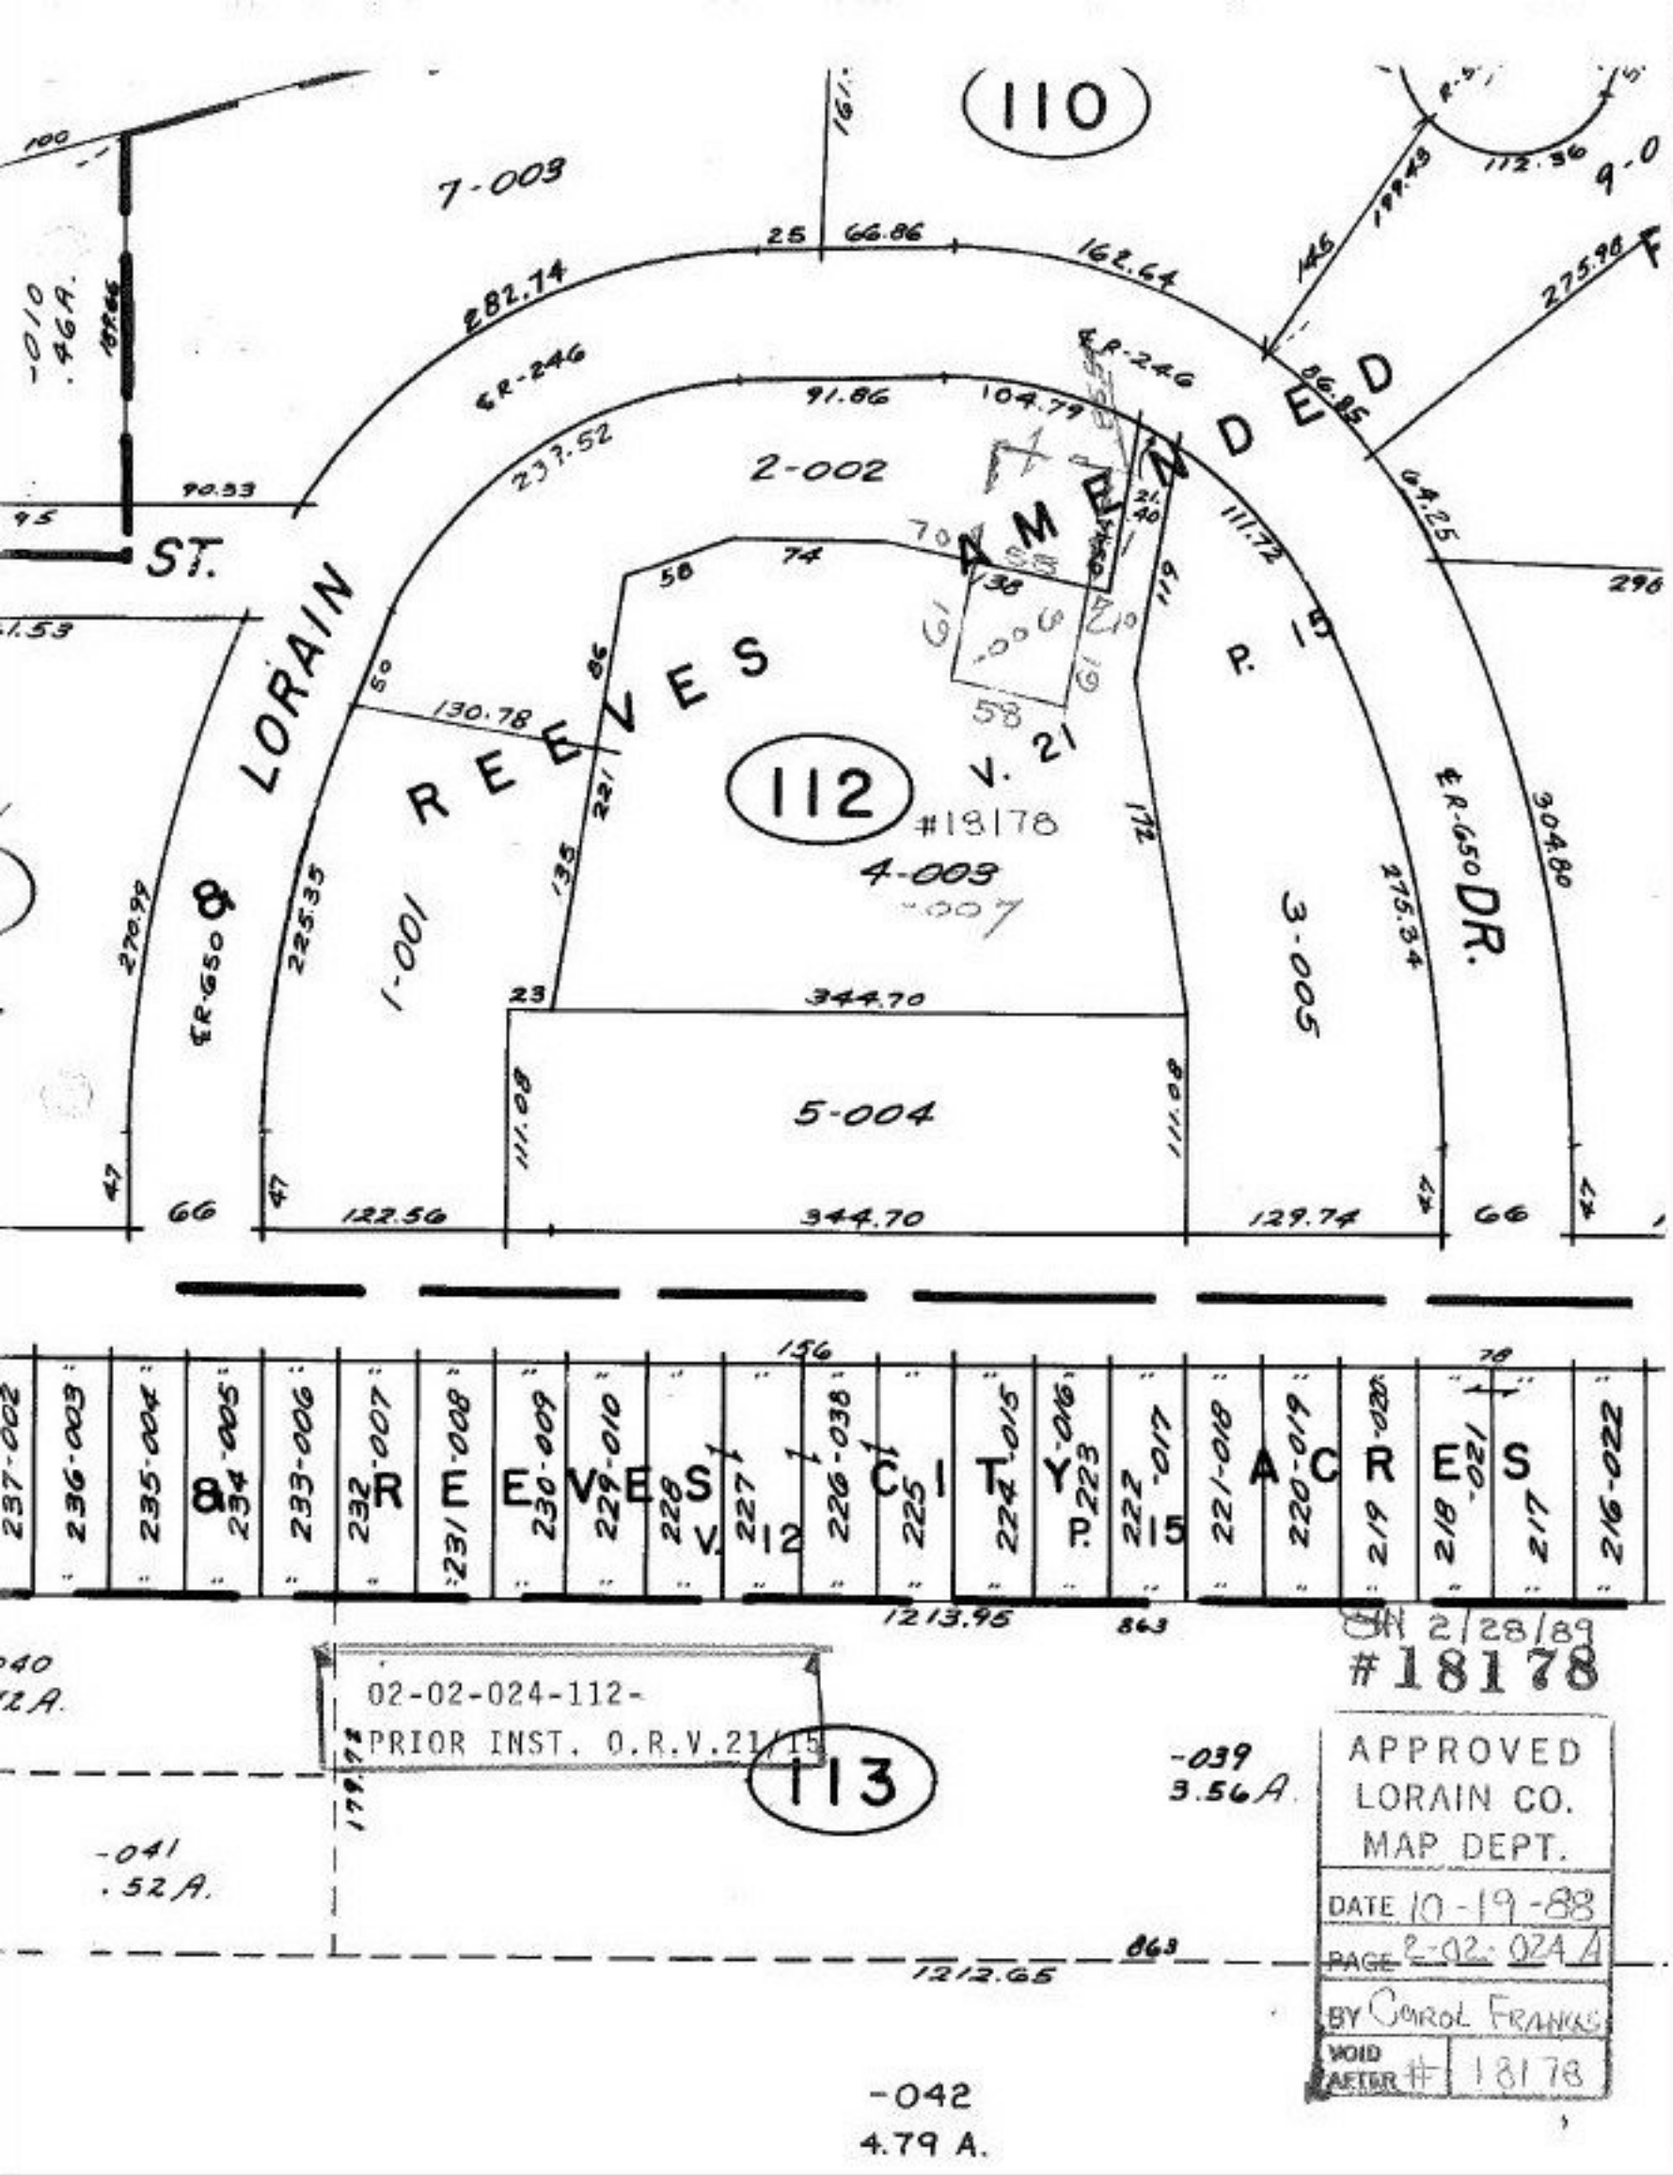
110
7-003
282.74
162.64
66.86
25
91.86
104.79
237.52
2-002
ST.
LORAIN
REZES
112
#18178
4-003
1-001
3-005
5-004
344.70
122.56
129.74
111.08
130.78
275.34
304.80
ER-650 DR.
ER-246
-010
.46A.
-039
3.56A.
-041
.52A.
-042
4.79 A.
02-02-024-112-
PRIOR INST. O.R.V.21/15
113
1213.95
1212.65
863
156
237-002
236-003
235-004
234-005
233-006
232-007
231-008
230-009
229-010
228
227
226-038
225
224-015
223
222-017
221-018
220-019
219
218
216-022
APPROVED
LORAIN CO.
MAP DEPT.
DATE 10-19-88
PAGE 2-02-024A
BY CAROL FRANKS
VOID AFTER # 18178
RN 2/28/89
#18178