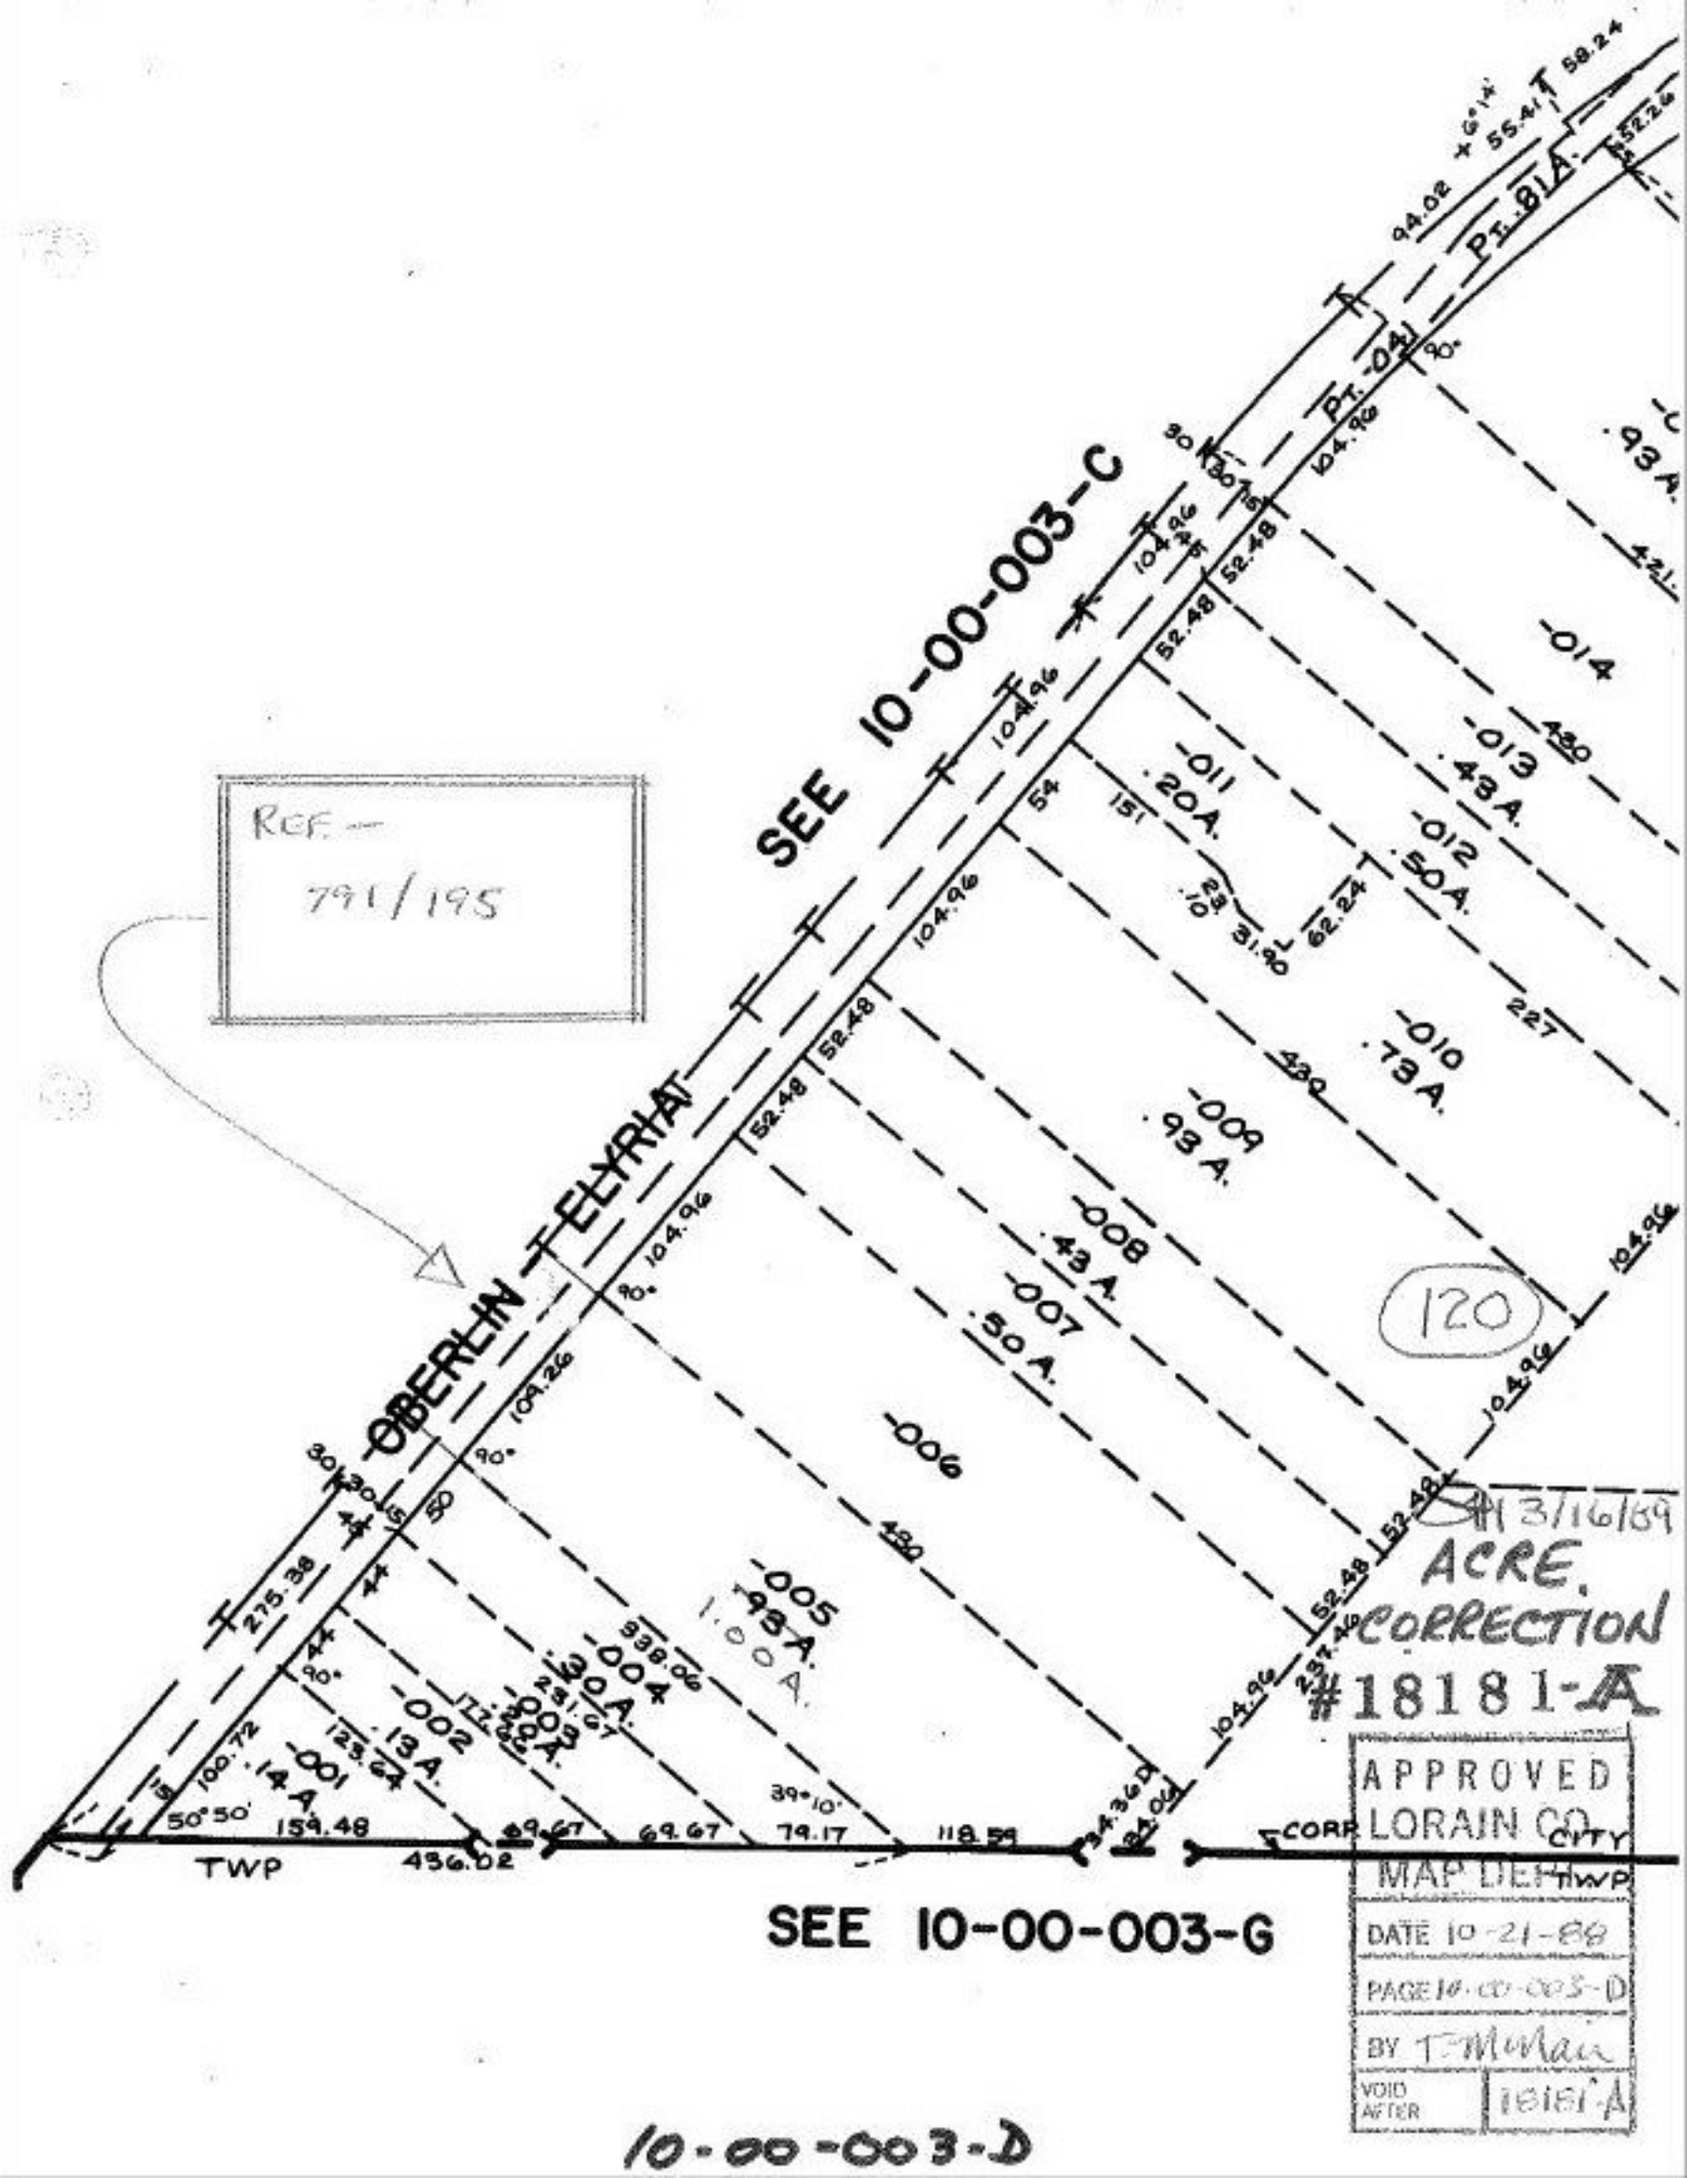
SEE 10-00-003-C
OBERLIN - ELYRIA
REF - 791/195
PT. 81A.
PT. 04
-014
-013 .43 A.
-012 .50 A.
-011 .20 A.
-010 .73 A.
-009 .93 A.
-008 .43 A.
-007 .50 A.
-006
-005 .98 A.
1.00 A.
-004 .30 A.
-003 .23 A.
-002 .13 A.
-001 .14 A.
120
3/16/69
ACRE.
CORRECTION
#18181-A
APPROVED
LORAIN CO.
MAP DEPT
DATE 10-21-88
PAGE 10-00-003-D
BY T. Mahan
VOID AFTER
18181-A
SEE 10-00-003-G
10-00-003-D