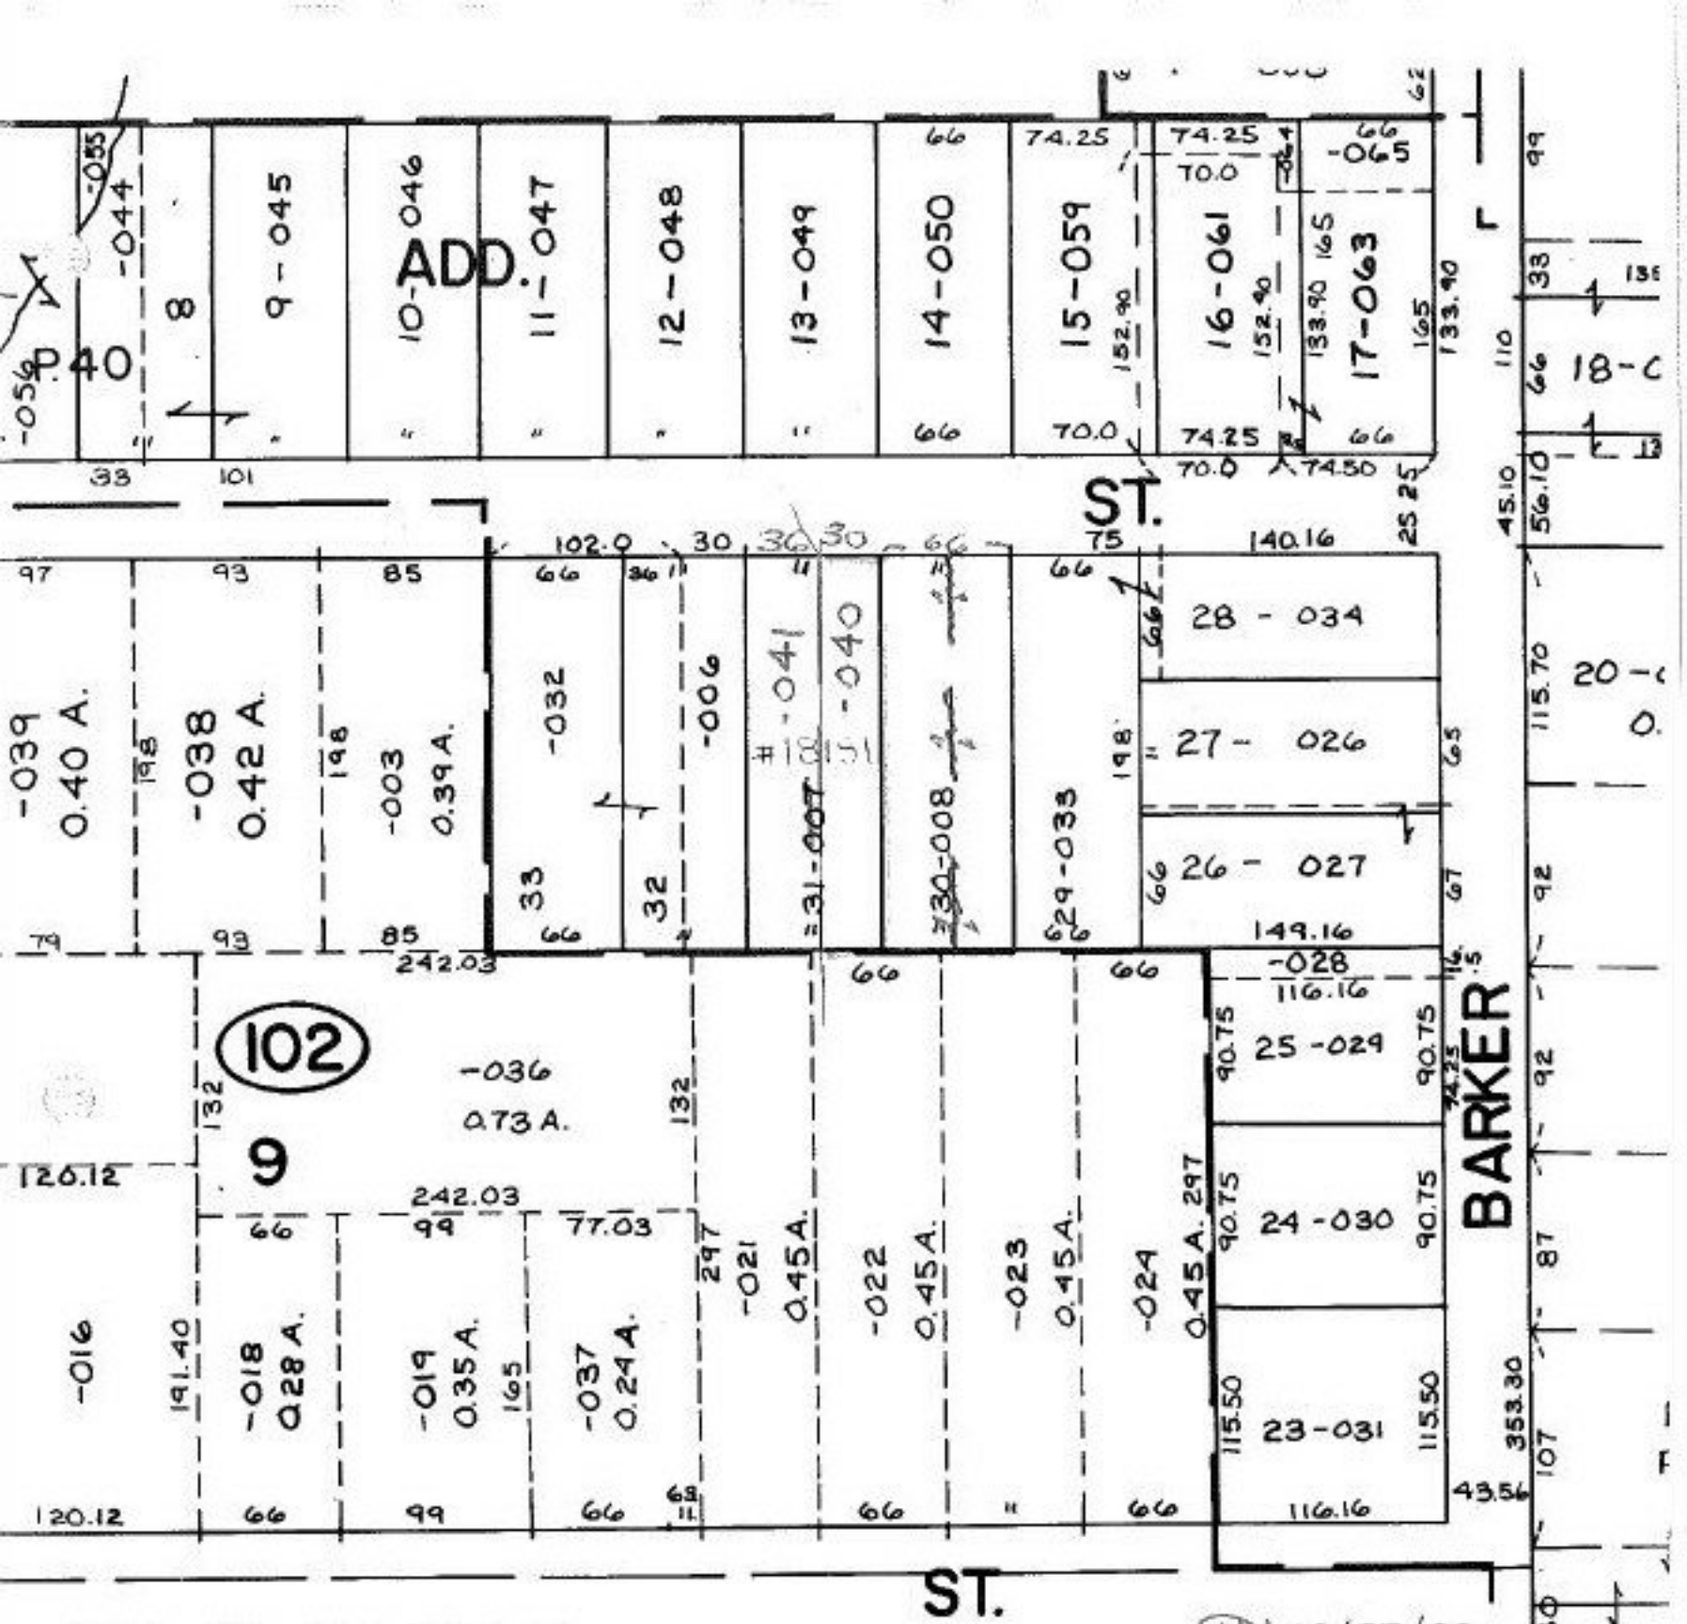

SEE 18-00-021-C

10/27/88

#18181

APPROVED
LORAIN CO.
MAP DEPT.
DATE 10-20-88
PAGE 18-00-021-A
BY Carol Francis
VOID AFTER # 18181

18-00-021-102-
PRIOR INST. 854/560

TWP