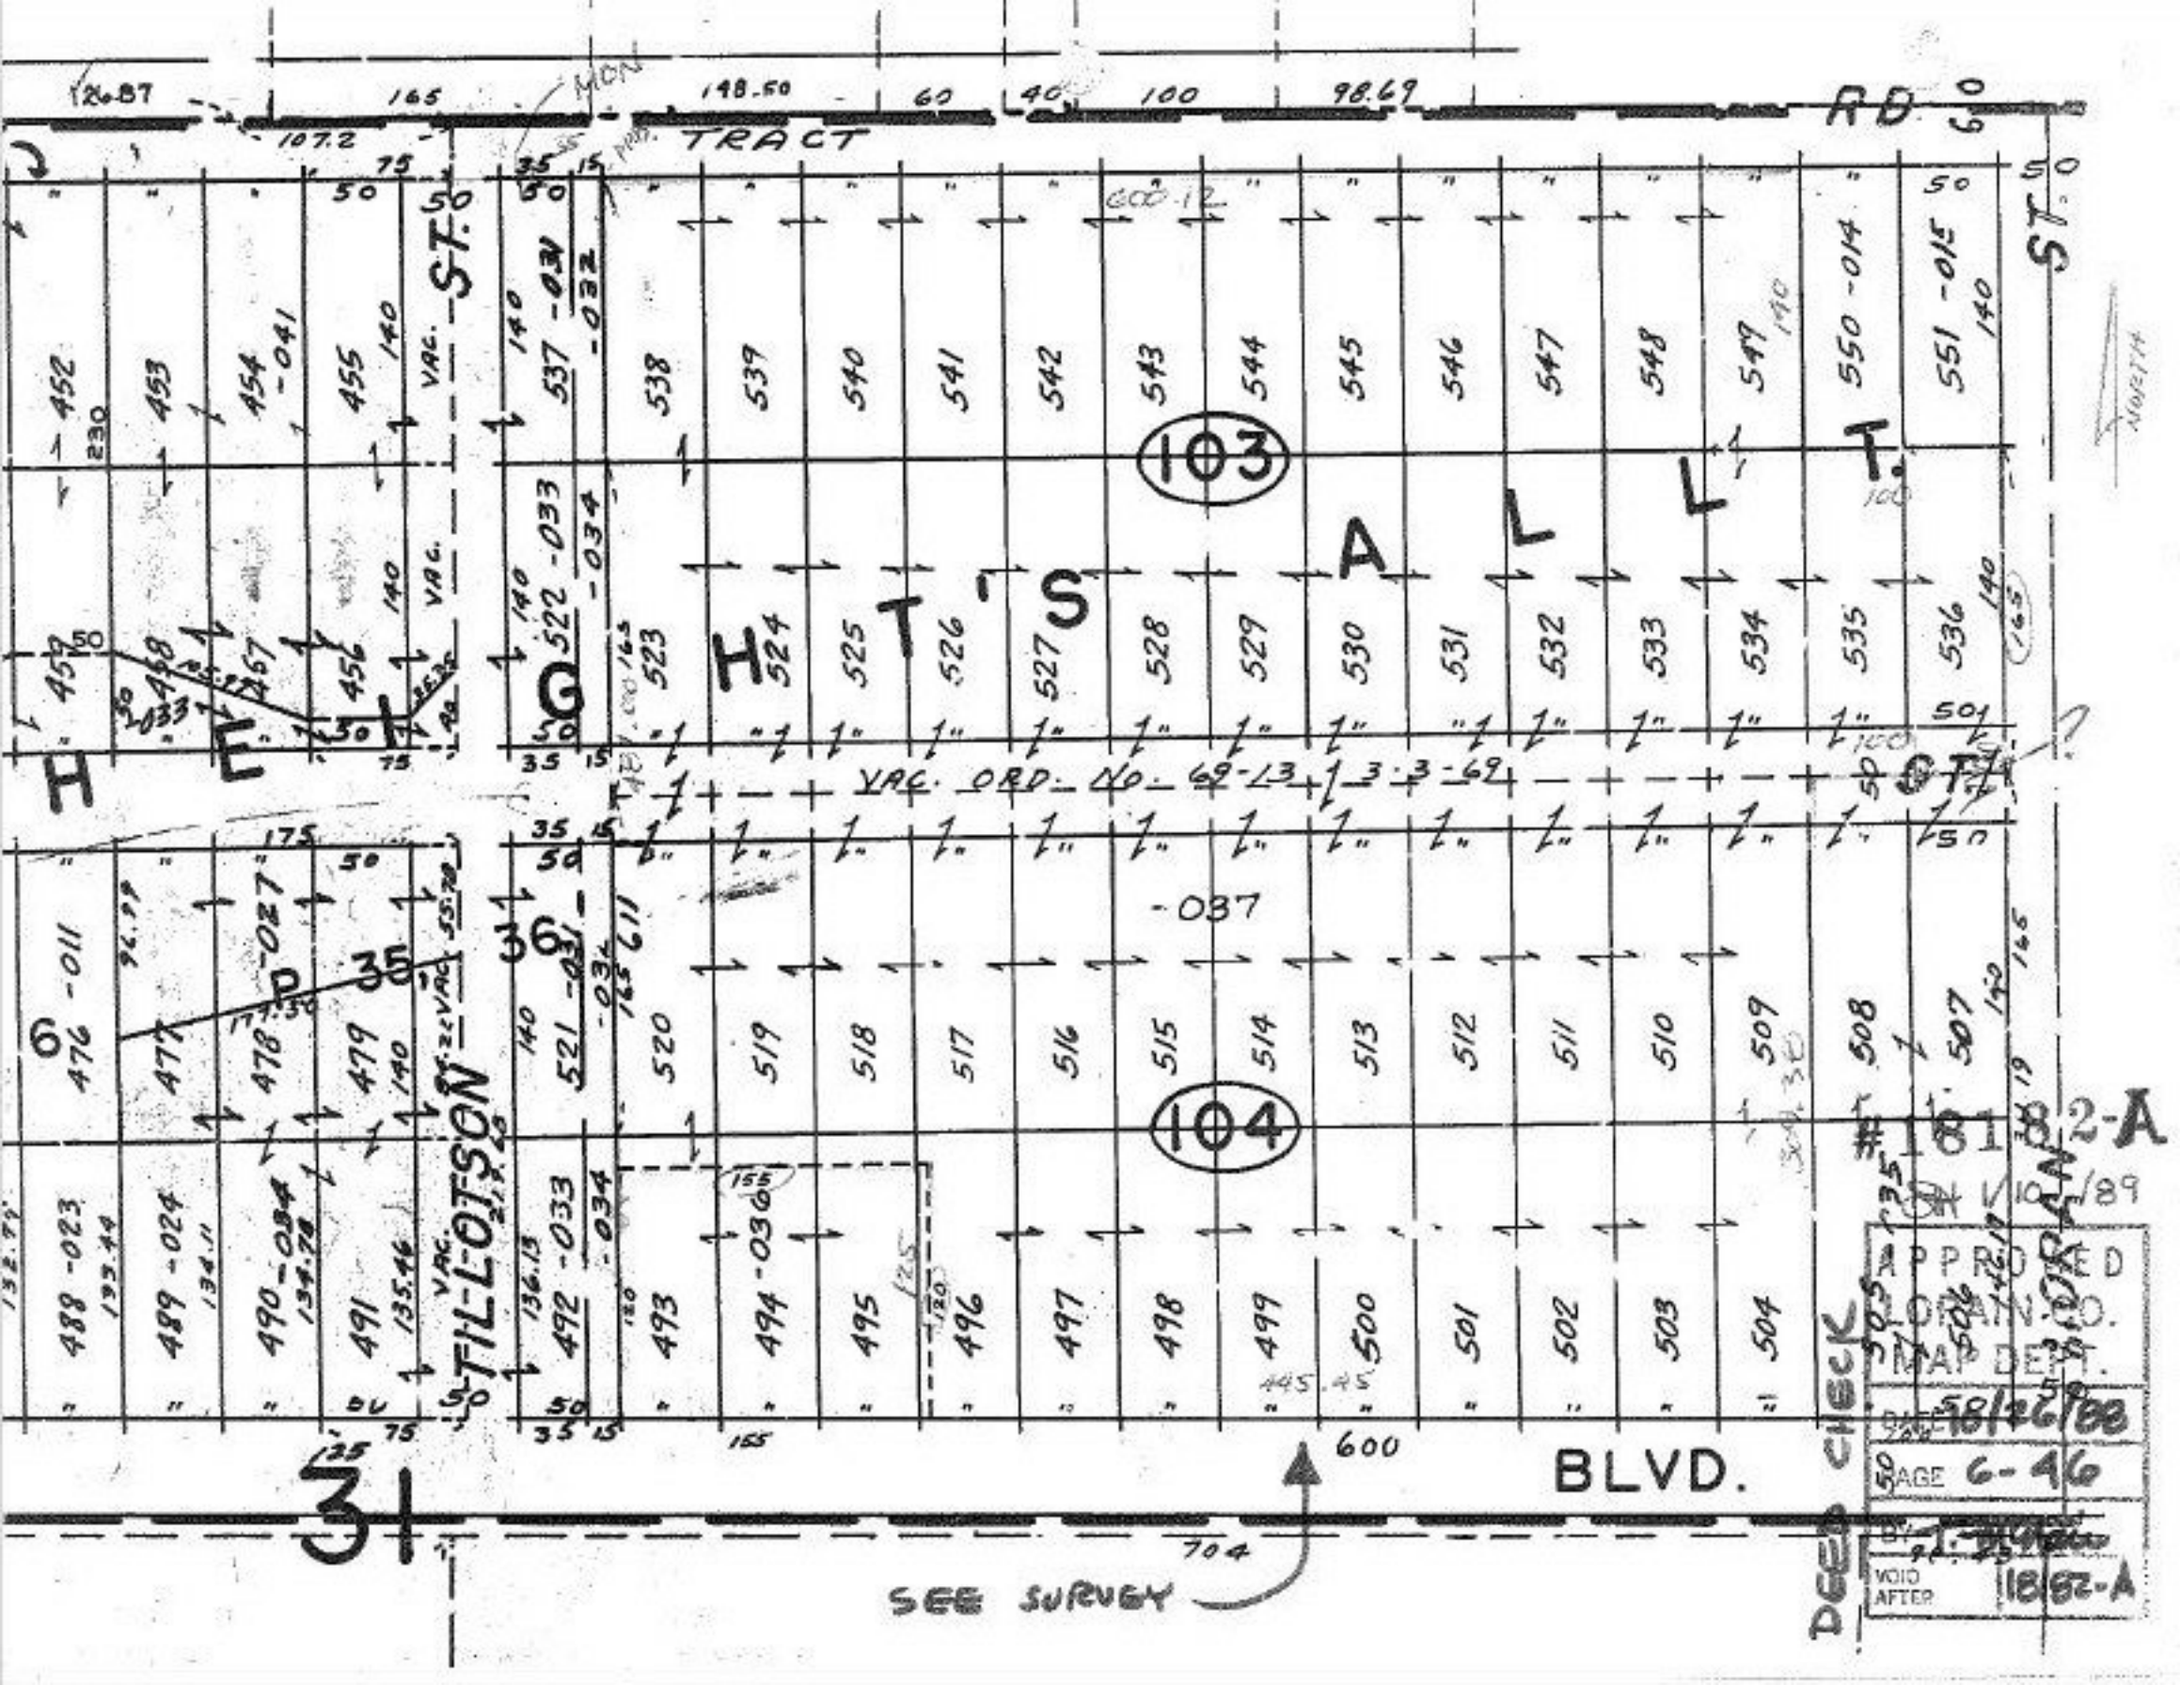

TRACT
RD
ST.
HEIGHT'S ALLT.
103
104
VAC. ORD. NO. 69-13 3-3-69
TILLOTSON
P 35
36
31
BLVD.
SEE SURVEY
DEED CHECK
#18182-A
APPROVED
LORAIN CO.
MAP DEPT.
DATE 10/26/88
PAGE 6-46
VOID AFTER 18182-A