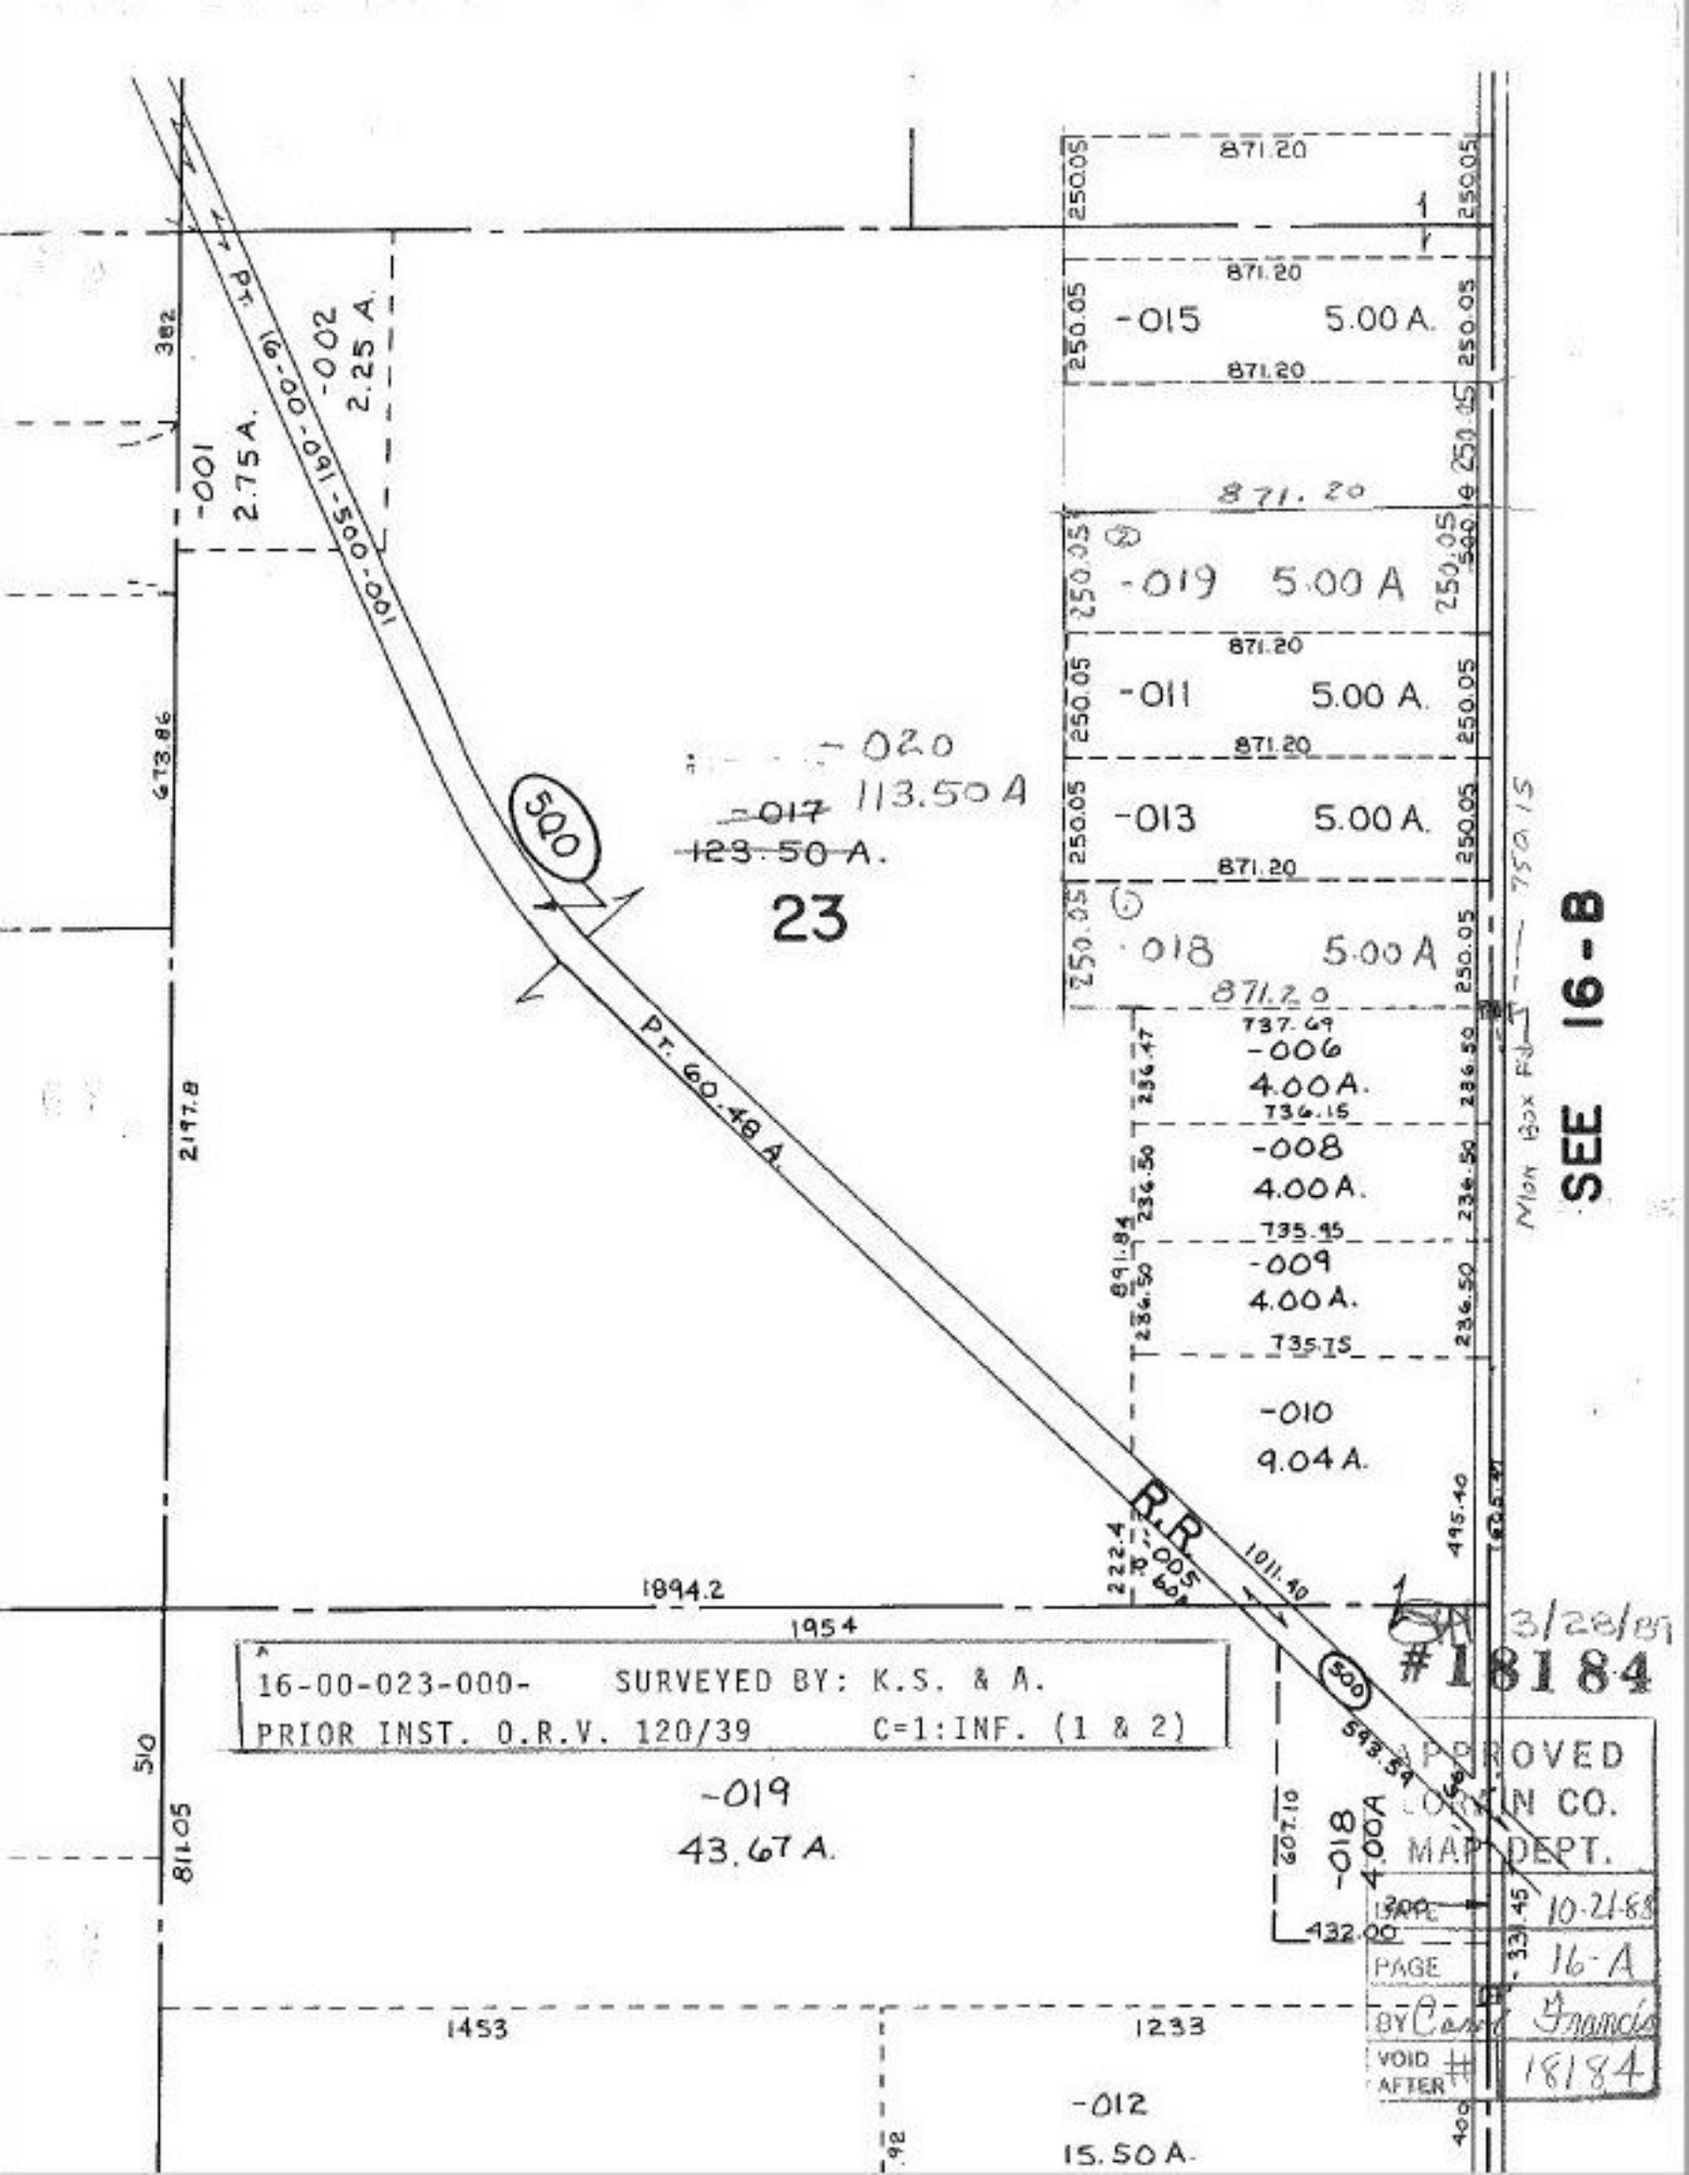
871.20
250.05
-015 5.00 A.
-019 5.00 A
-011 5.00 A.
-013 5.00 A.
-018 5.00 A
-006 4.00 A.
-008 4.00 A.
-009 4.00 A.
-010 9.04 A.
-020 113.50 A
-017 123.50 A.
23
-001 2.75 A.
-002 2.25 A.
100-005-160-00-01 Pt.
500
Pt. 60.48 A.
R.R.
-005
SEE 16-B
Main Box Rd
673.86
382
2197.8
1894.2
1954
510
811.05
1011.40
495.40
737.49
736.15
735.45
735.15
891.84
222.4
16-00-023-000- SURVEYED BY: K.S. & A.
PRIOR INST. O.R.V. 120/39 C=1:INF. (1 & 2)
-019
43.67 A.
-018
4.00A
1453
1233
-012
15.50 A.
3/28/85
#18184
APPROVED
MAP DEPT.
DATE 10-21-88
PAGE 16-A
BY Carol Francis
VOID # 18184
AFTER