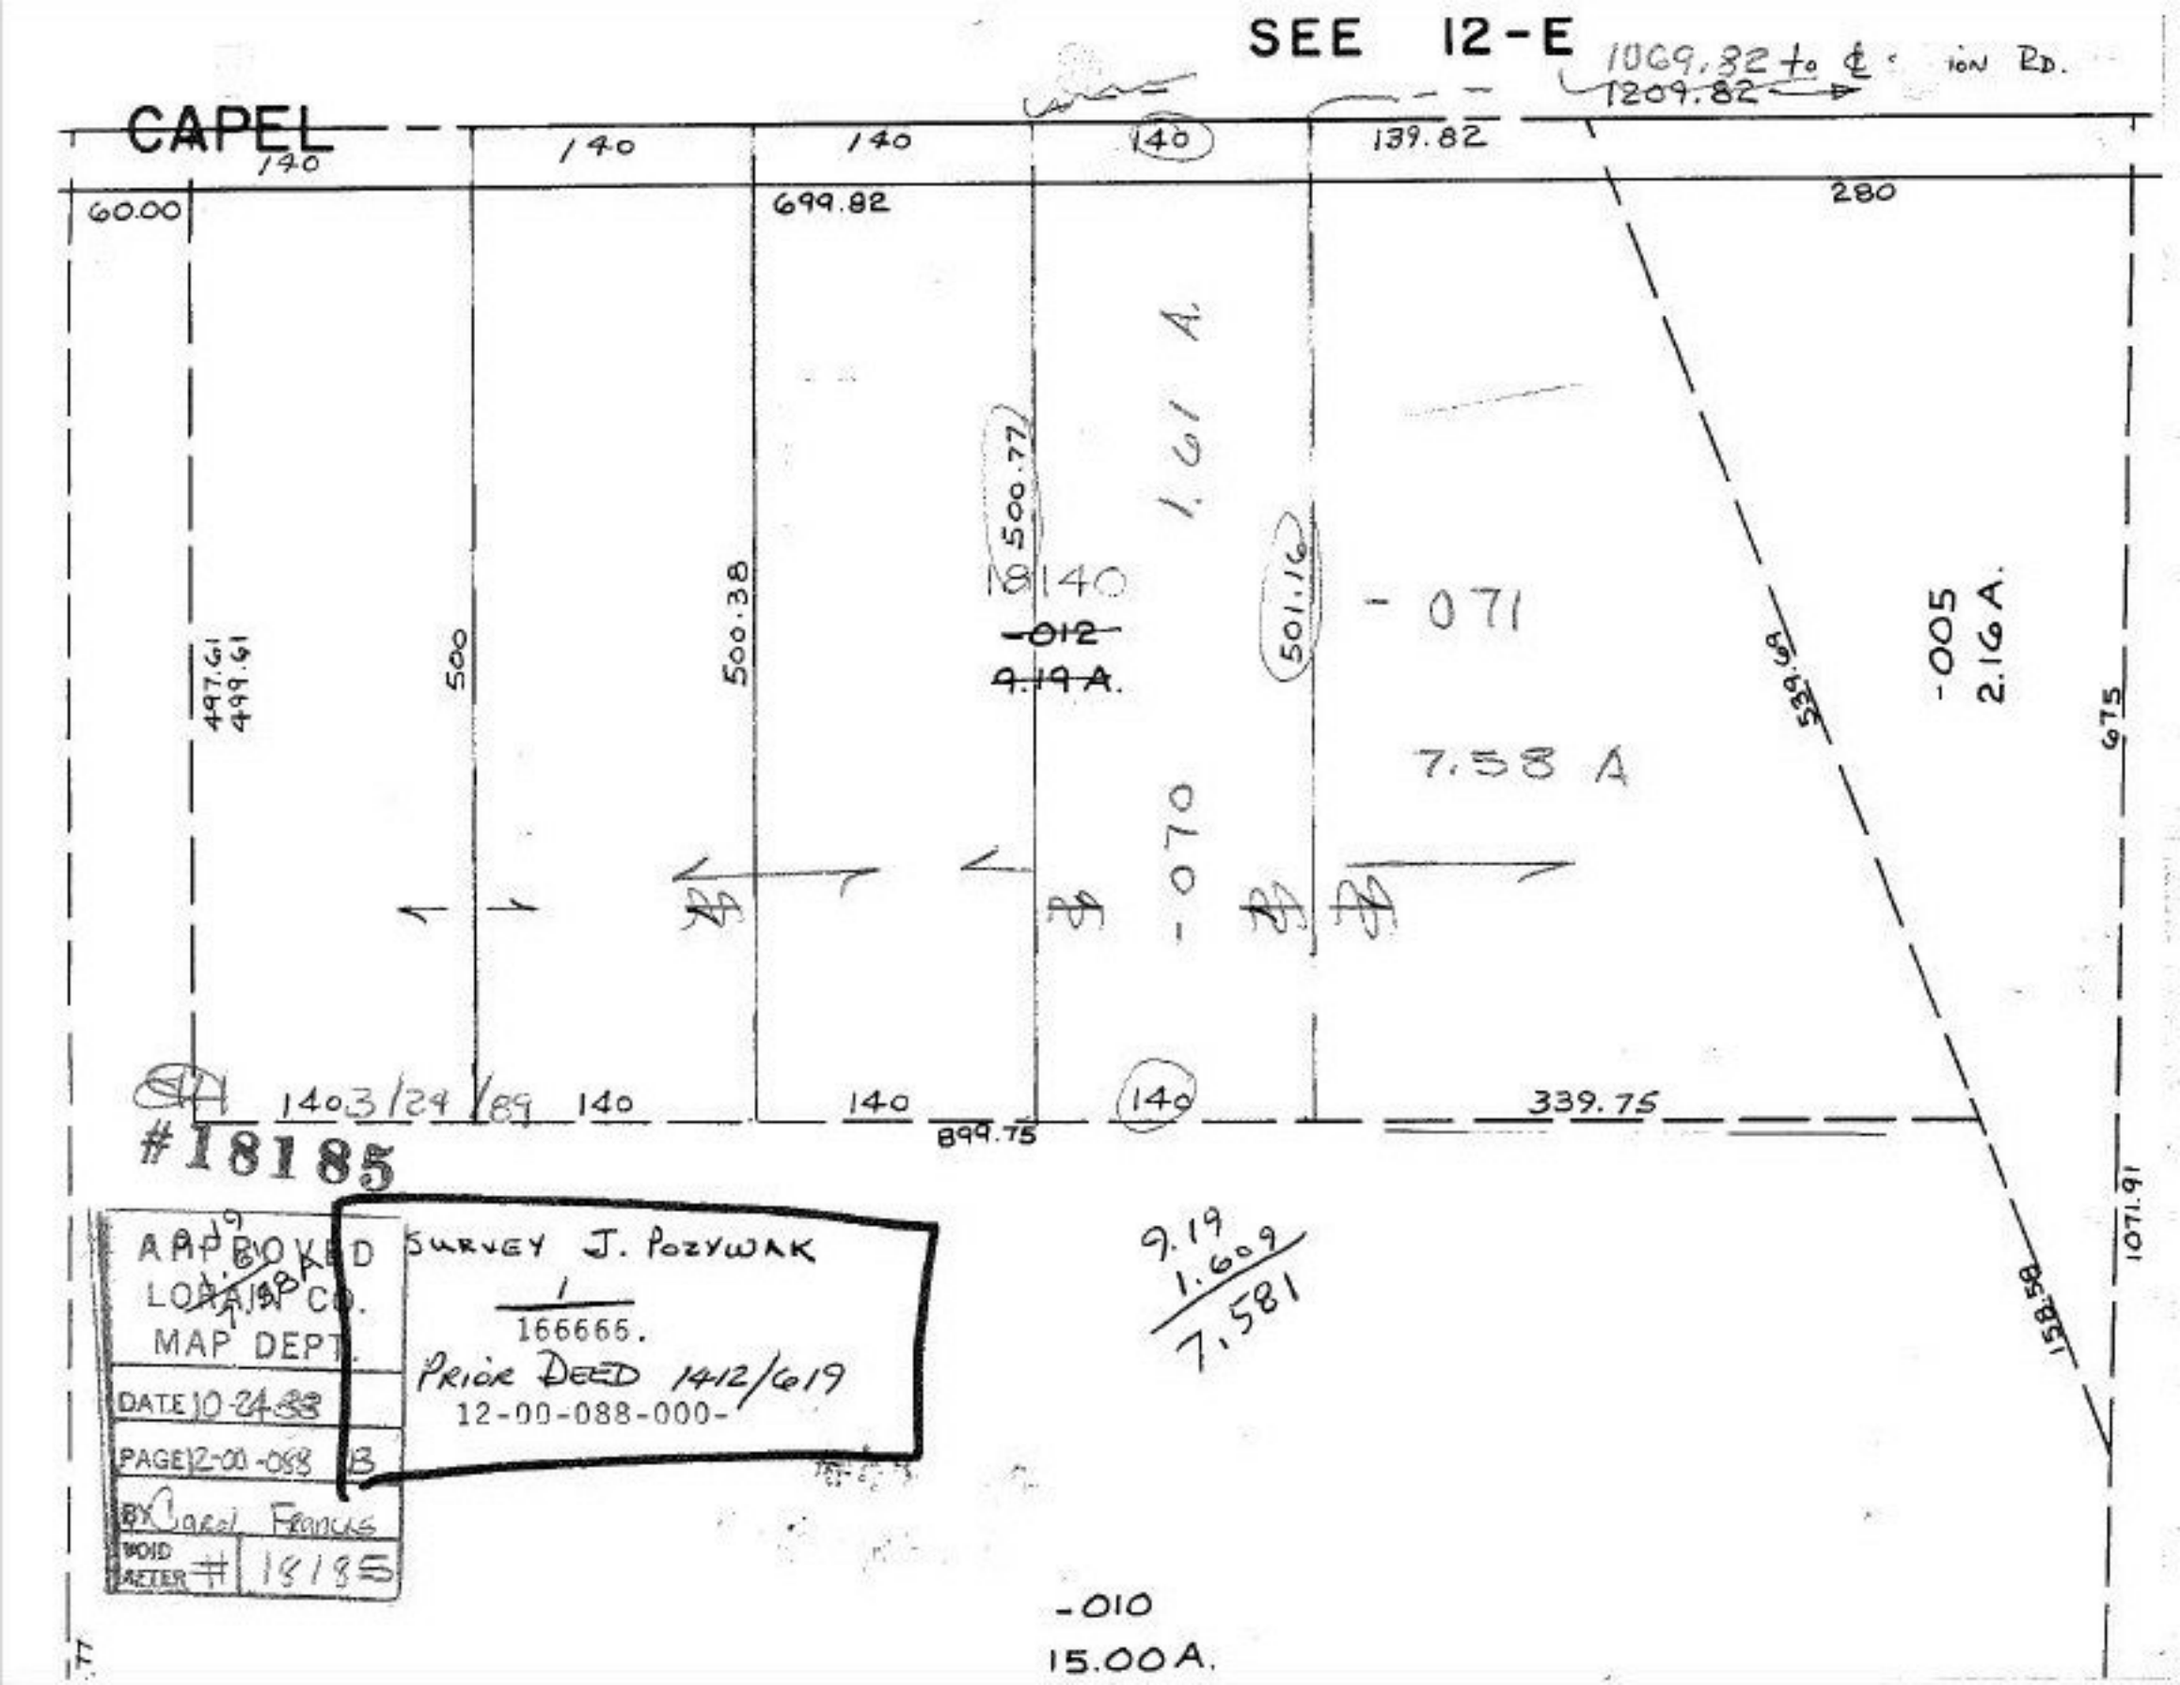
SEE 12-E
1069.82 ± to ℄ ion Rd.
1209.82
CAPEL
140
140
140
140
139.82
60.00
699.82
280
497.61
499.61
500
500.38
500.77
140
-012
9.19A.
1.61 A.
501.16
-071
-005
2.16A.
539.69
675
-070
7.58 A
140
3/24/89
140
140
140
339.75
899.75
1071.91
158.50
#18185
APPROVED
MAP DEPT.
DATE 10-24-88
PAGE 12-00-088 B
BY Carol Francis
VOID AFTER # 18185
SURVEY J. POZYWAK
1
166666.
PRIOR DEED 1412/619
12-00-088-000-
9.19
1.609
7,581
-010
15.00A.