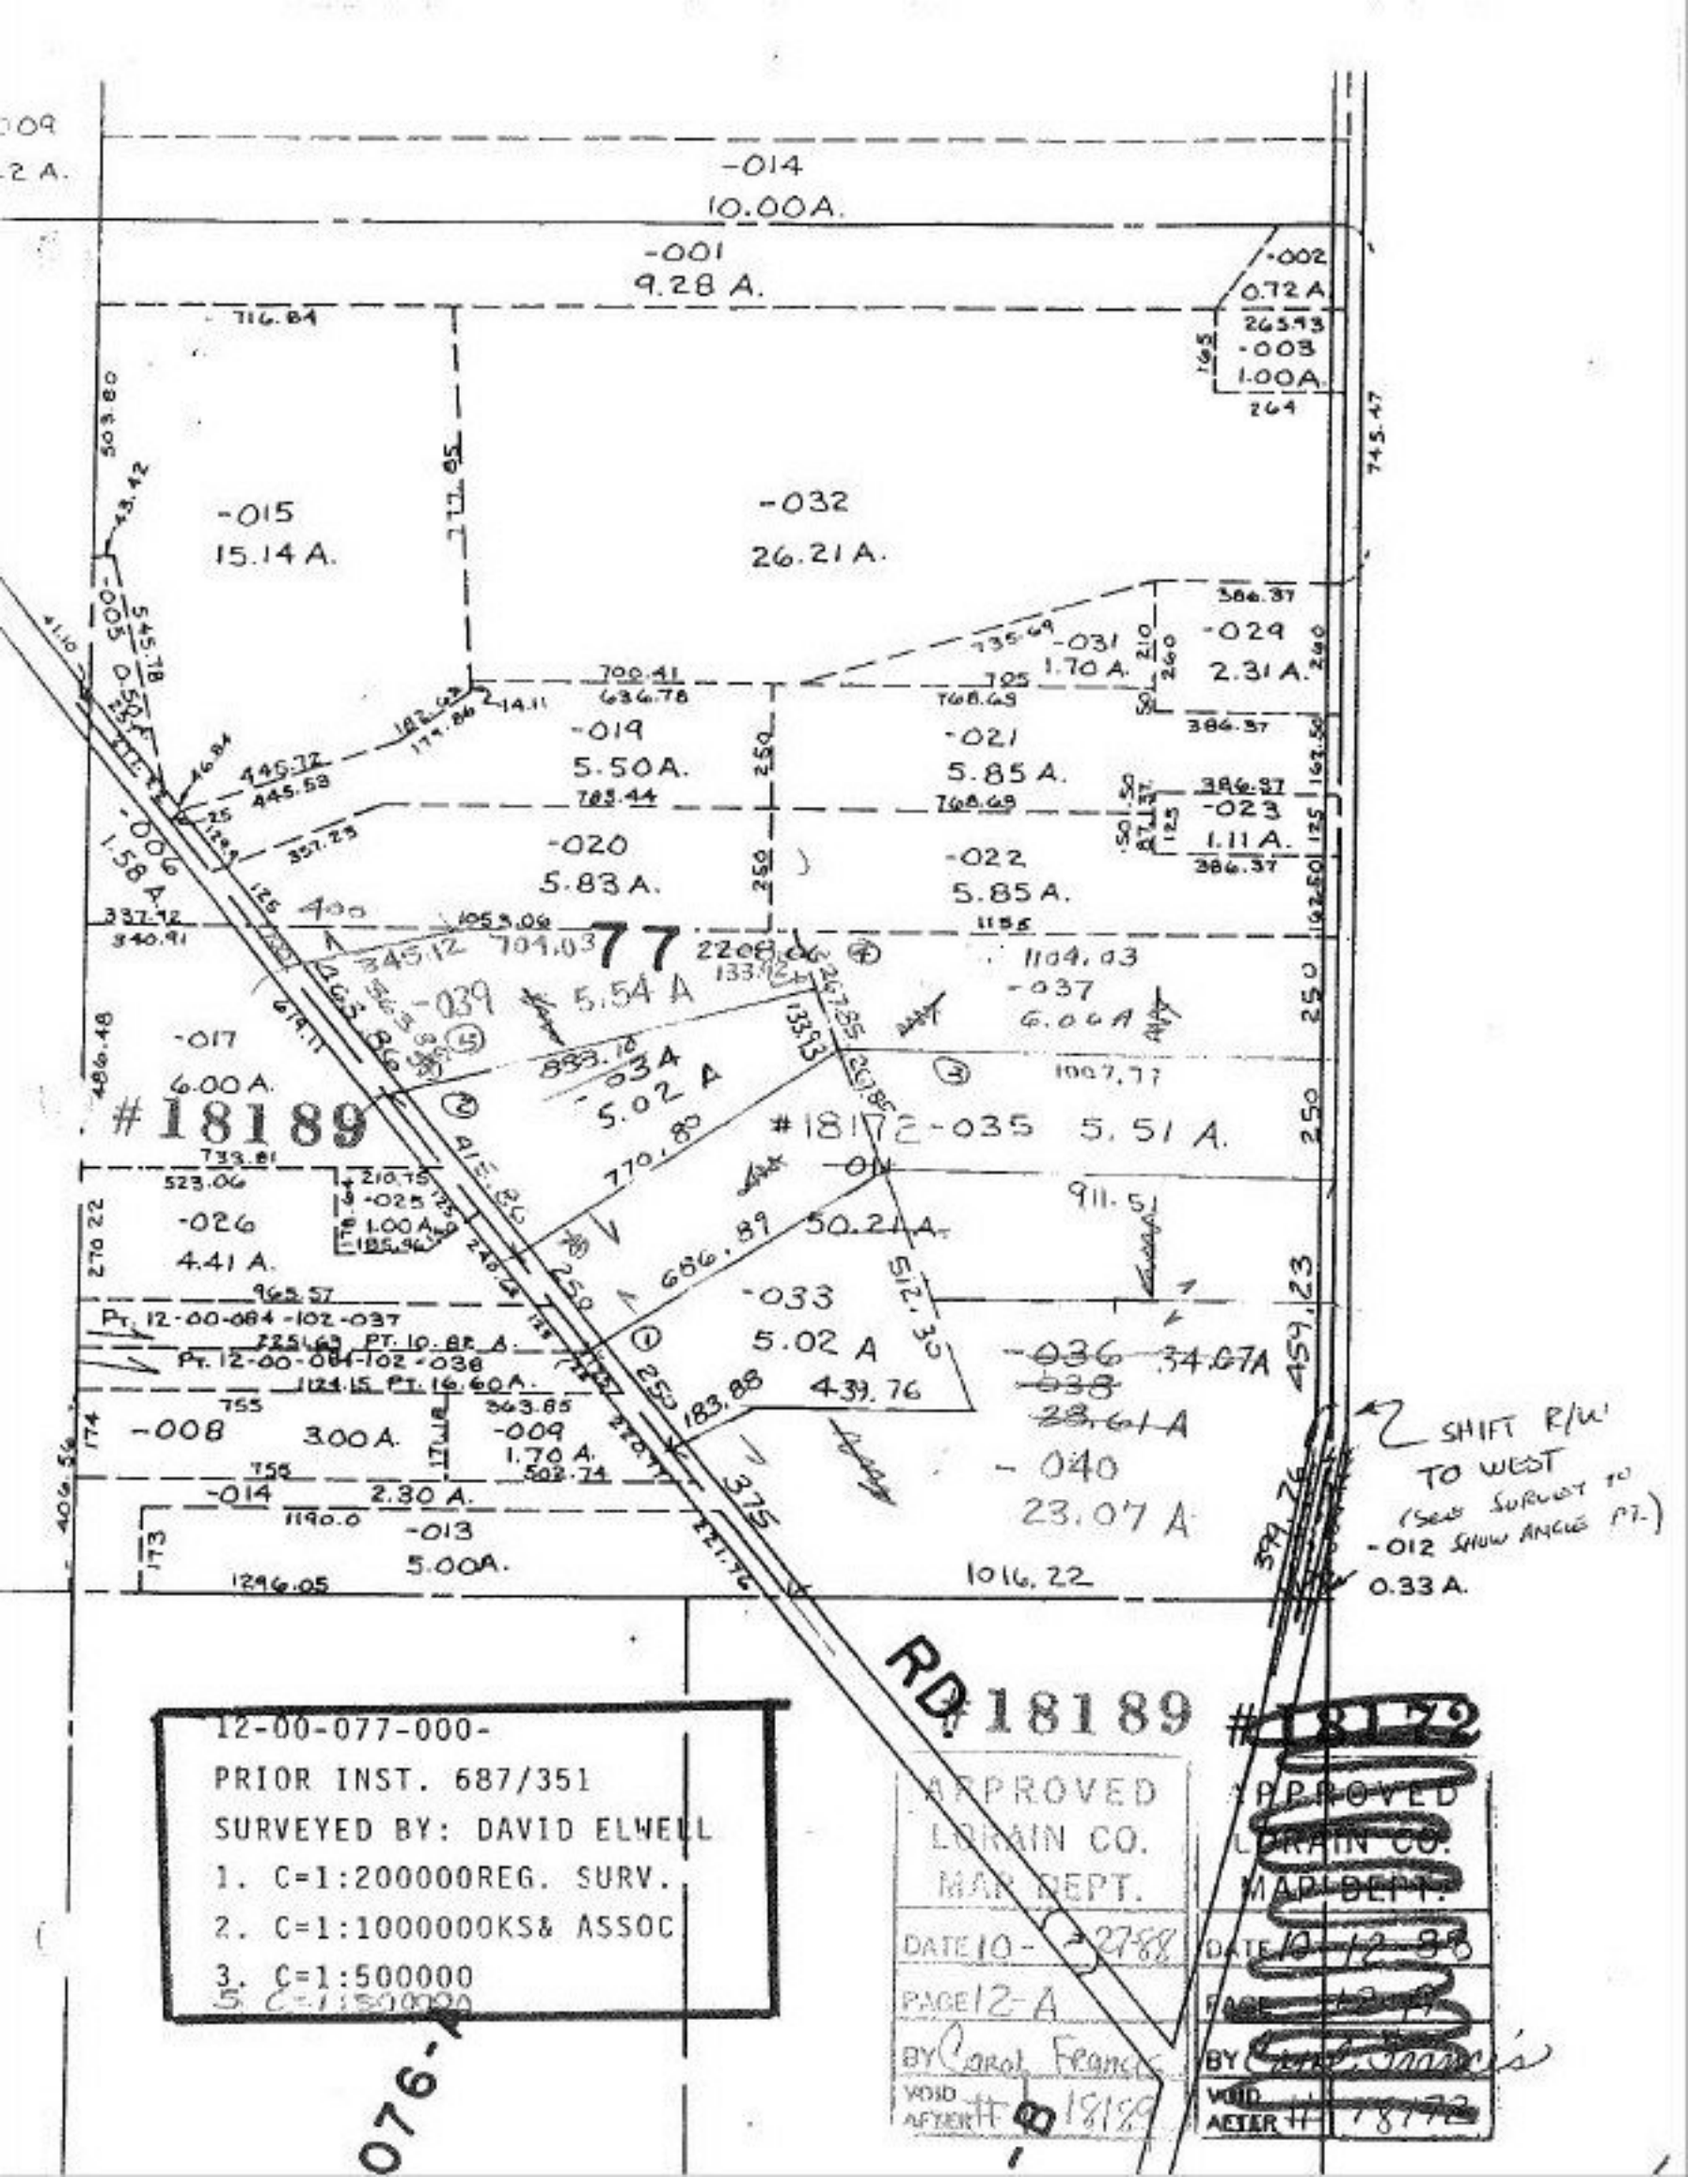
-014
10.00A.
-001
9.28 A.
-002
0.72 A
-003
1.00A.
-015
15.14 A.
-032
26.21 A.
-031
1.70 A.
-029
2.31 A.
-019
5.50A.
-021
5.85 A.
-020
5.83 A.
-022
5.85 A.
-023
1.11 A.
-006
1.58 A
77
-039
5.54 A
-037
6.06 A
-017
6.00A.
#18189
-034
5.02 A
#18172-035
5.51 A.
-026
4.41 A.
-025
1.00A.
50.21 A.
-033
5.02 A
-036
-038
-040
23.07 A
-008
3.00A.
-009
1.70 A.
-014
2.30 A.
-013
5.00A.
SHIFT R/W TO WEST
(SEE SURVEY TO -012 SHOW ANGLE PT.)
0.33 A.
RD. 18189
#18172
12-00-077-000-
PRIOR INST. 687/351
SURVEYED BY: DAVID ELWELL
1. C=1:200000REG. SURV.
2. C=1:1000000KS& ASSOC
3. C=1:500000
5. C=1:500000
APPROVED
LORAIN CO.
MAP DEPT.
DATE 10-27-88
PAGE 12-A
BY Carol Francis
VOID AFTER # 18189
APPROVED
LORAIN CO.
MAP DEPT.
DATE 10-12-88
VOID AFTER # 18172