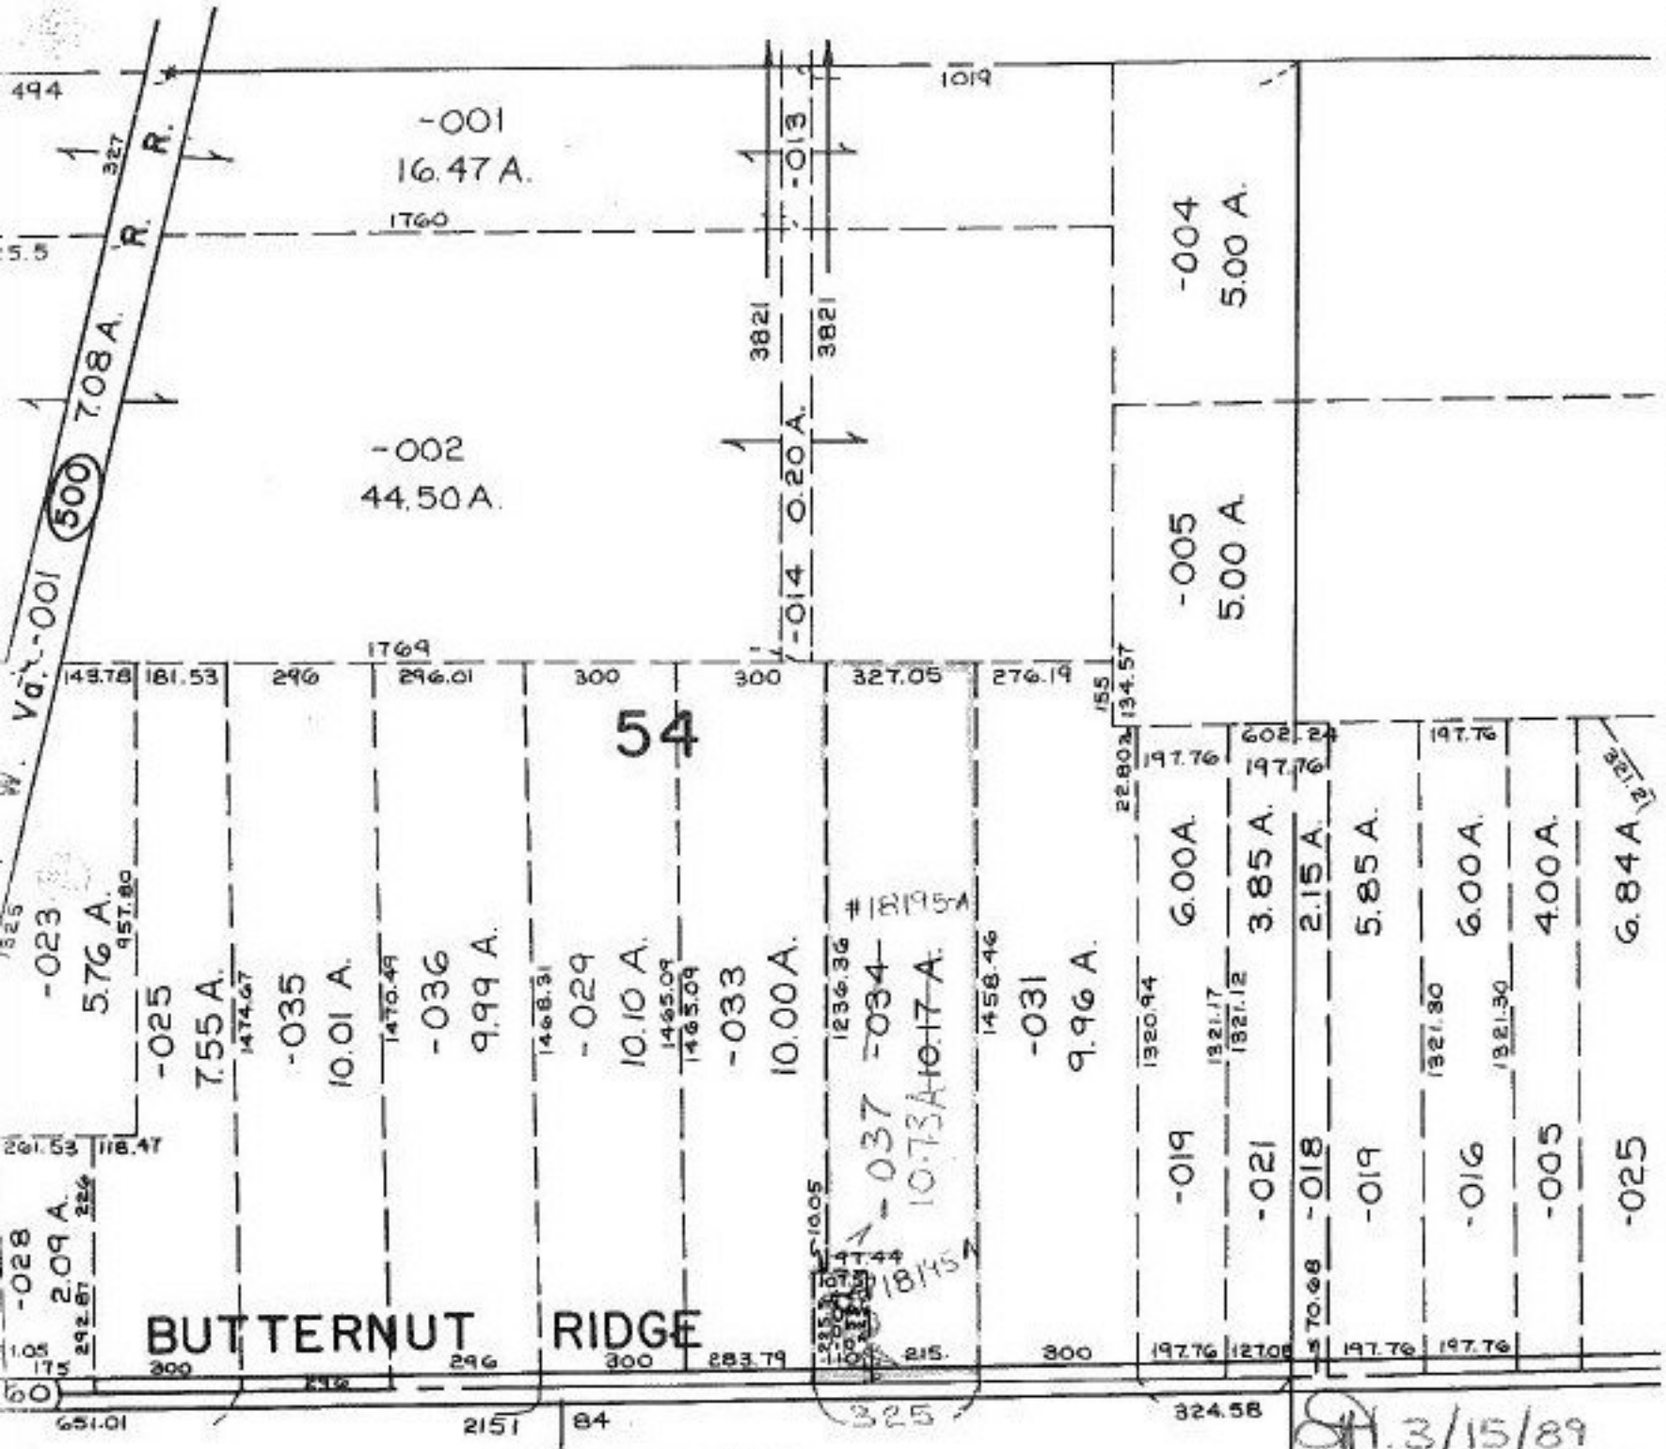

COMBINATION

09-00-054-000-

#18195-A

APPROVED
LORAIN CO.
MAP DEPT.

DATE 11-2-88
PAGE 9-F
BY Carol-Francis
VOID AFTER # 18195A