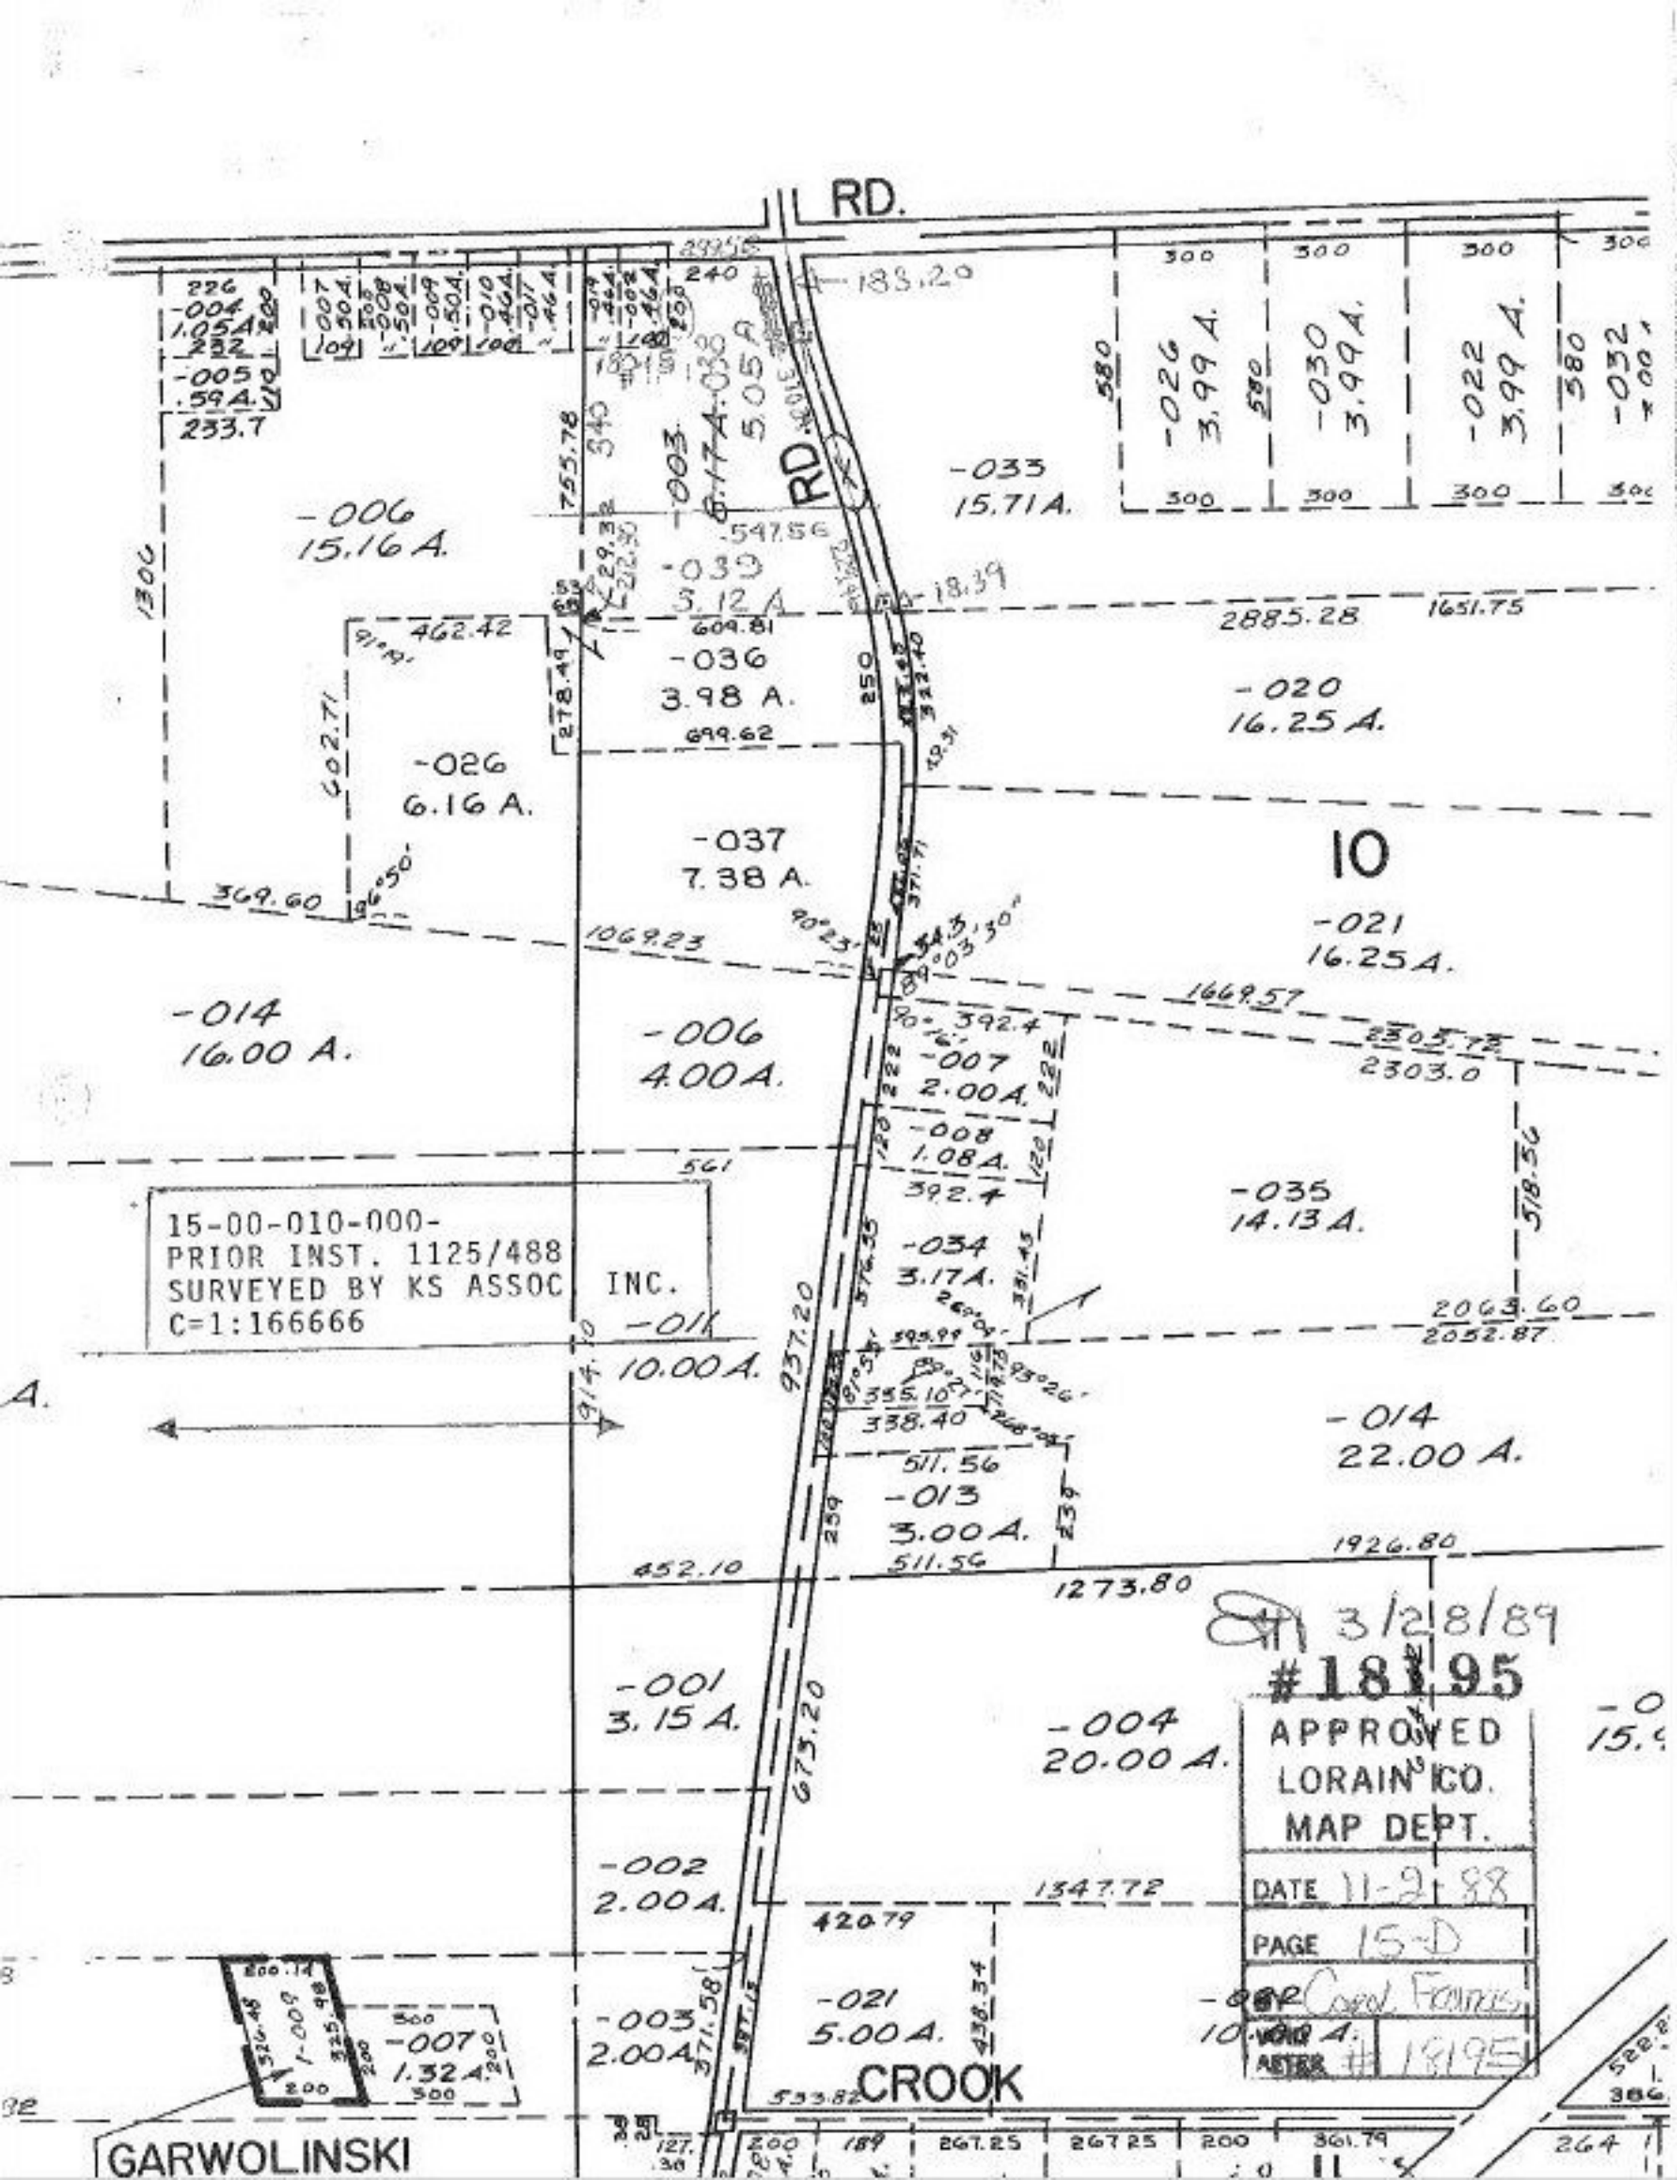
RD.
RD.
-033
15.71A.
-026
3.99 A.
-030
3.99A.
-022
3.99 A.
-032
-006
15.16 A.
-039
3.12 A.
-036
3.98 A.
-026
6.16 A.
-037
7.38 A.
-020
16.25 A.
10
-021
16.25A.
-014
16.00 A.
-006
4.00A.
-007
2.00A.
-008
1.08A.
-035
14.13A.
-034
3.17A.
15-00-010-000-
PRIOR INST. 1125/488
SURVEYED BY KS ASSOC INC.
C=1:166666
-011
10.00A.
-014
22.00 A.
-013
3.00A.
-001
3.15A.
-004
20.00A.
-002
2.00A.
-003
2.00A.
-021
5.00A.
-007
1.32A.
CROOK
GARWOLINSKI
3/28/89
#18195
APPROVED
LORAIN CO.
MAP DEPT.
DATE 11-2-88
PAGE 15-D
Cord. Forms
#18195