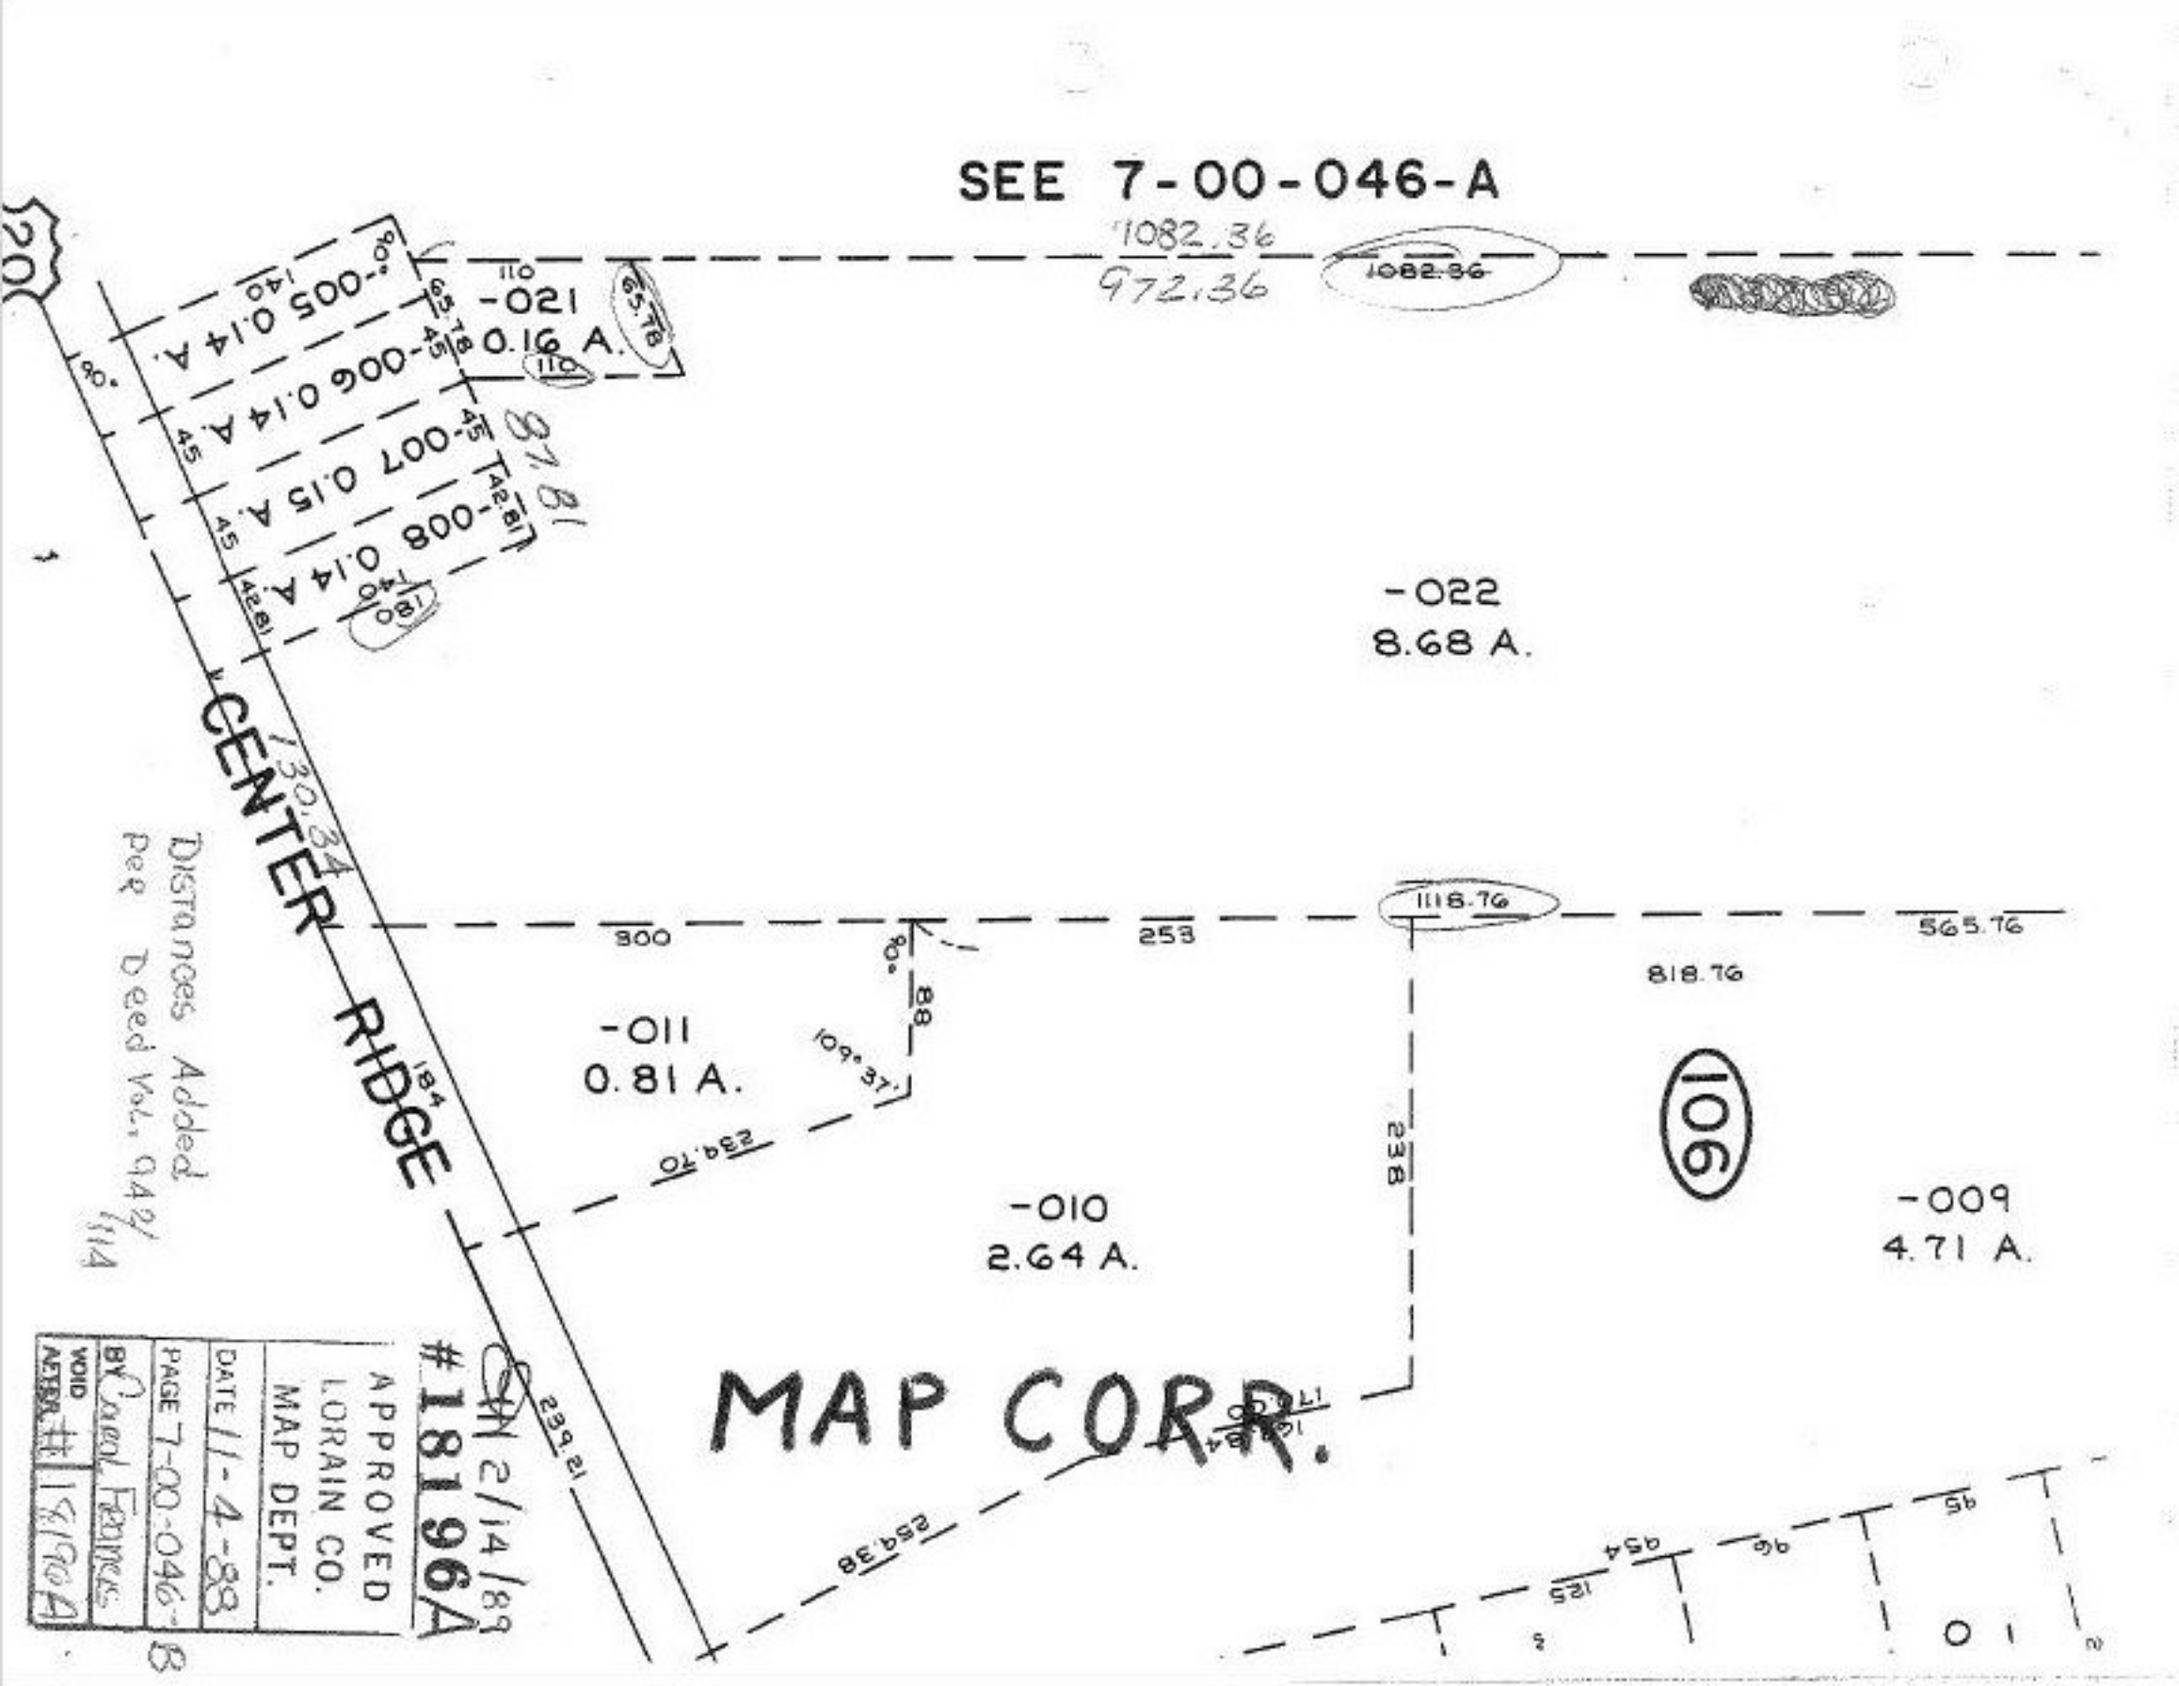
SEE 7-00-046-A
1082.36
972.36
1082.86
-021
0.16 A.
-022
8.68 A.
CENTER RIDGE
130.34
Distances Added
Per Deed Vol. 942
114
-011
0.81 A.
-010
2.64 A.
-009
4.71 A.
818.76
565.76
1118.76
253
238
234.70
254.38
239.21
MAP CORR.
APPROVED
LORAIN CO.
MAP DEPT.
DATE 11-4-88
PAGE 7-00-046-B
BY Carol Frames
VOID
AFFD.
#18196A
2/14/89