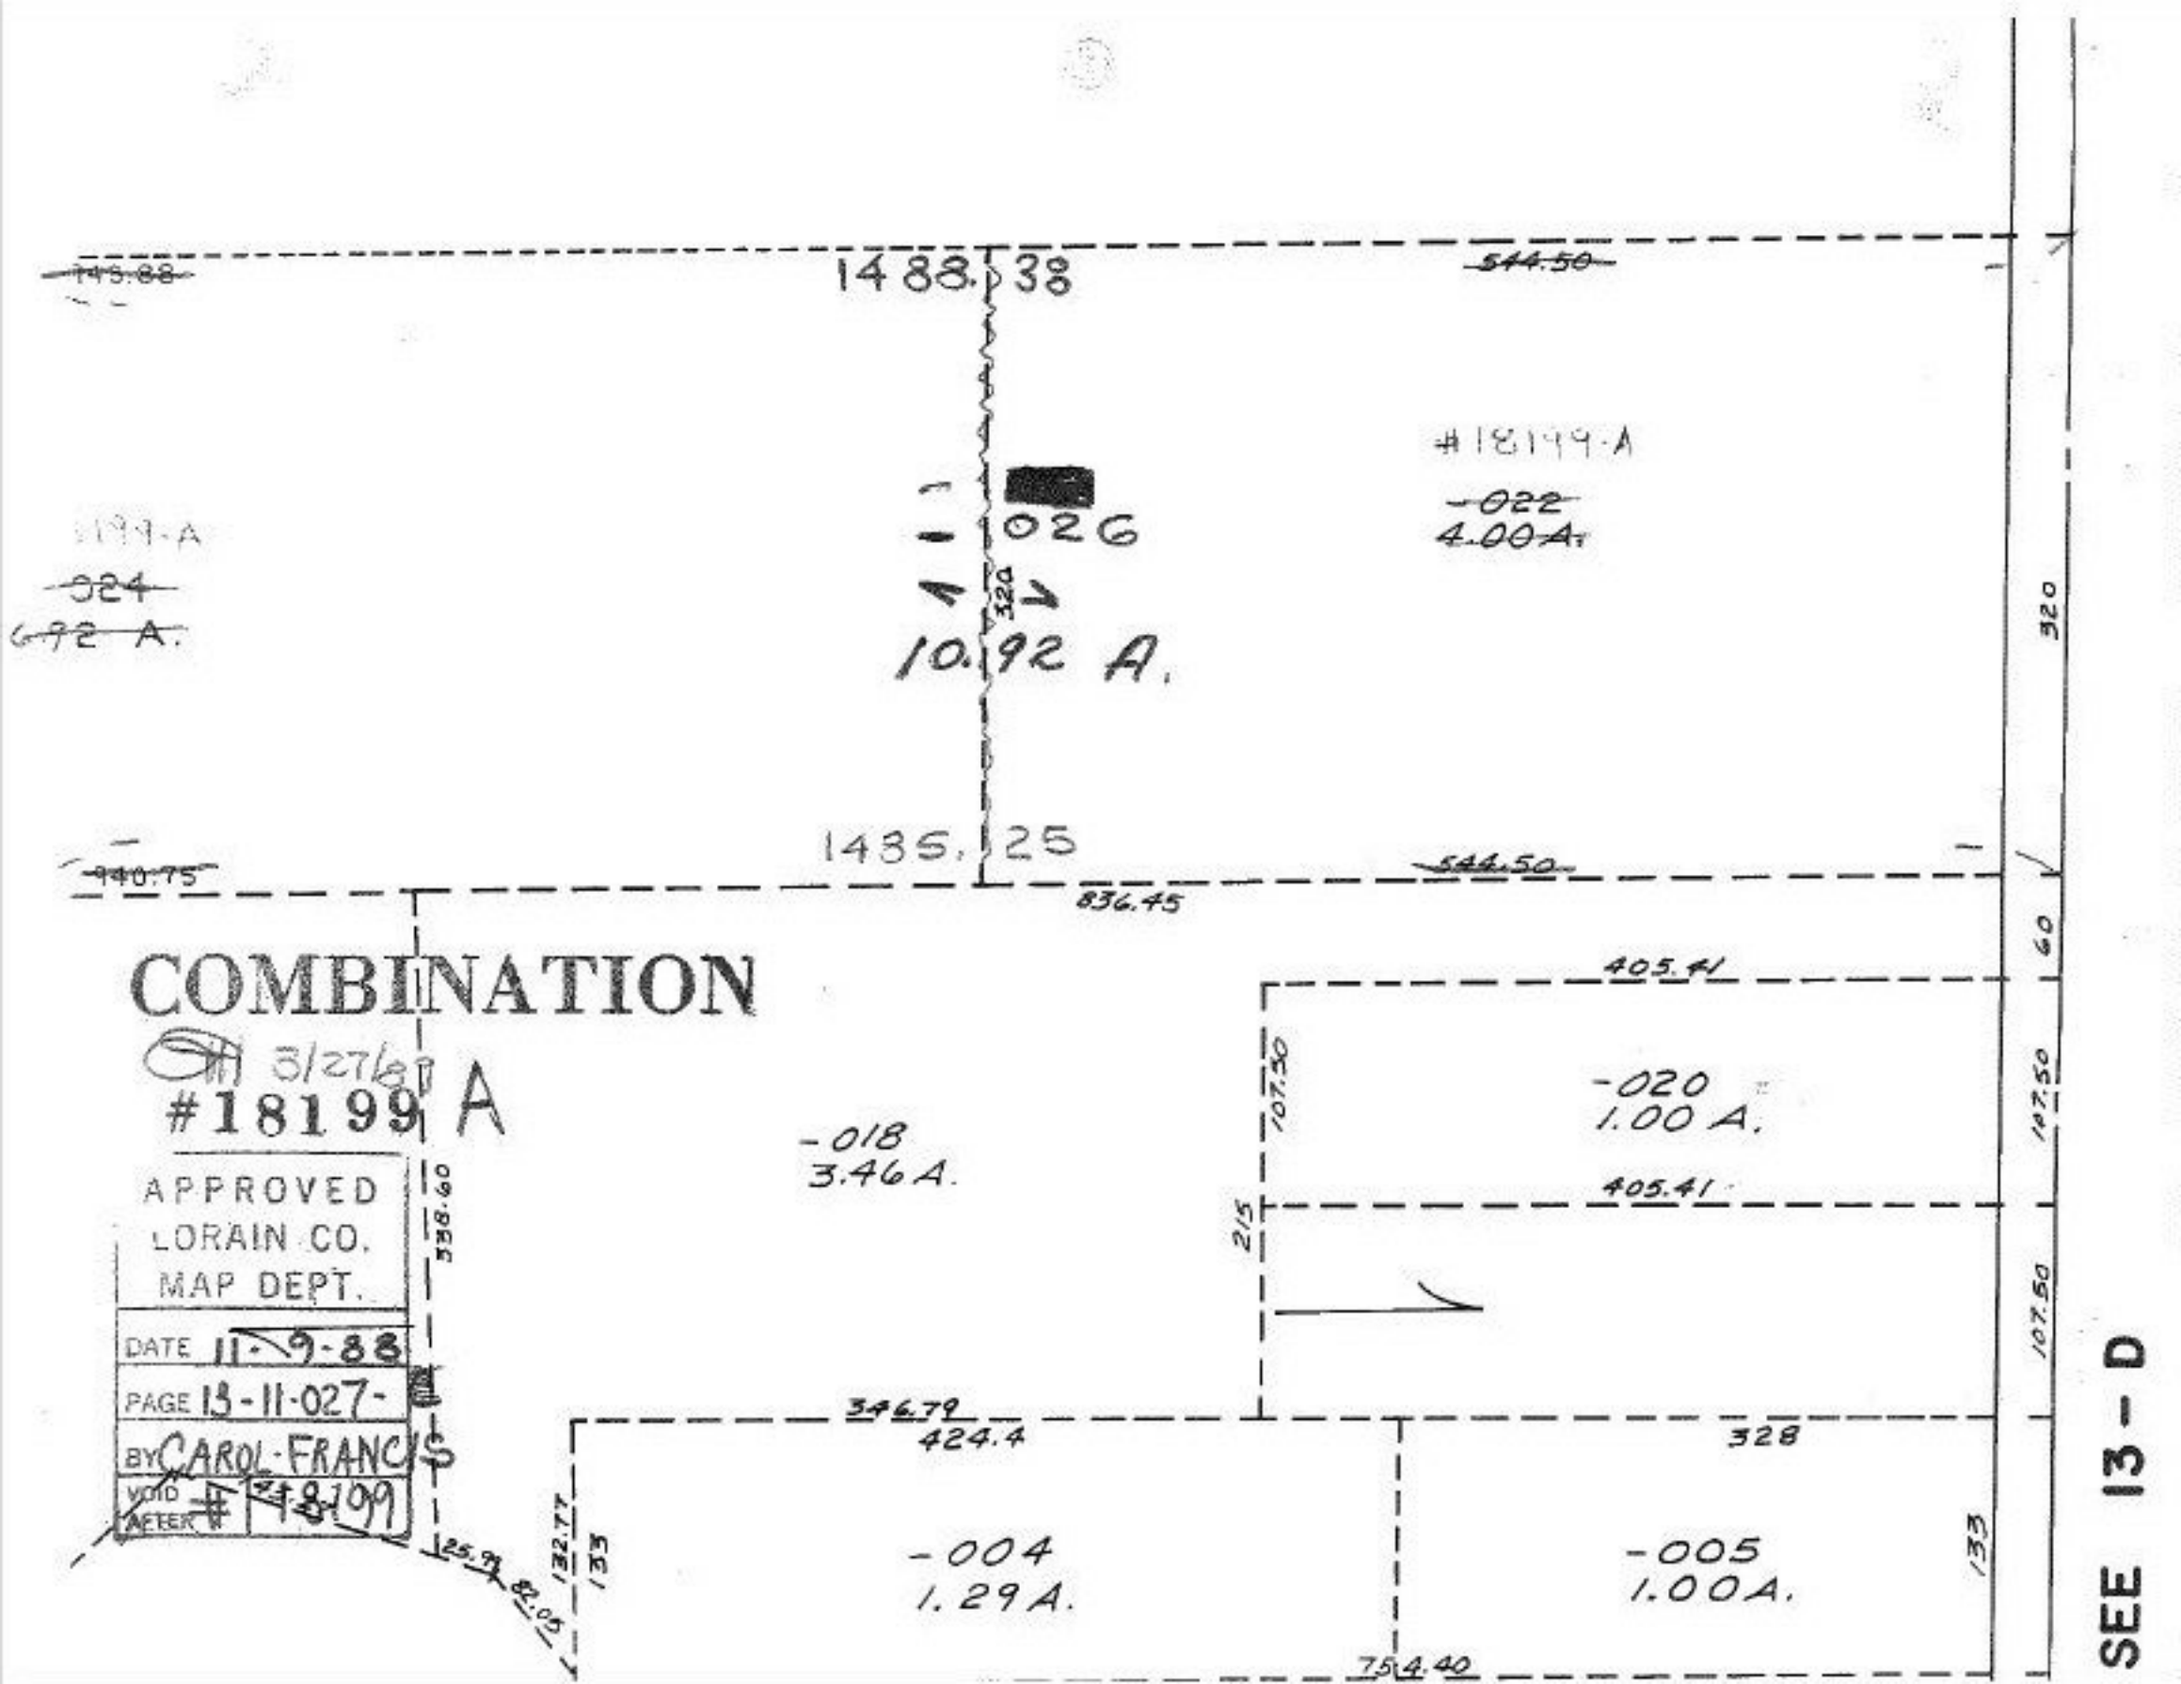
145.88
1488.38
544.50
#18199-A
-022
4.00A.
199-A
-024
6.92 A.
-026
10.92 A.
320
320
1485.25
940.75
544.50
836.45
COMBINATION
3/27/87
#18199 A
APPROVED
LORAIN CO.
MAP DEPT.
DATE 11-9-88
PAGE 13-11-027-
BY CAROL-FRANCIS
VOID AFTER # 18199
-018
3.46 A.
405.41
107.50
-020
1.00 A.
405.41
60
107.50
215
107.50
338.60
346.79
424.4
328
125.97
132.77
135
-004
1.29 A.
-005
1.00A.
133
754.40
SEE 13-D