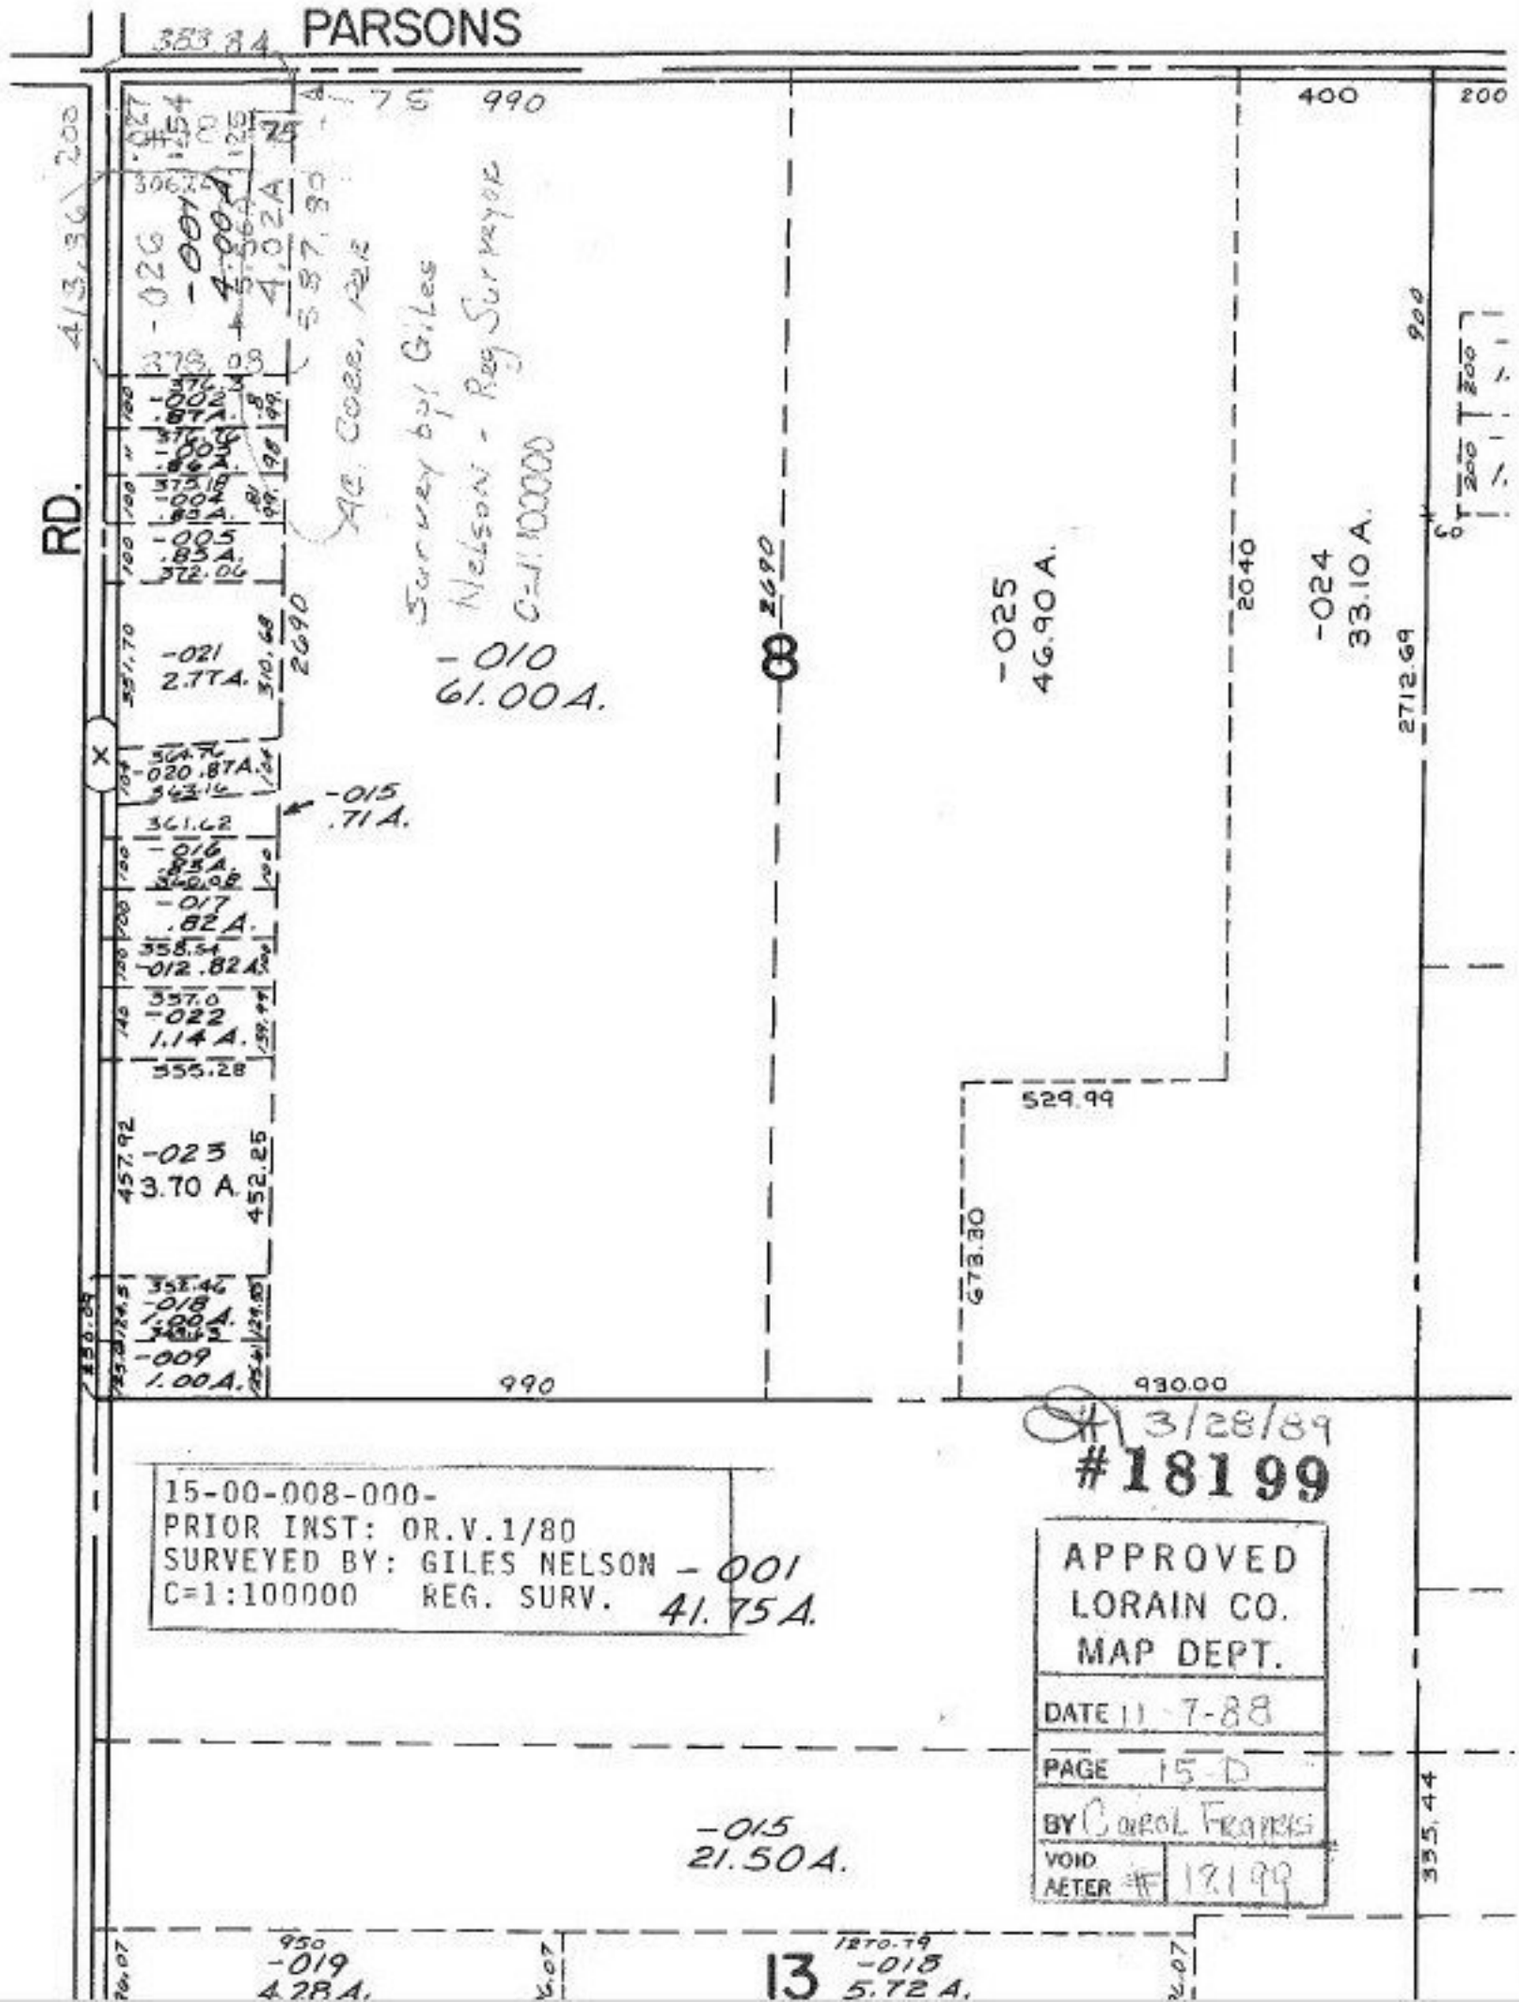
PARSONS
RD.
383.84
990
400
200
413.36
200
-001
4.00A.
4.02A
587.30
Surveyed by Giles
Nelson - Reg Surveyor
C=1:100000
-010
61.00A.
-025
46.90 A.
-024
33.10 A.
2040
2690
2712.69
900
-021
2.77A.
-020 .87A.
-015
.71 A.
-016
.85A.
-017
.82A.
-012 .82A.
-022
1.14 A.
-023
3.70 A.
-018
1.00 A.
-009
1.00A.
529.99
673.30
930.00
990
15-00-008-000-
PRIOR INST: OR.V.1/80
SURVEYED BY: GILES NELSON -001
C=1:100000 REG. SURV. 41.75A.
3/28/89
#18199
APPROVED
LORAIN CO.
MAP DEPT.
DATE 11-7-88
PAGE 15-D
BY Carol Frames
VOID AFTER # 18199
-015
21.50A.
335.44
950
-019
4.28A.
13
1270.79
-018
5.72 A.