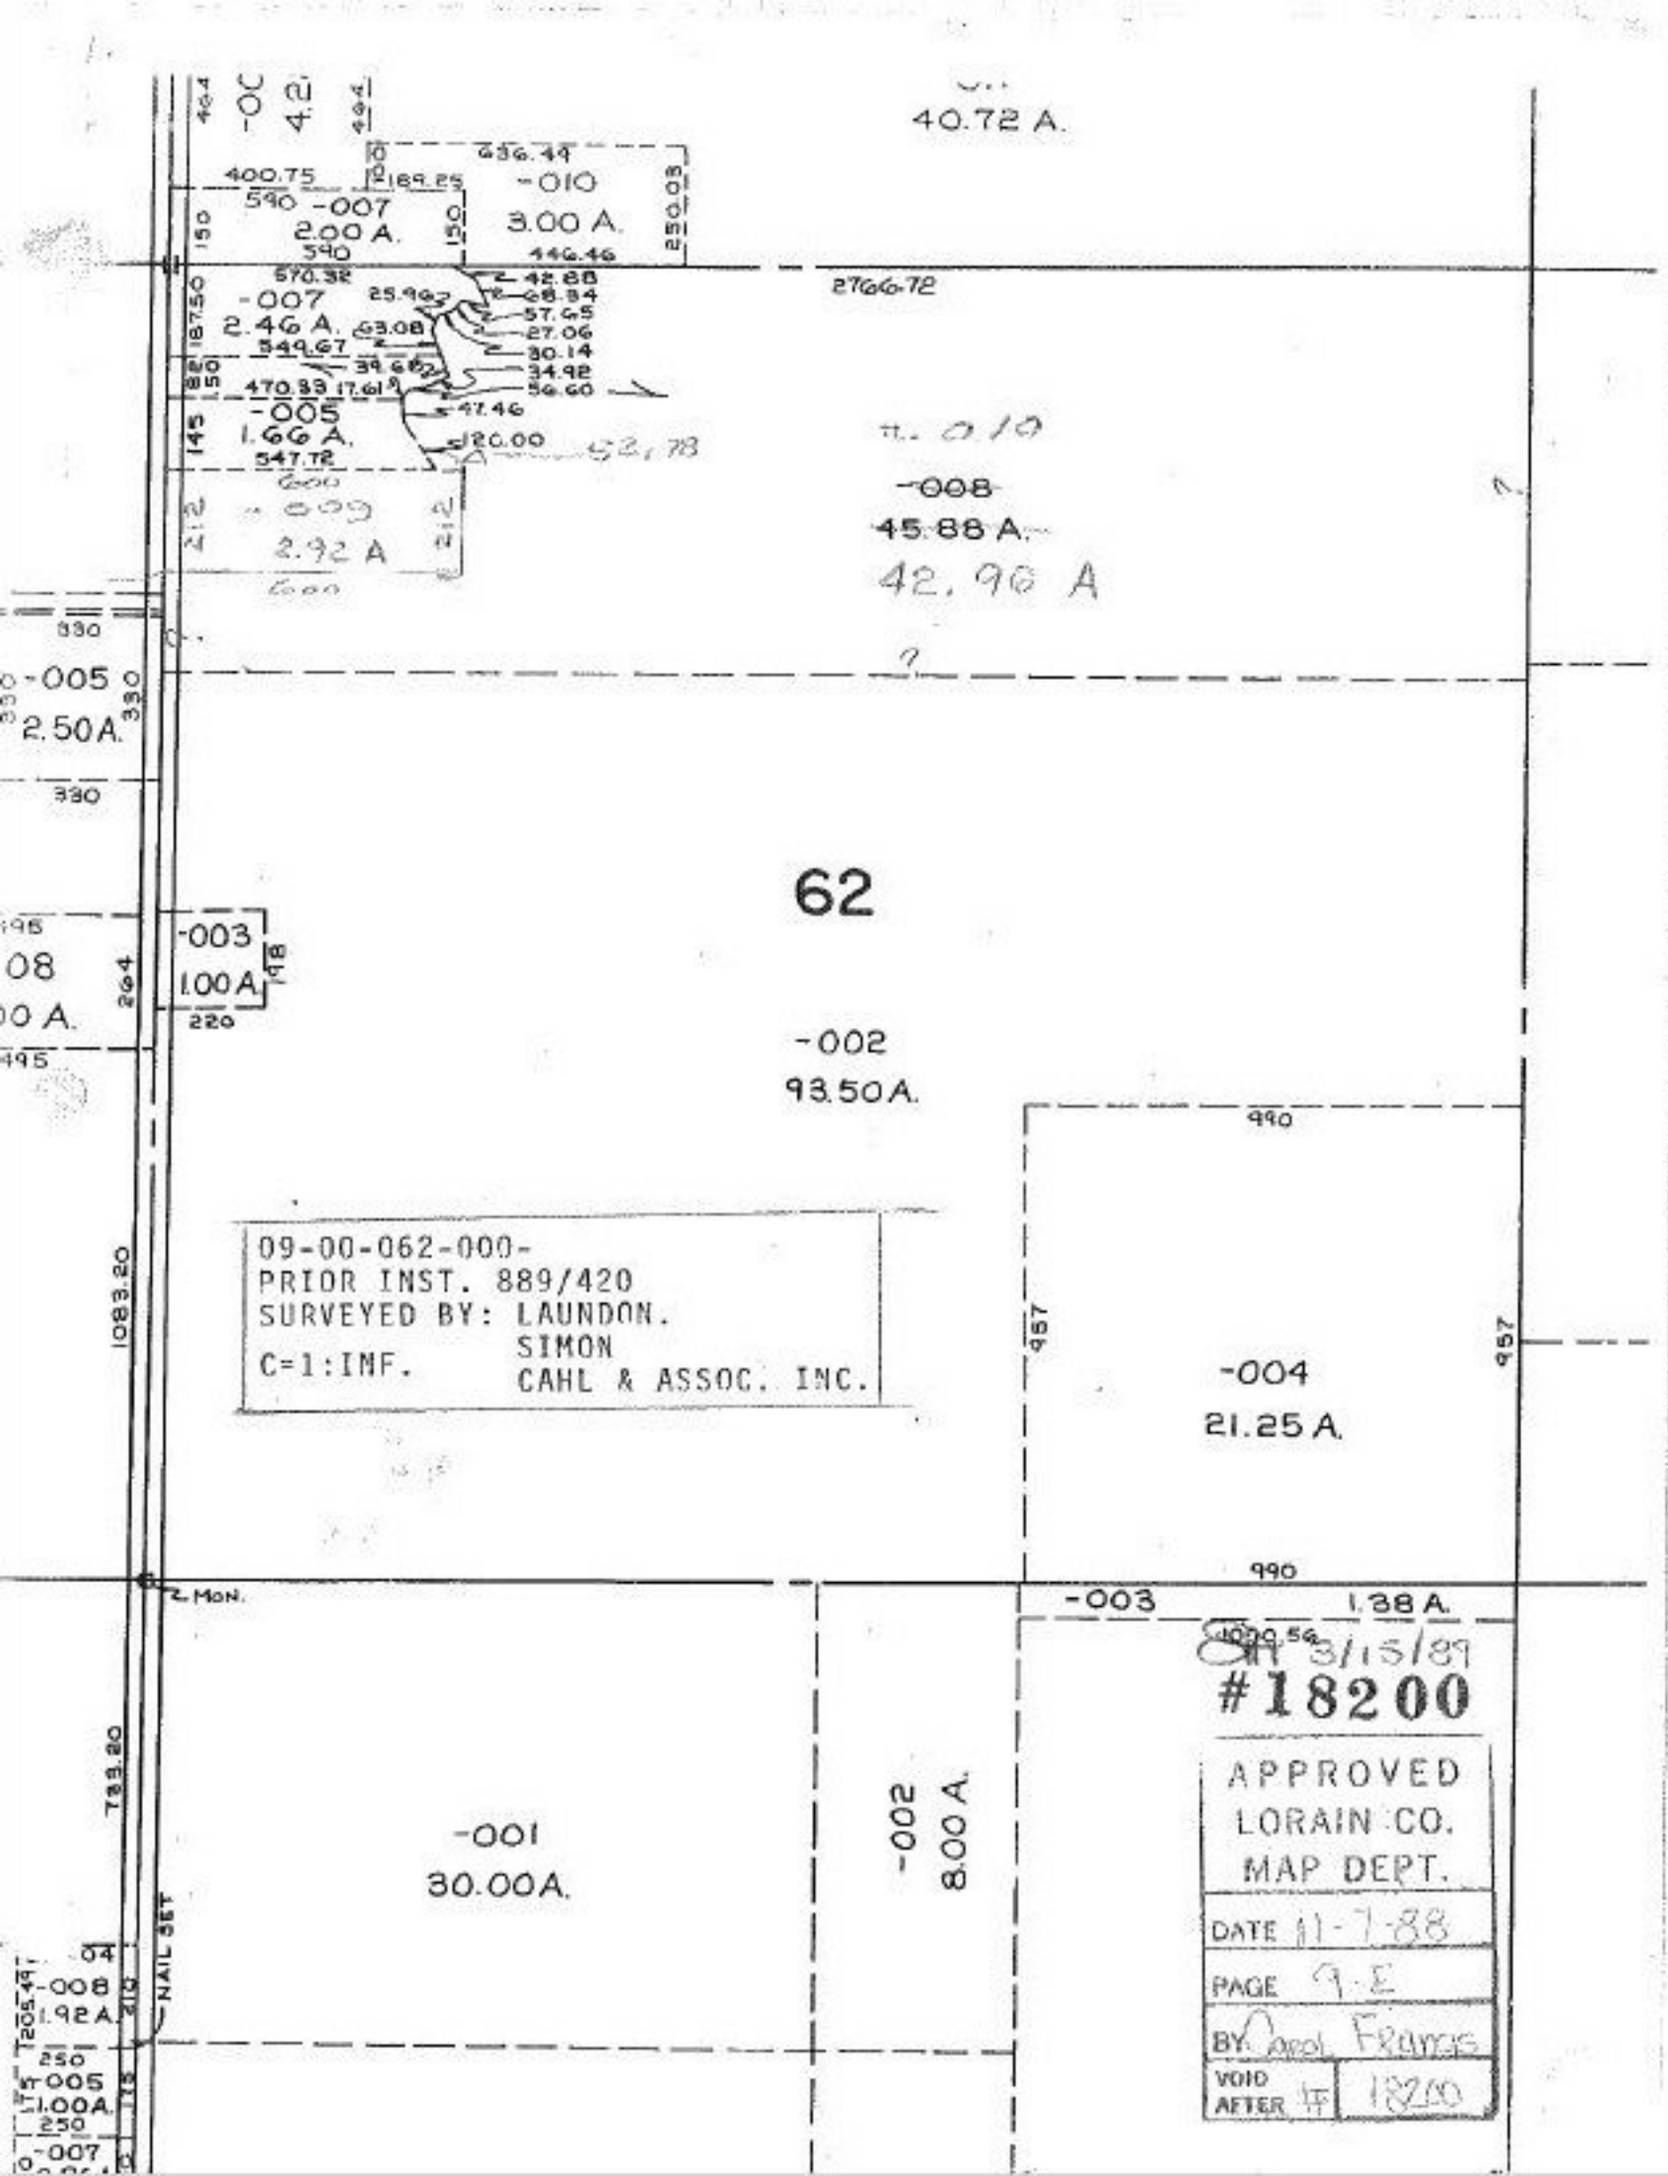
40.72 A.
-010
3.00 A.
-007
2.00 A.
-007
2.46 A.
-005
1.66 A.
-009
2.92 A
2766.72
-008
45.88 A.
42.96 A
-005
2.50 A.
62
-003
1.00 A.
-002
93.50 A.
09-00-062-000-
PRIOR INST. 889/420
SURVEYED BY: LAUNDON.
SIMON
C=1:INF.
CAHL & ASSOC. INC.
-004
21.25 A.
-003
1.38 A.
-001
30.00 A.
-002
8.00 A.
NAIL SET
#18200
APPROVED
LORAIN CO.
MAP DEPT.
DATE 11-7-88
PAGE 9-E
BY Carol Francis
VOID AFTER # 18200