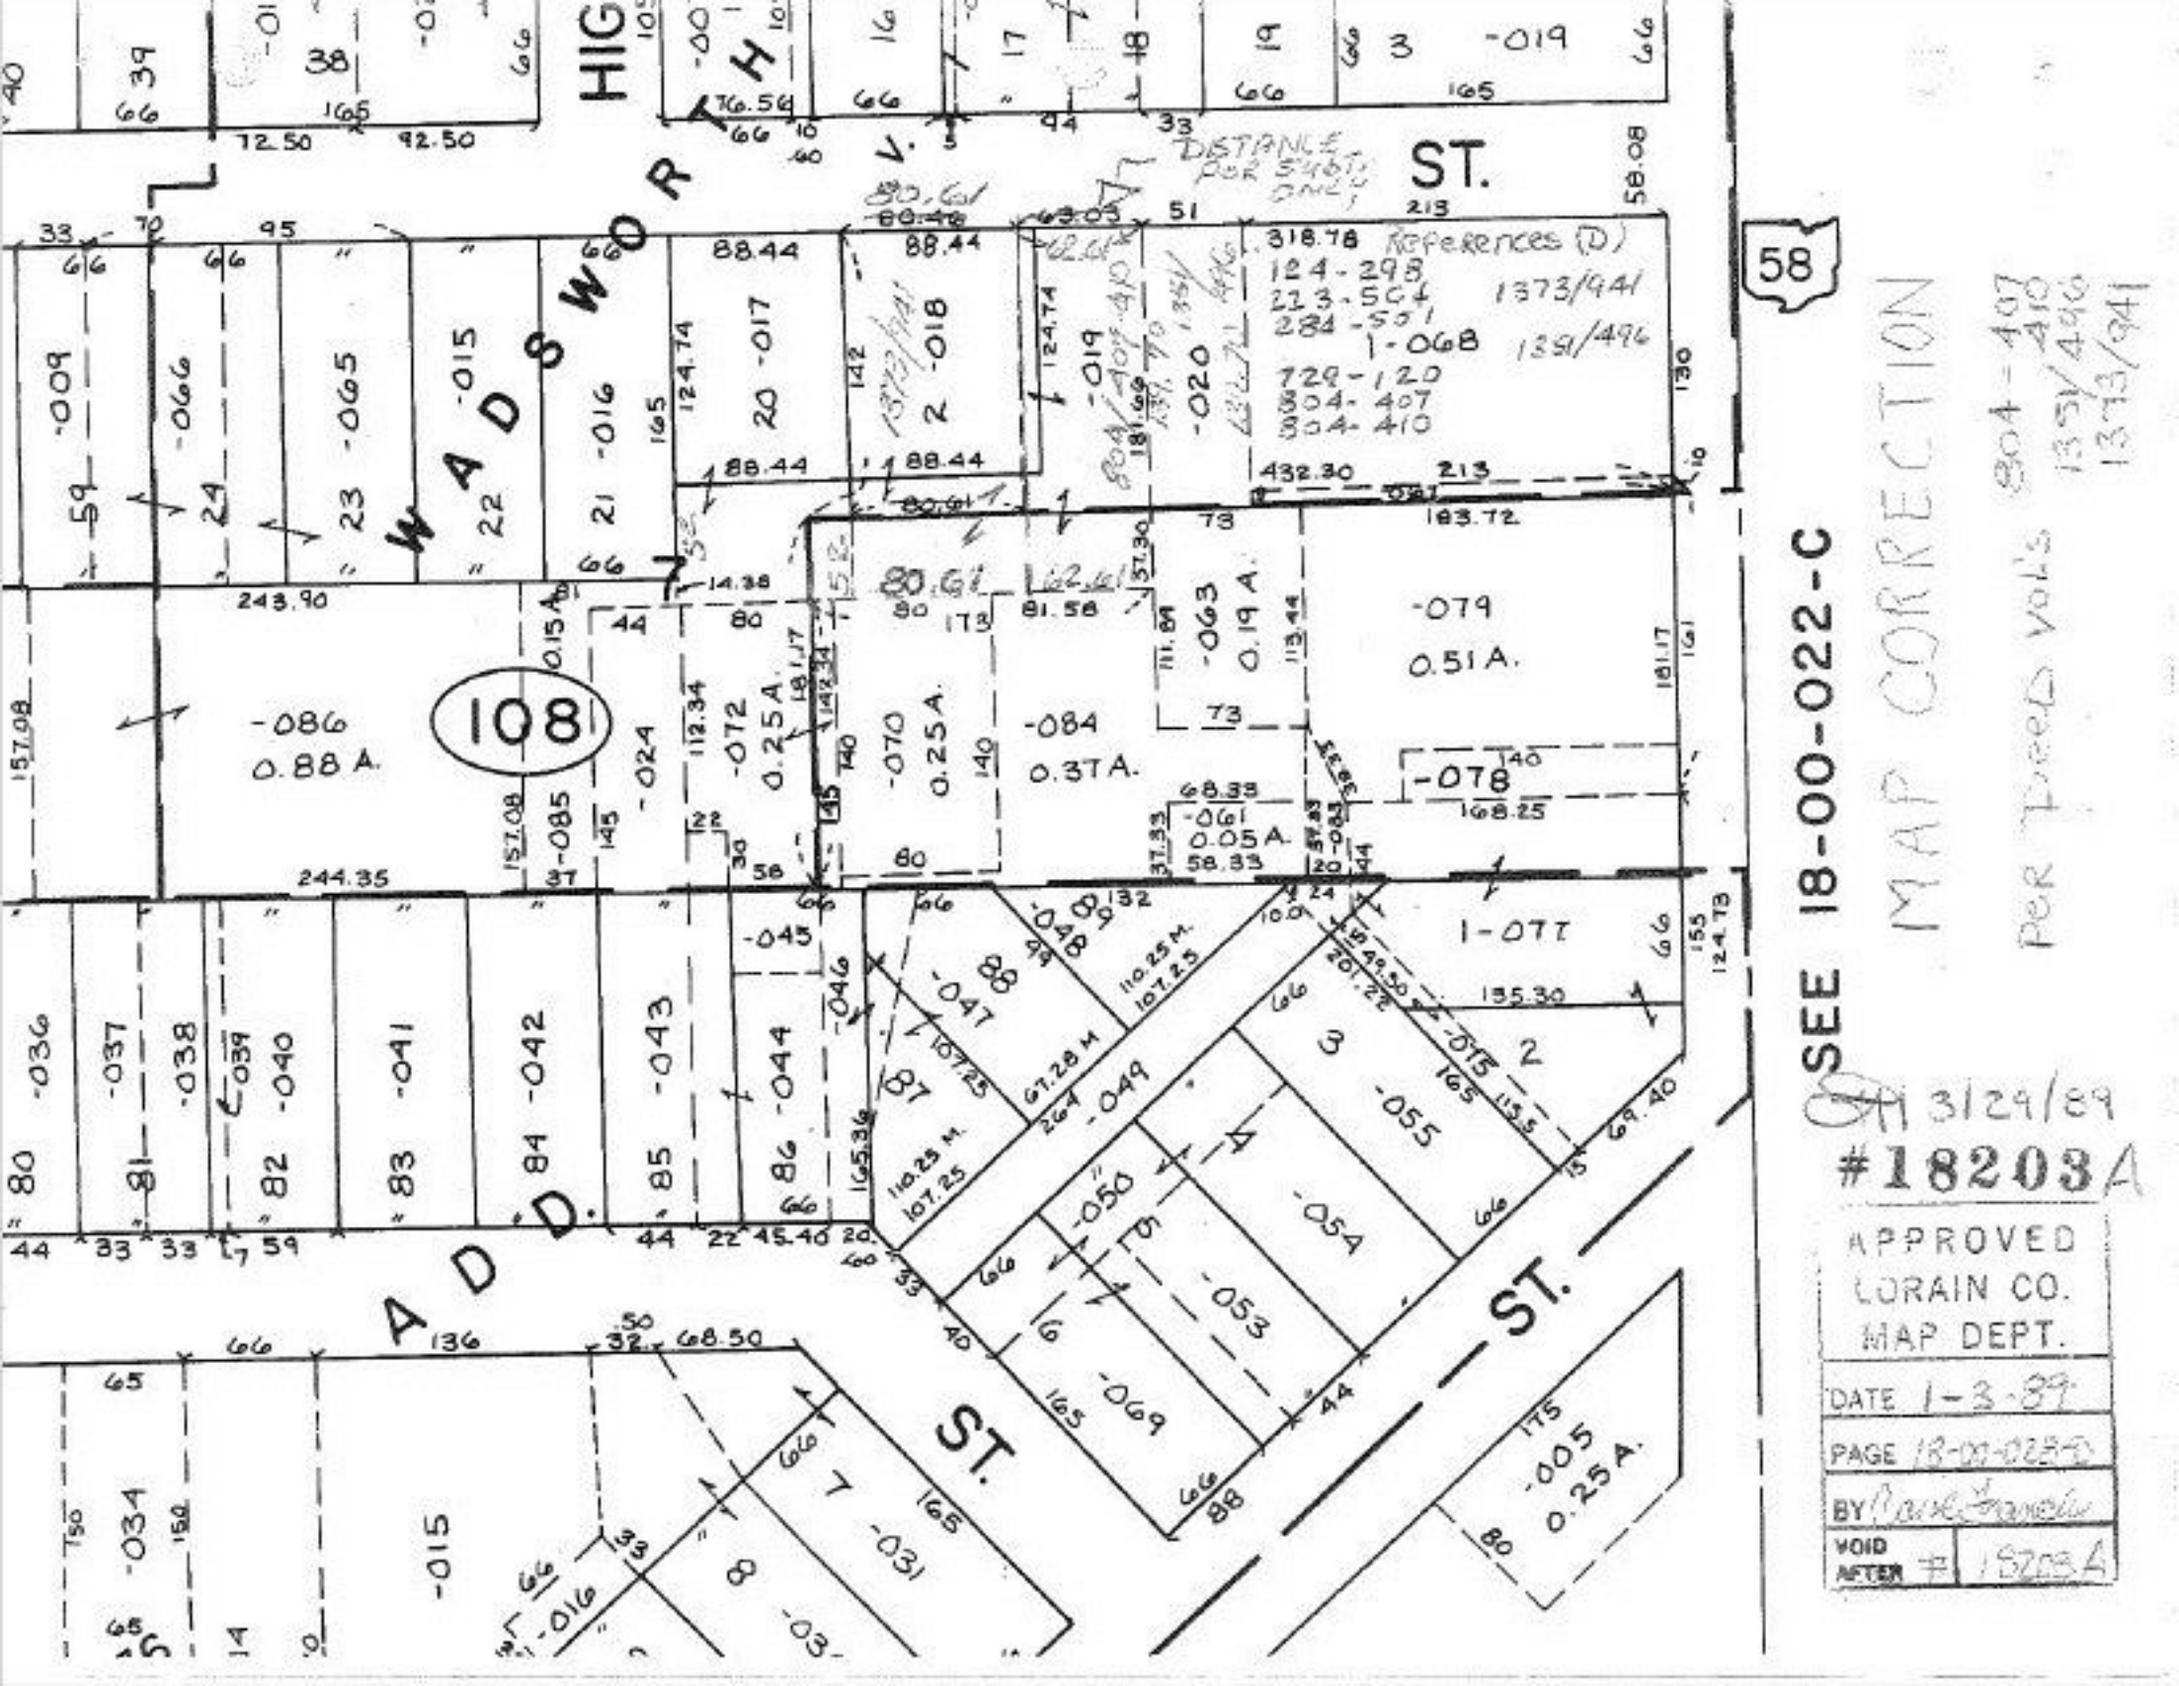

WADSWORTH
HIG
ST.
ADD.
108
58
SEE 18-00-022-C
MAP CORRECTION
PER DEED VOL'S 804-407 410 1351/496 1373/941
References (D)
124-298
223-504
284-501
1-068
729-120
804-407
804-410
1373/941
1351/496
DISTANCE PER SUBT. ONLY
-086 0.88 A.
-072 0.25 A.
-070 0.25 A.
-084 0.37 A.
-063 0.19 A.
-079 0.51 A.
-078
-061 0.05 A.
1-077
-005 0.25 A.
3/29/89
#18203A
APPROVED
LORAIN CO.
MAP DEPT.
DATE 1-3-89
PAGE 18-00-022-D
BY
VOID AFTER # 18203A