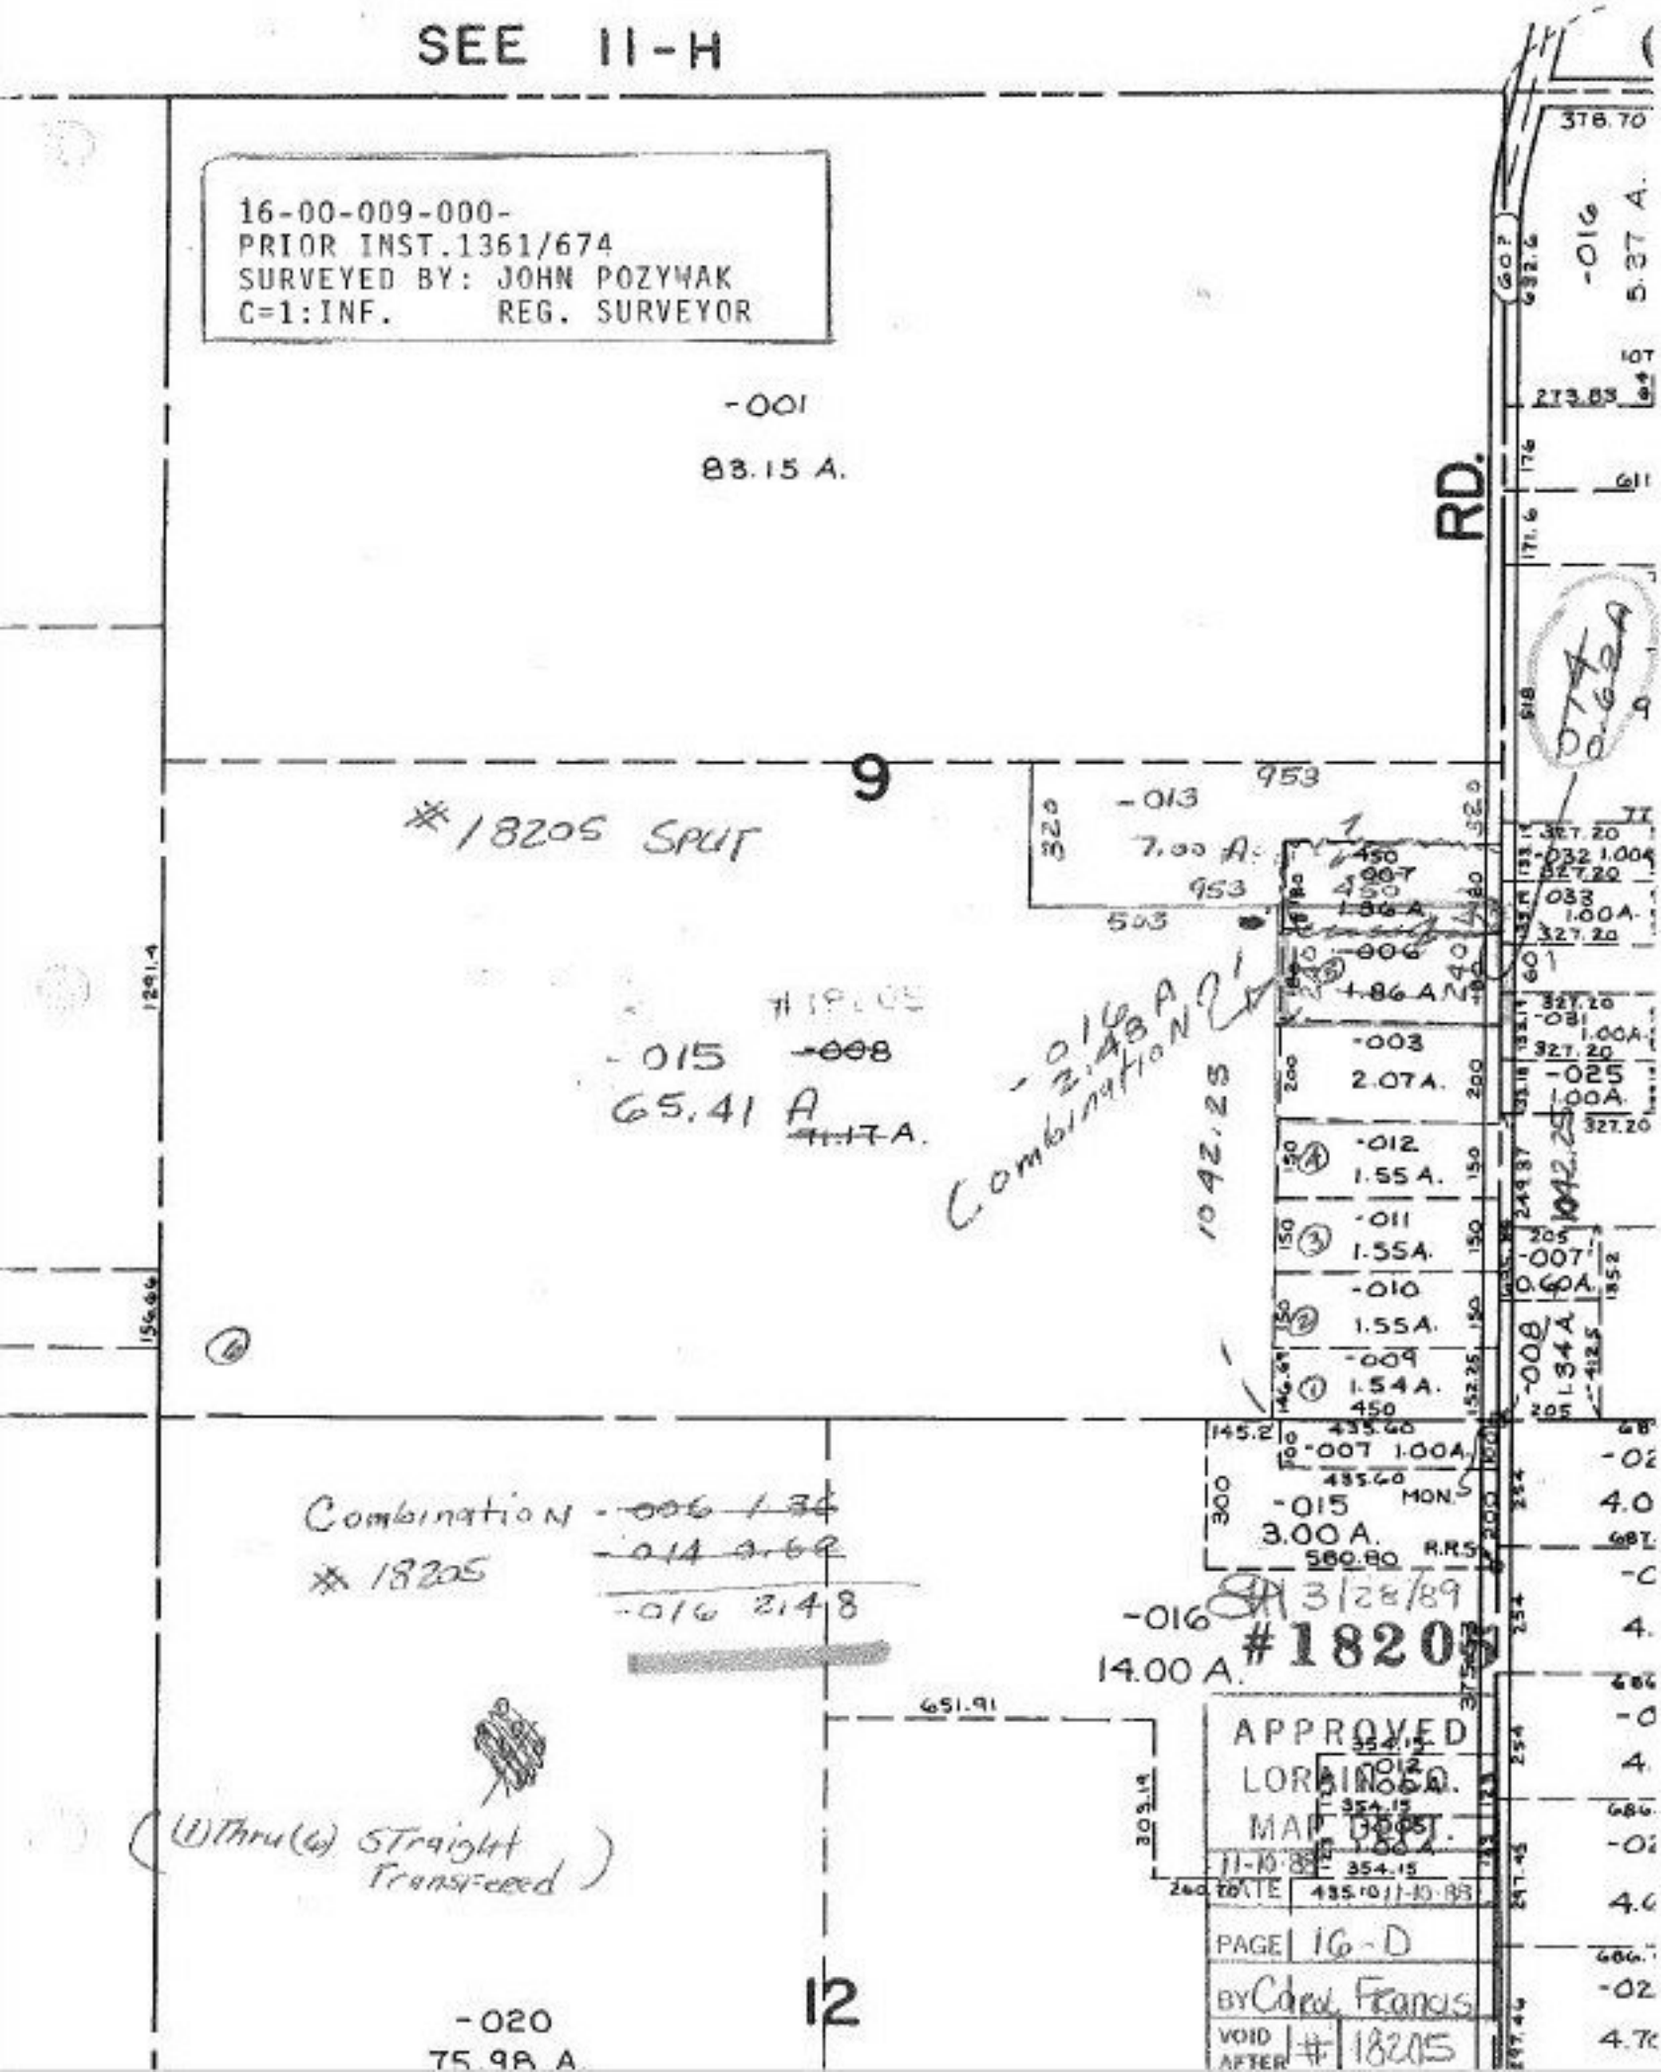
SEE 11-H
16-00-009-000-
PRIOR INST.1361/674
SURVEYED BY: JOHN POZYWAK
C=1:INF. REG. SURVEYOR
-001
83.15 A.
RD.
9
#18205 SPLIT
-013
7.00 A.
953
503
-015
65.41 A
-016 A
2.48 A
Combination
1042.25
-006
1.86 A
-003
2.07 A.
-012
1.55 A.
-011
1.55 A.
-010
1.55 A.
-009
1.54 A.
-007 1.00 A.
-015
3.00 A.
580.80
R.R.S.
MON.
-016
14.00 A.
#18205
3/28/89
Combination
#18205
-016 2.48
651.91
(1) Thru (6) Straight Transferred
APPROVED
LORAIN CO.
MAP DEPT.
11-10-88
DATE
PAGE 16-D
BY Carol Francis
VOID AFTER # 18205
12
-020
75.98 A.
-016
5.37 A.
378.70
273.83
-025
1.00 A.
-007
0.60 A.
-008
1.34 A.
1291.4
156.66