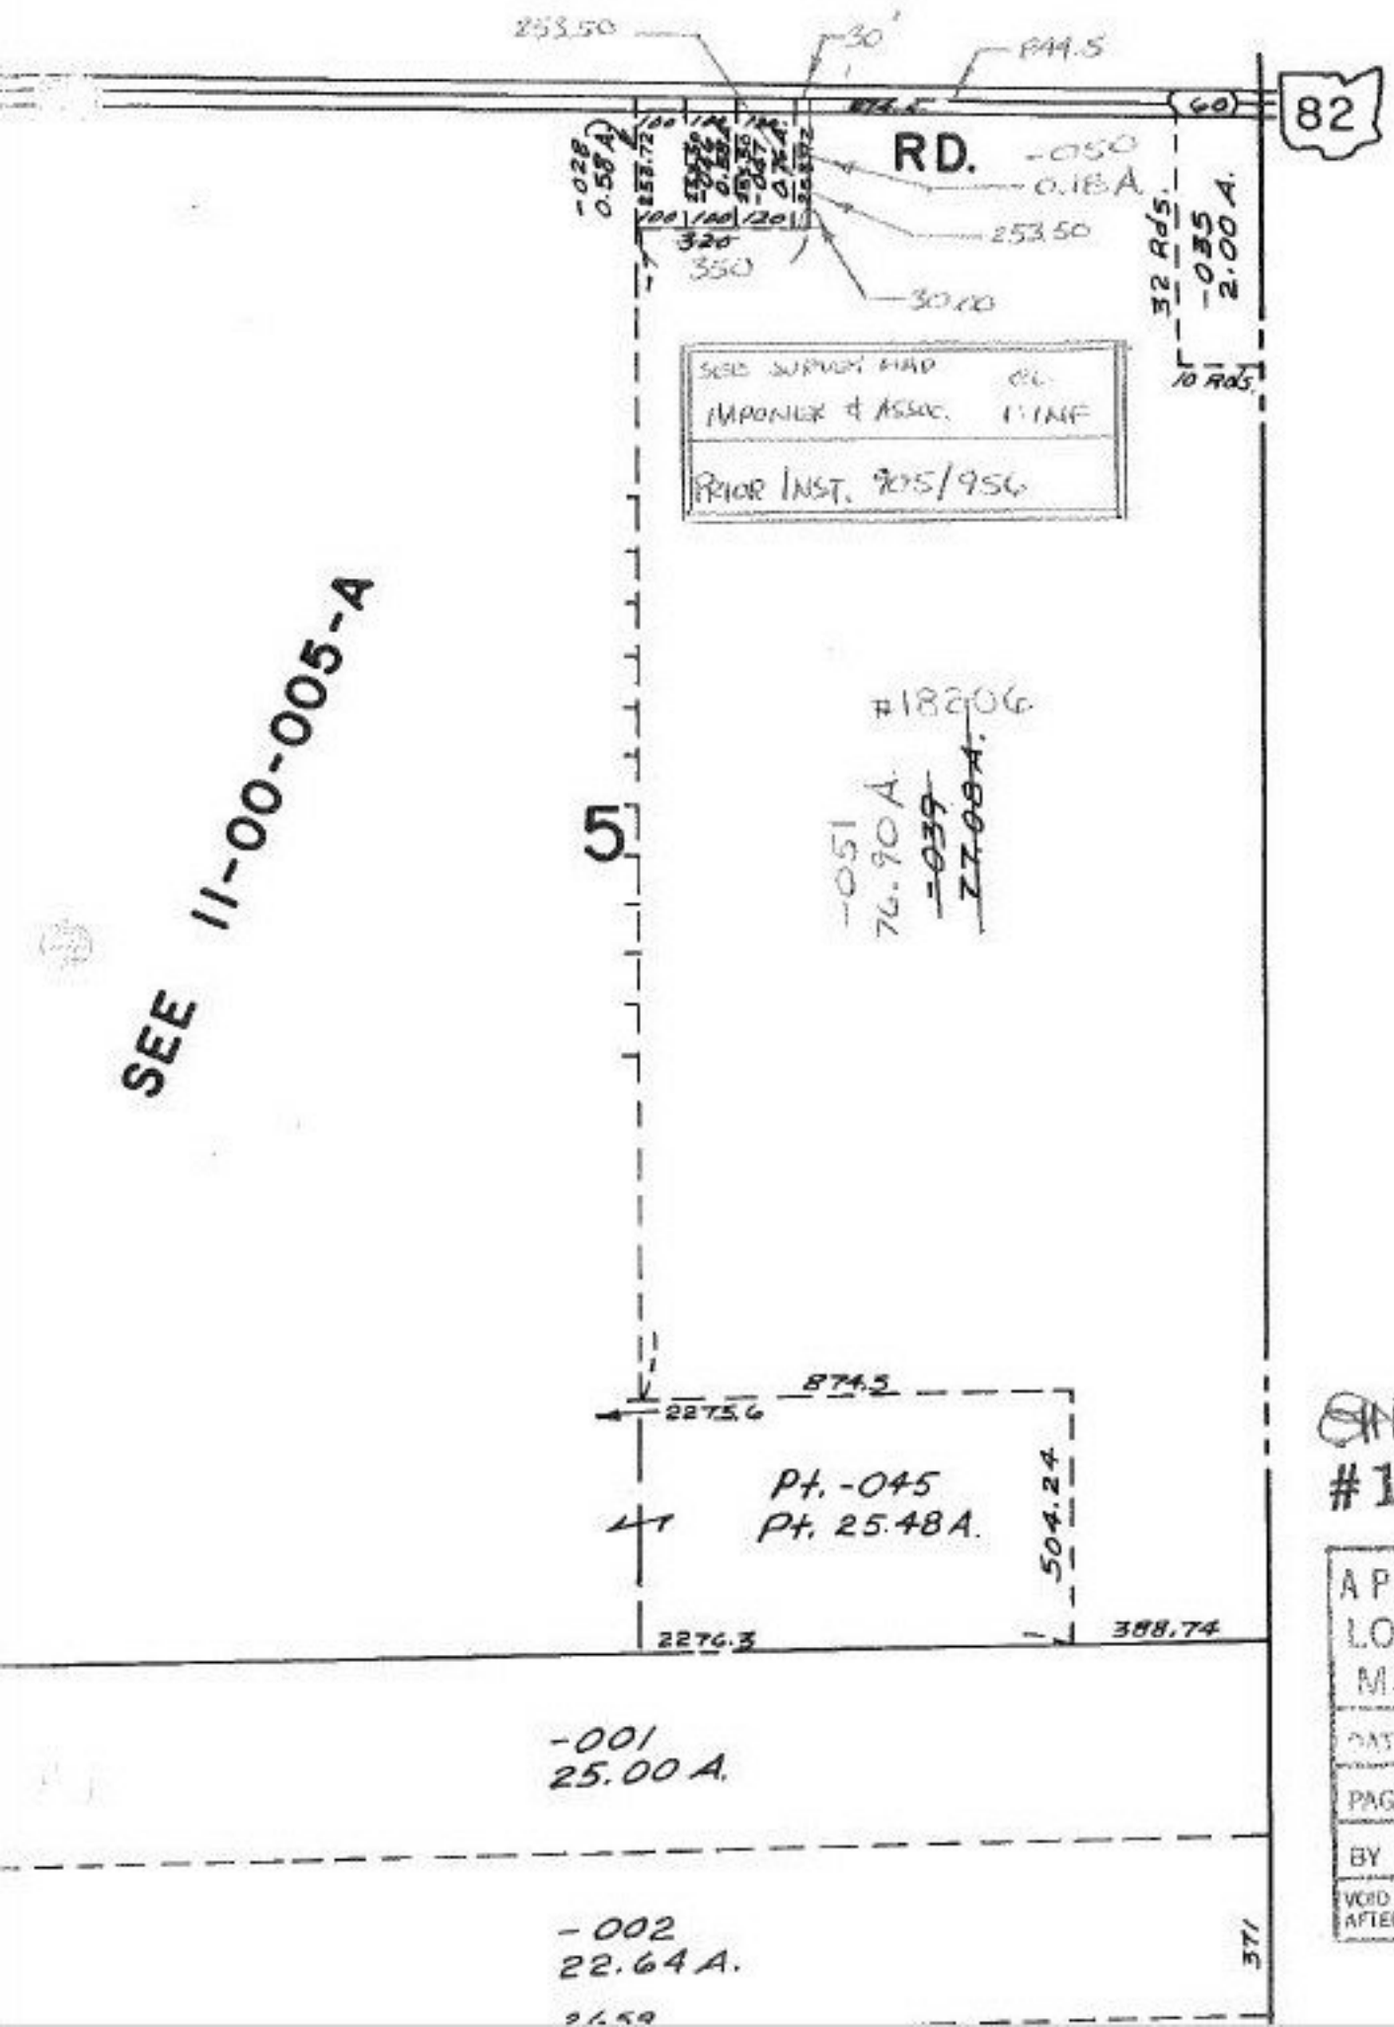

3/17/89
#18206

APPROVED
LORAIN CO.
MAP DEPT.
DATE 11-10-89
PAGE 11-H
BY T. McNair
VOID AFTER 18206