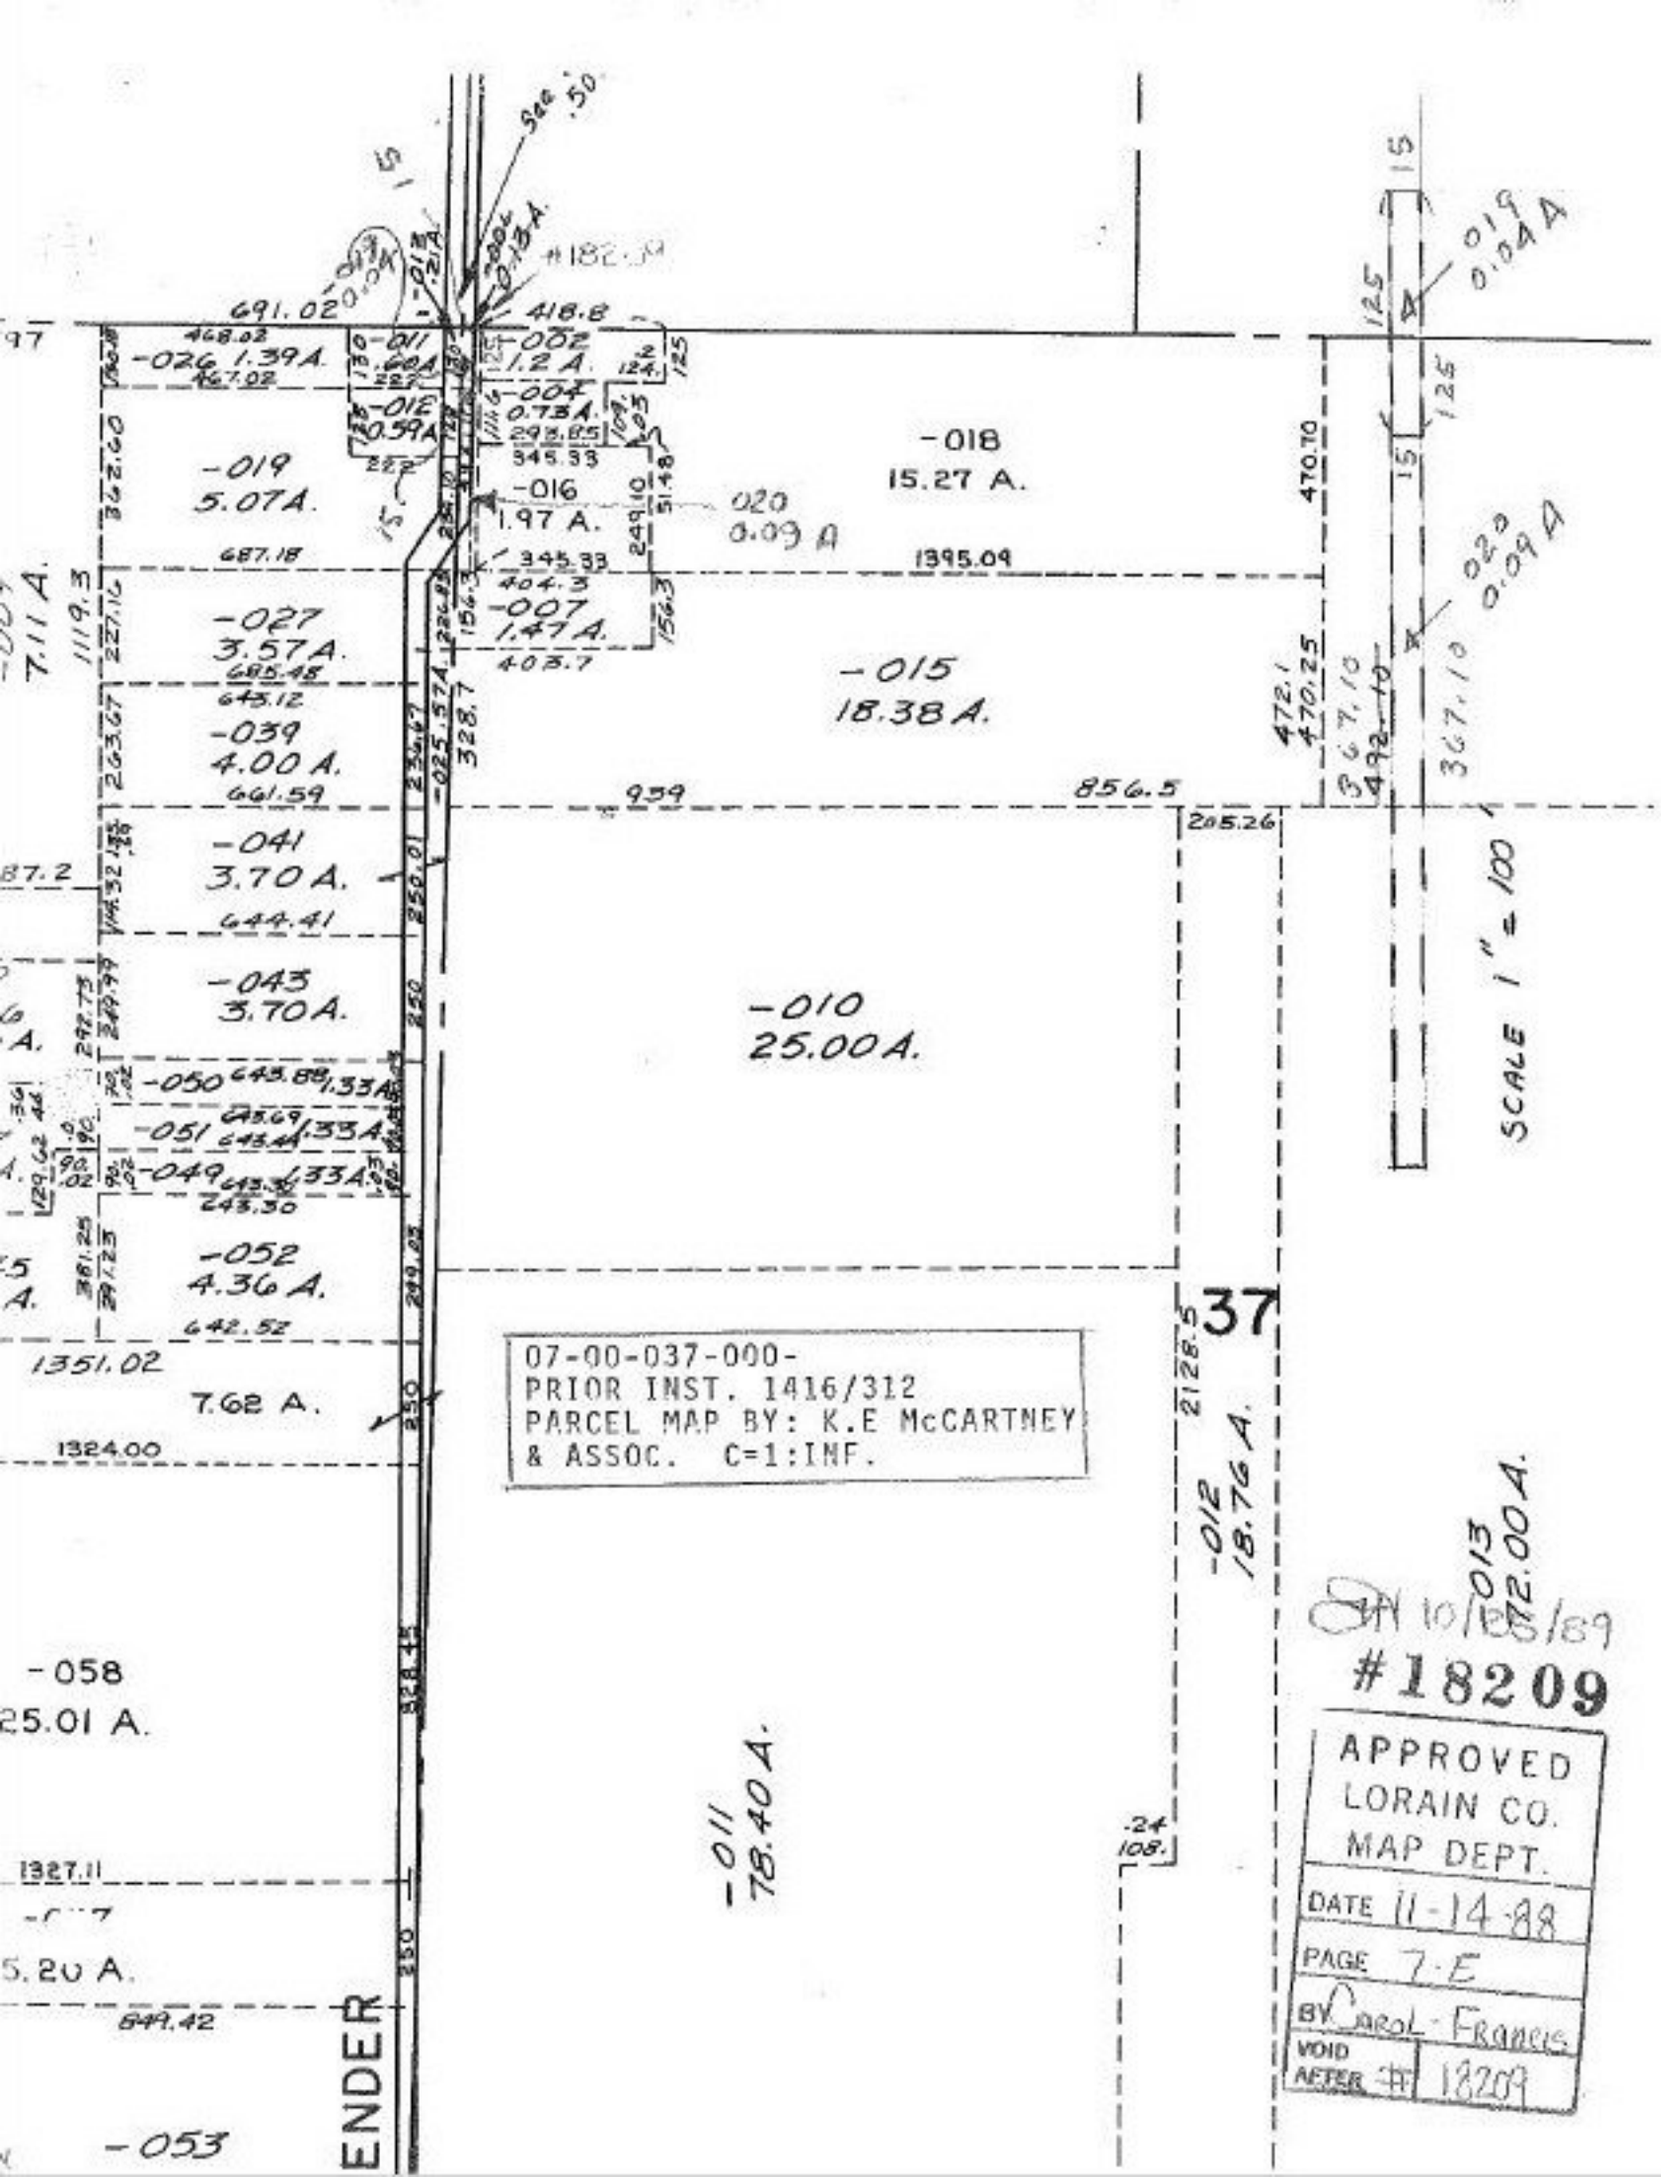

07-00-037-000-
PRIOR INST. 1416/312
PARCEL MAP BY: K.E McCARTNEY
& ASSOC. C=1:INF.
-018
15.27 A.
-019
5.07A.
-016
1.97 A.
-027
3.57A.
-007
1.47 A.
-015
18.38 A.
-039
4.00 A.
-041
3.70 A.
-043
3.70A.
-010
25.00A.
-052
4.36 A.
7.62 A.
-012
18.76 A.
-058
25.01 A.
-011
78.40 A.
-053
ENDER
SCALE 1" = 100'
37
#18209
APPROVED
LORAIN CO.
MAP DEPT.
DATE 11-14-88
PAGE 7-E
BY Carol Francis
VOID AFTER # 18209