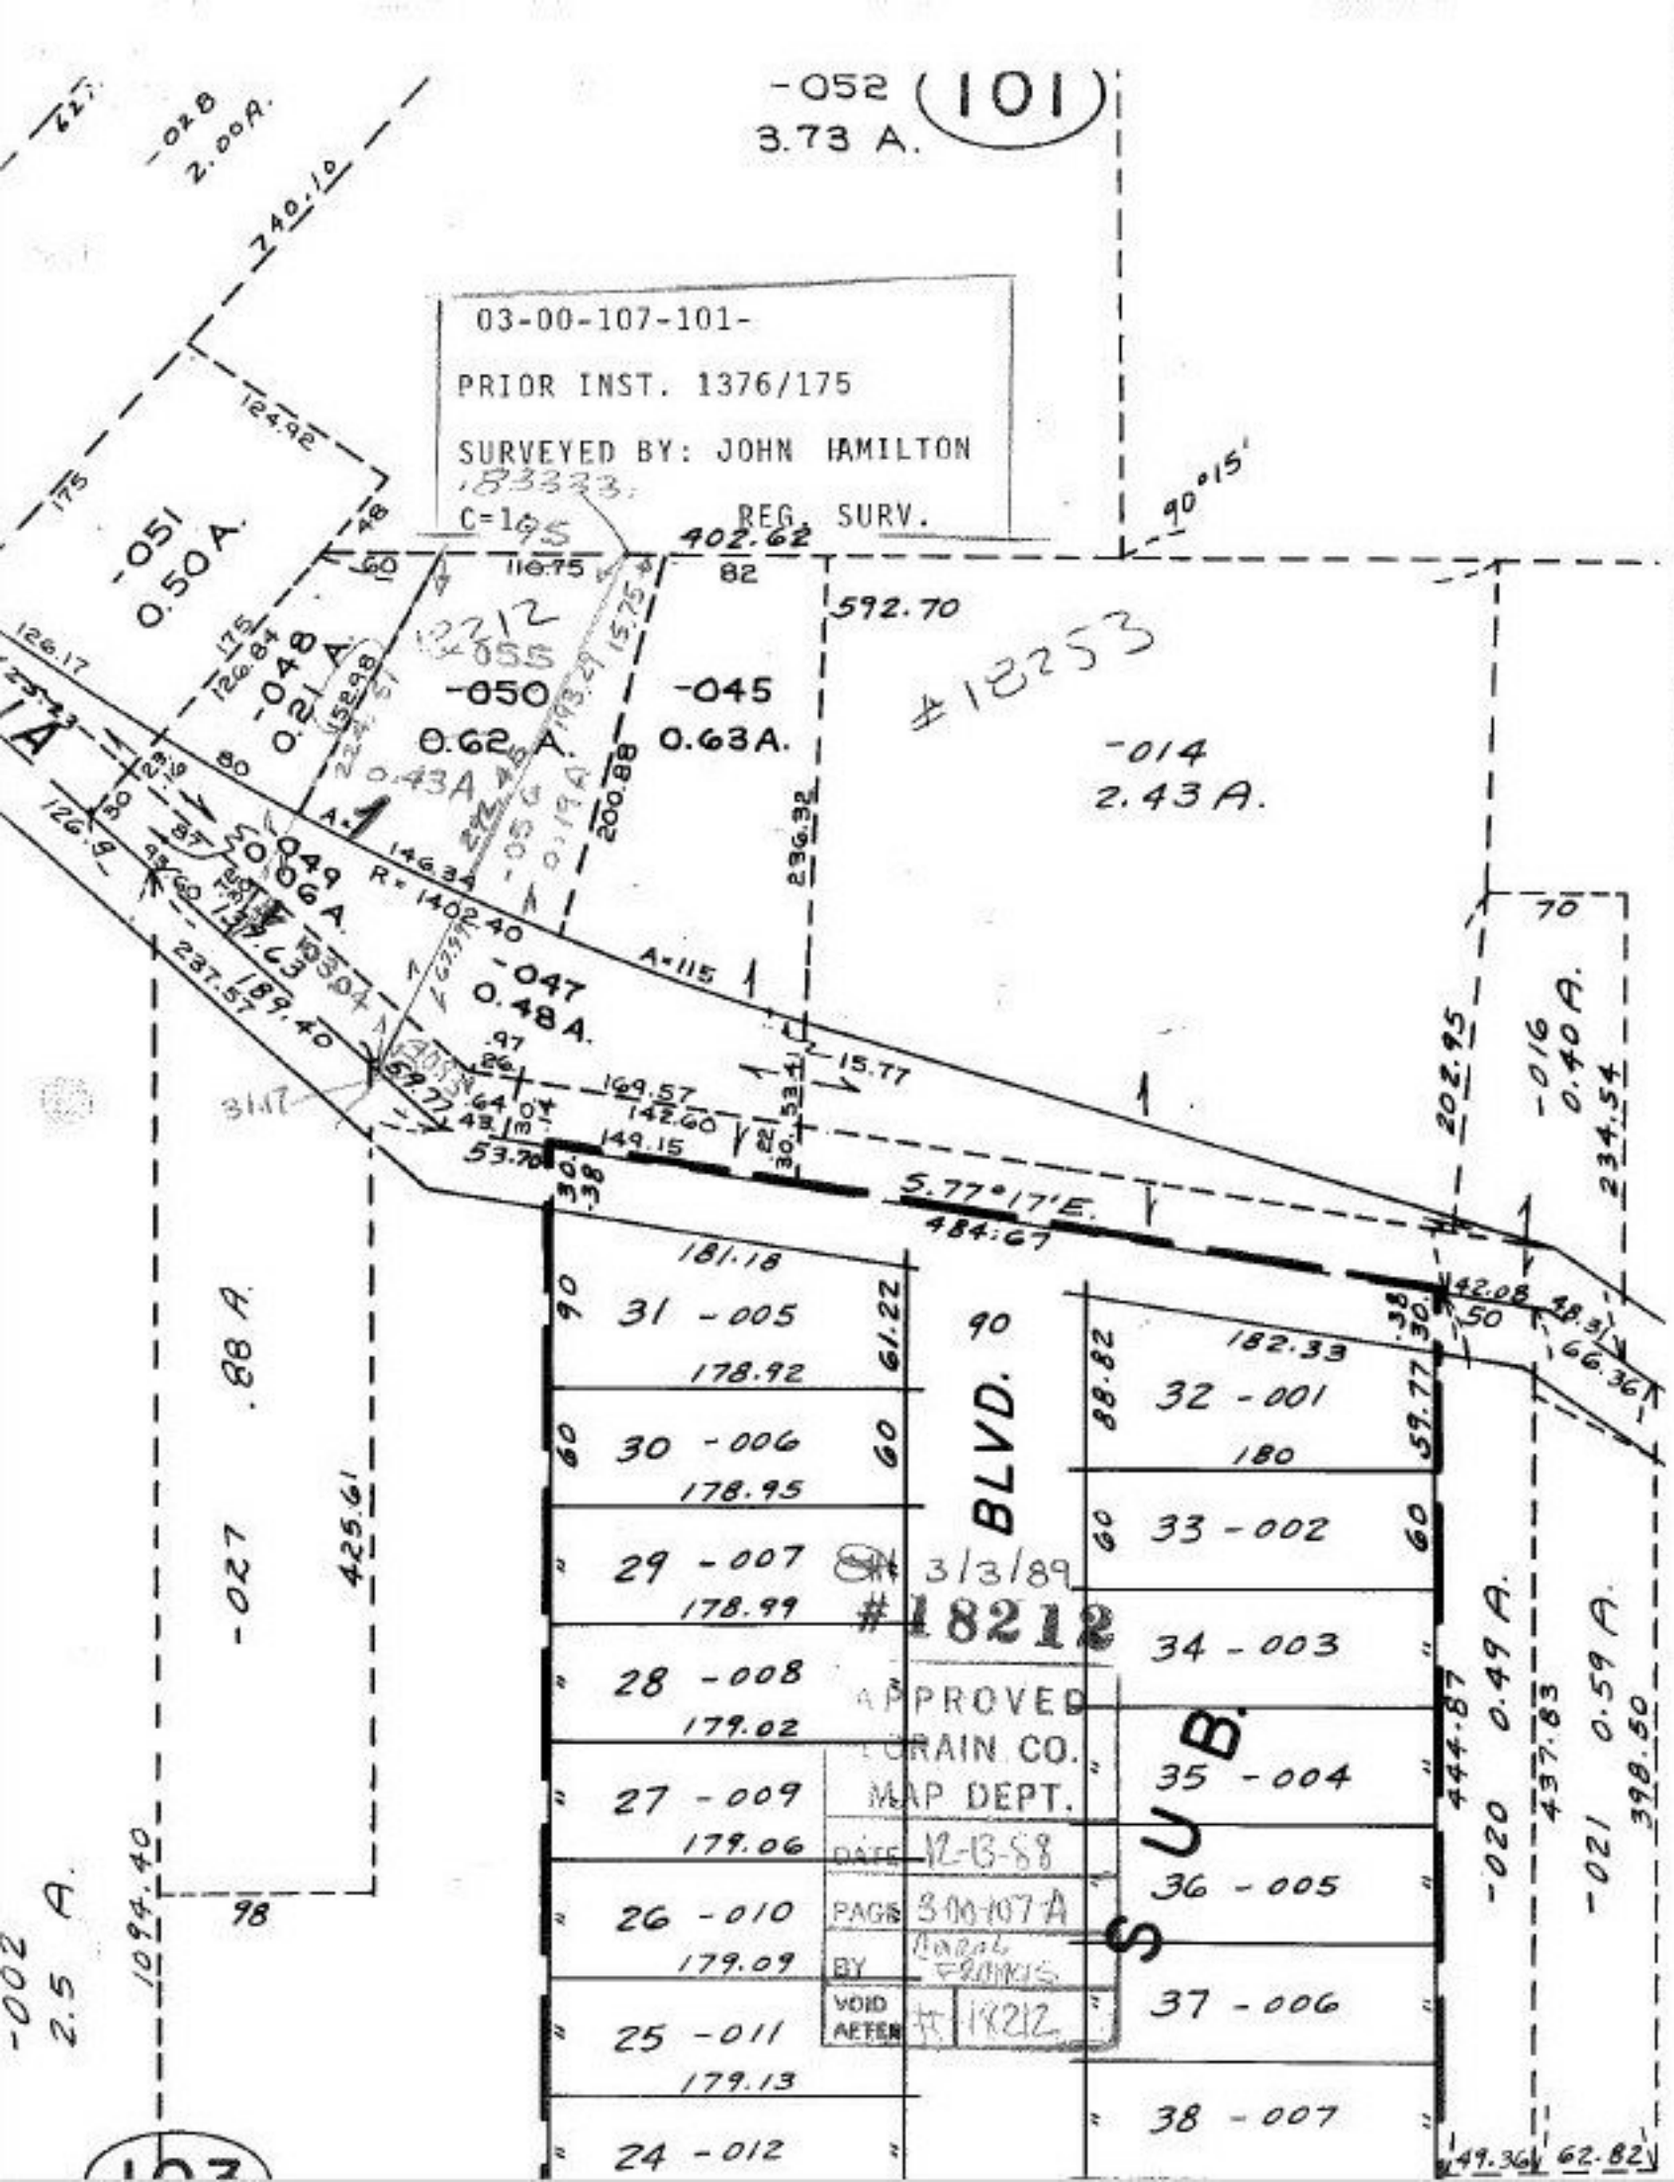

-052 (101)
3.73 A.
03-00-107-101-
PRIOR INST. 1376/175
SURVEYED BY: JOHN HAMILTON
C=1.95 REG. SURV.
-051
0.50 A.
-048
0.21 A.
-050
0.62 A.
-045
0.63 A.
-014
2.43 A.
-049
0.06 A.
-047
0.48 A.
#18253
-016
0.40 A.
-027
.88 A.
-002
2.5 A.
BLVD.
SUB.
31 -005
30 -006
29 -007
28 -008
27 -009
26 -010
25 -011
24 -012
32 -001
33 -002
34 -003
35 -004
36 -005
37 -006
38 -007
3/3/89
#18212
APPROVED
TORRAIN CO.
MAP DEPT.
DATE 12-13-88
PAGE 3-00-107-A
BY
VOID AFTER #18212