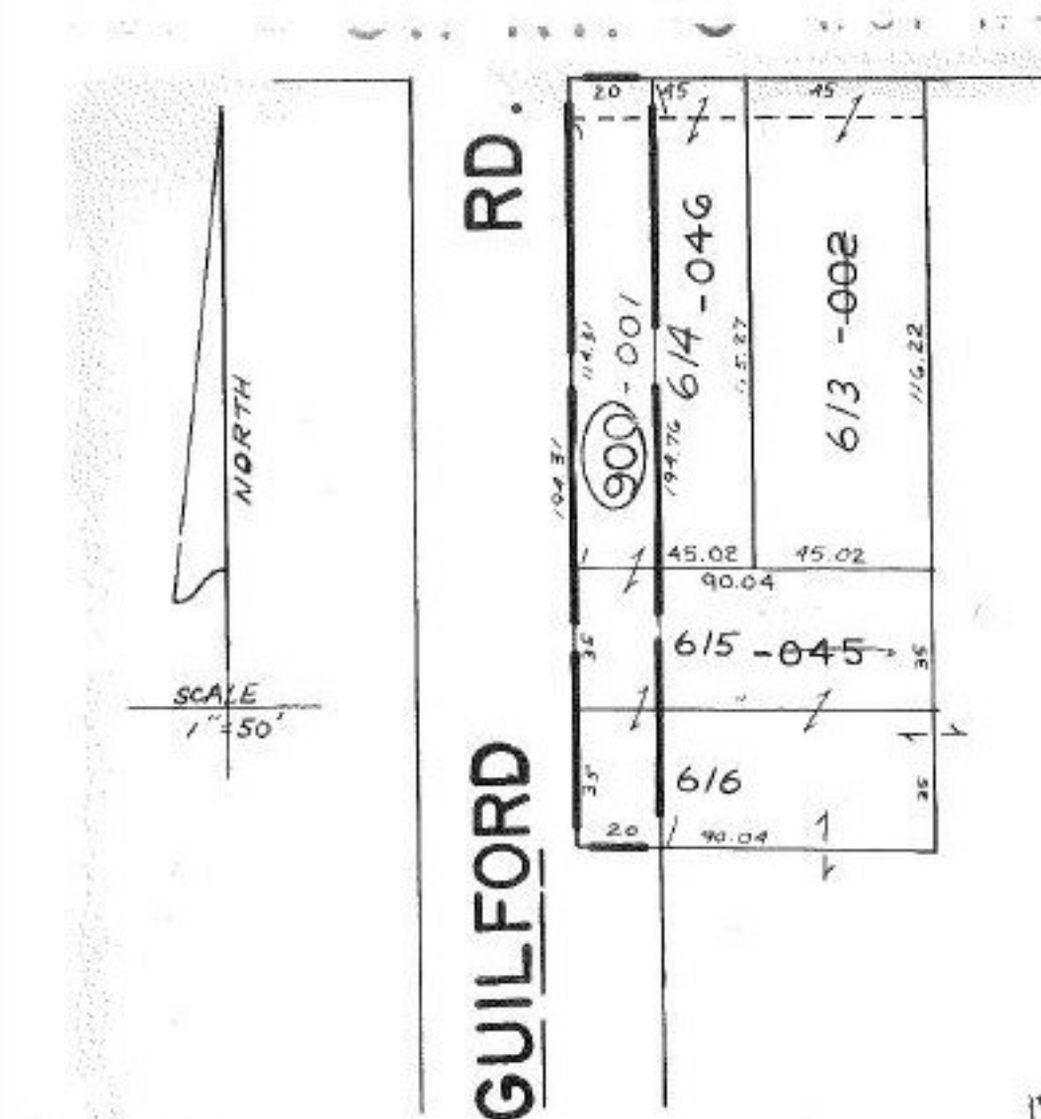

01-00-003-128-

PRIOR INST. OR.V.61/920
76/136

JB. NO. 2

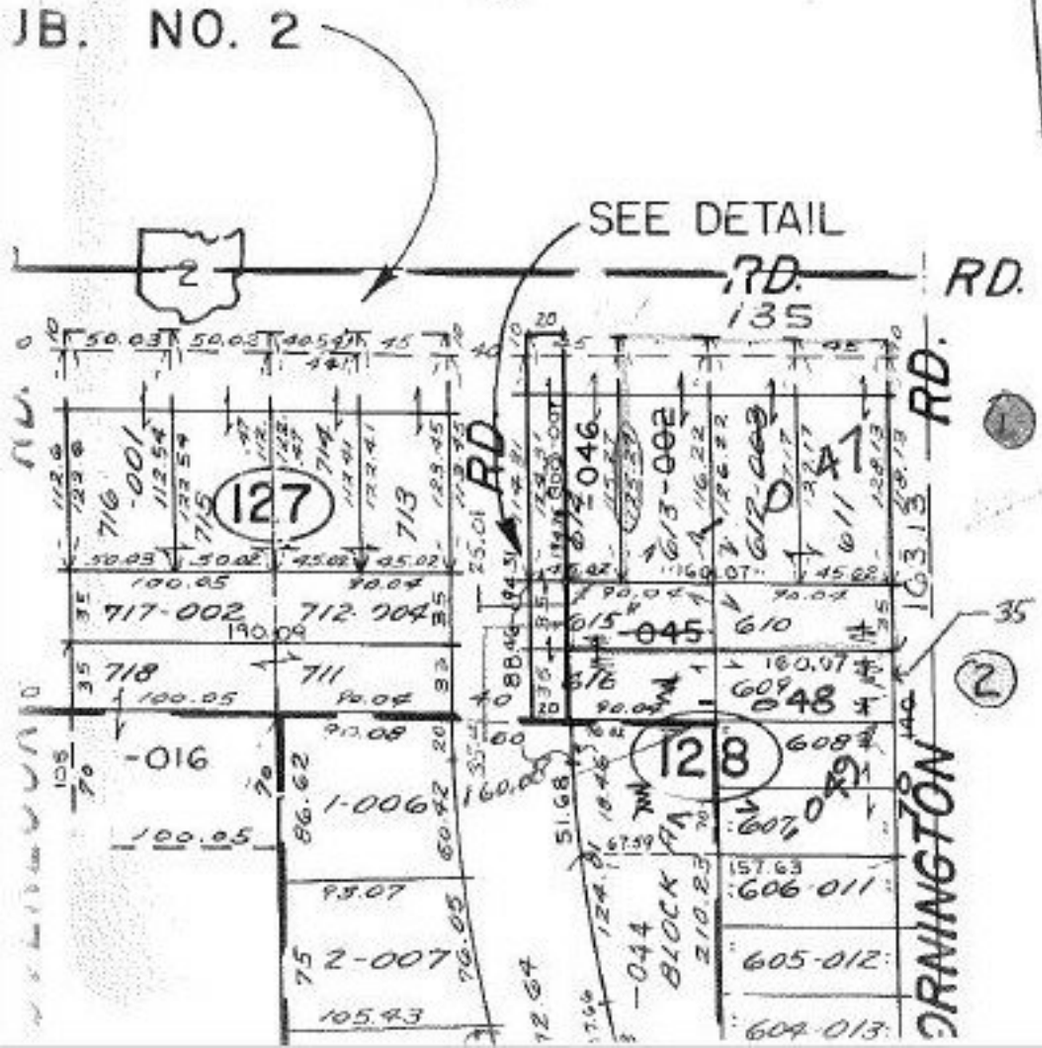

SN 2/22/89

#18219

APPROVED
LORAIN CO.
MAP DEPT.

DATE 11-18-88

PAGE 1-00-003-C

BY Carol Francis

VOID AFTER # 18219