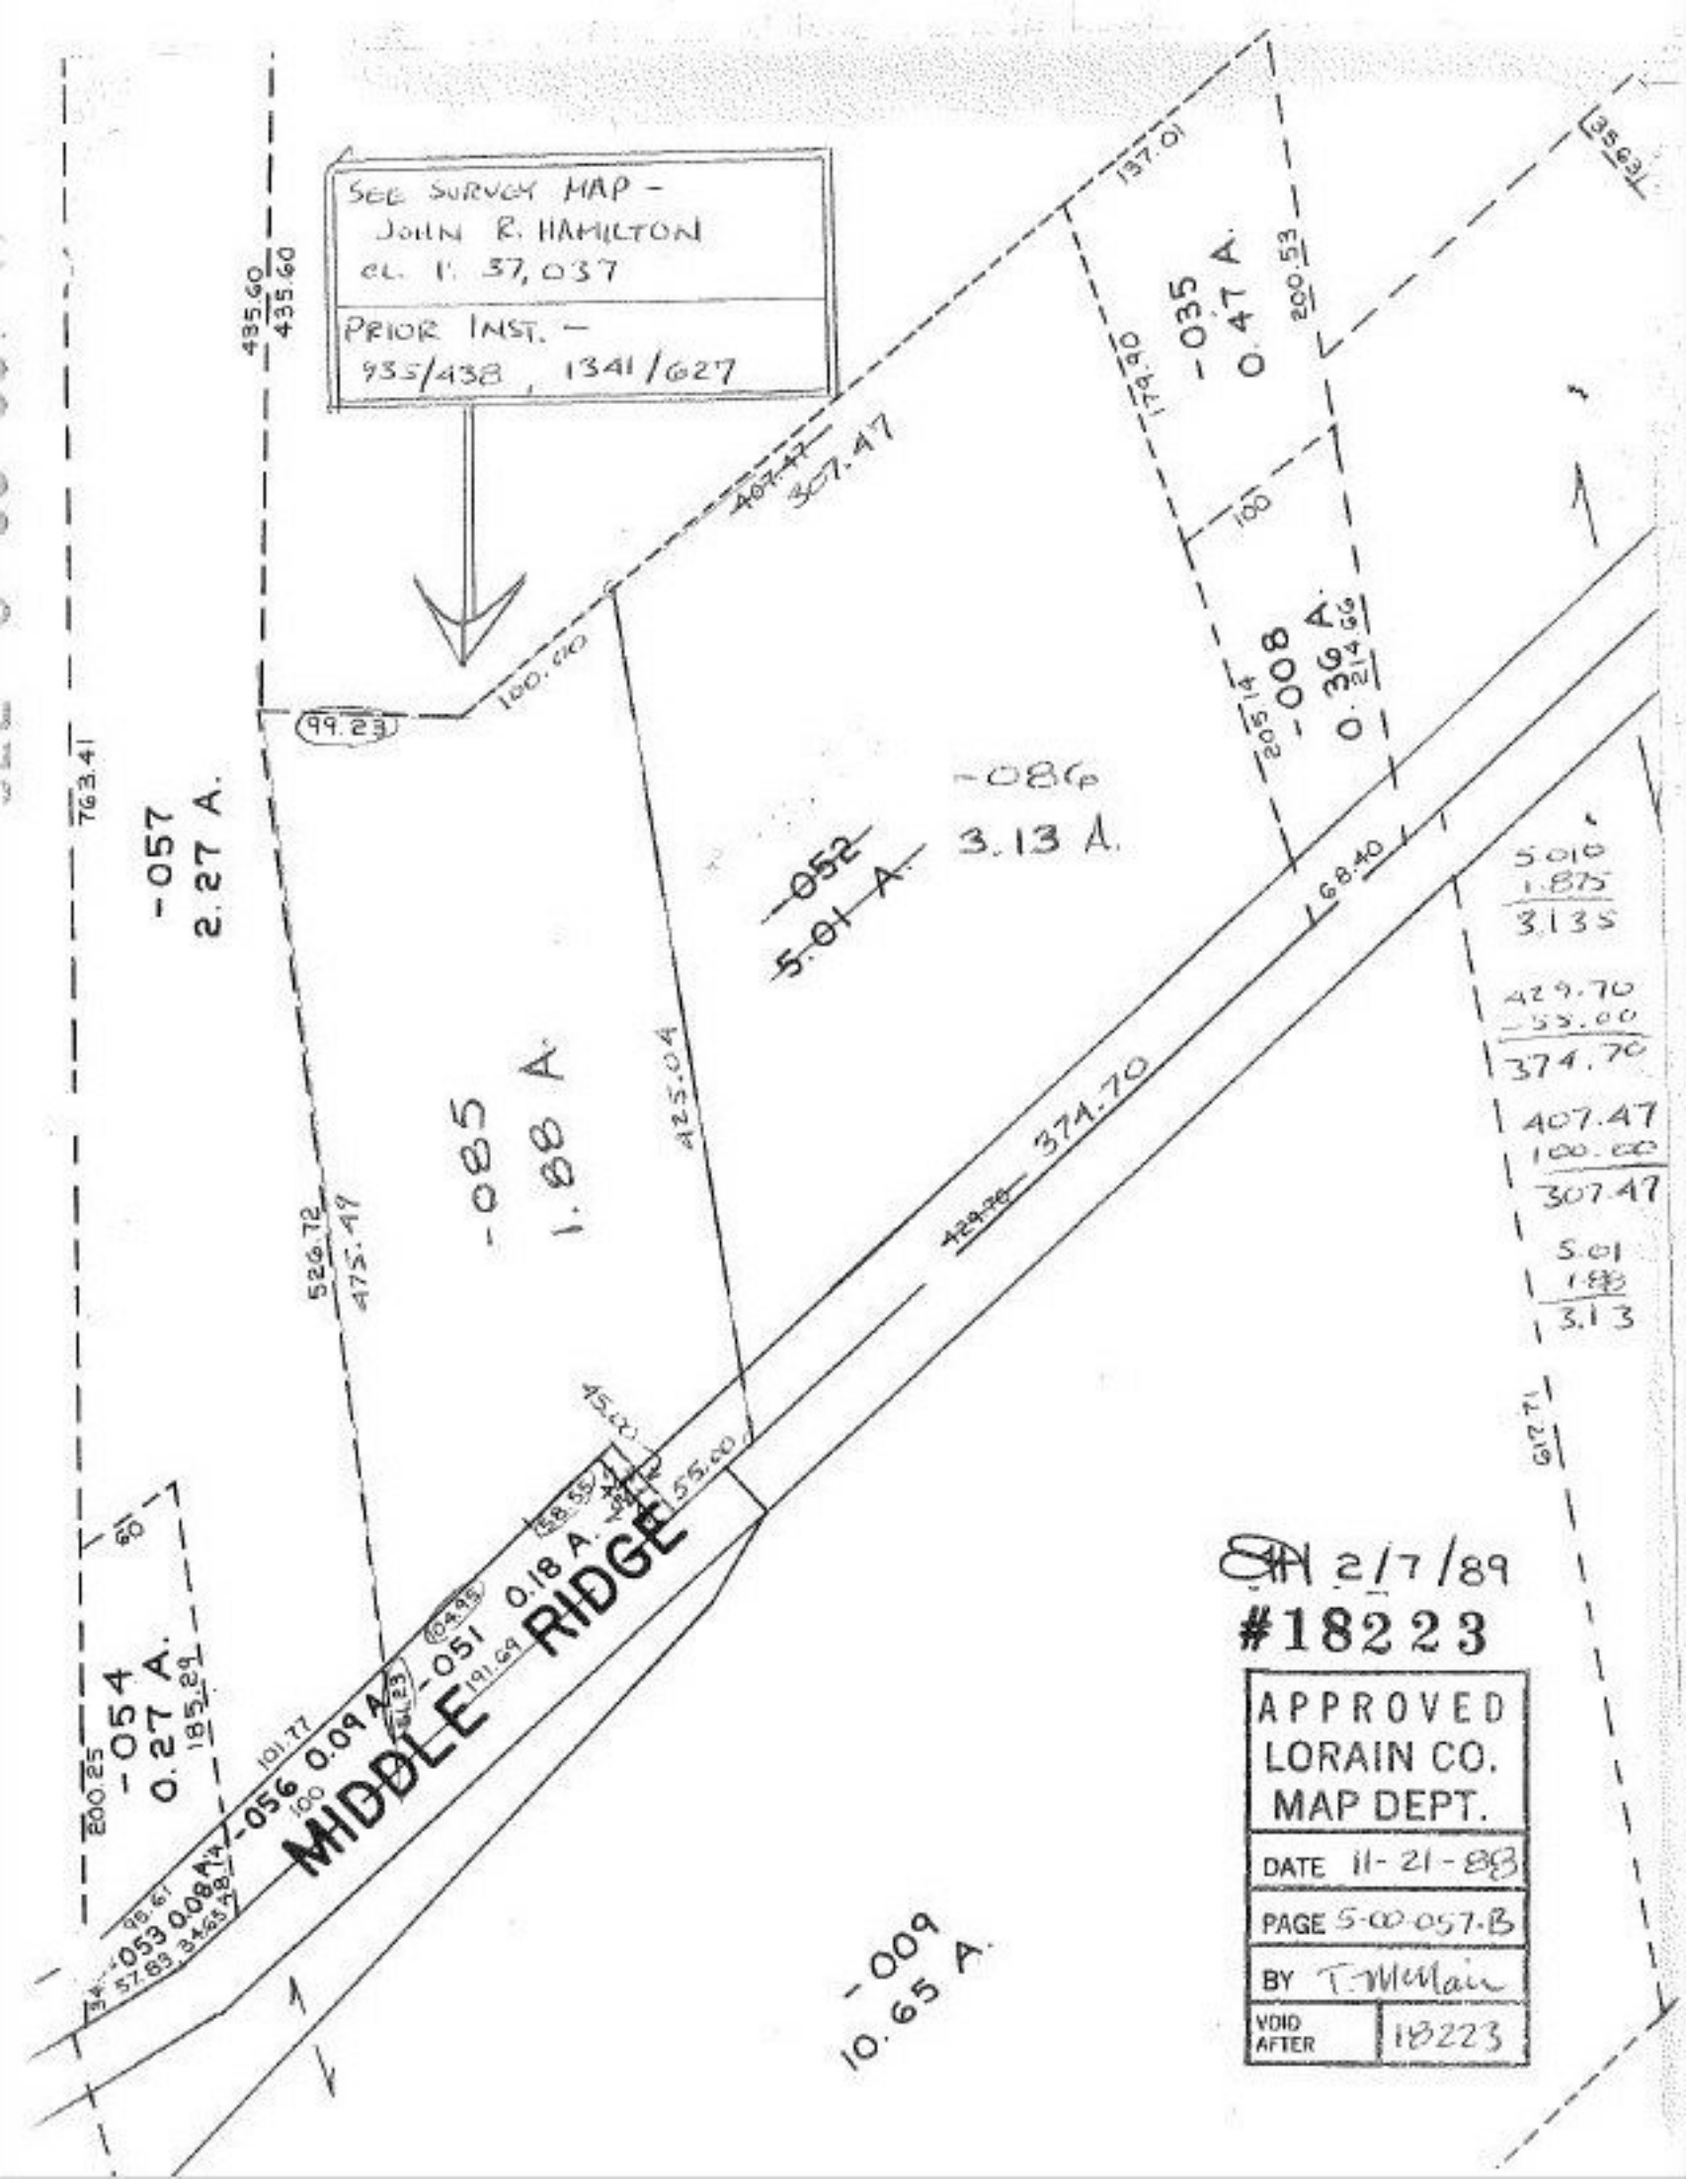

SH 2/7/89

#18223

APPROVED LORAIN CO. MAP DEPT.	
DATE	11-21-88
PAGE	5-00-057.B
BY	T. McMain
VOID AFTER	18223