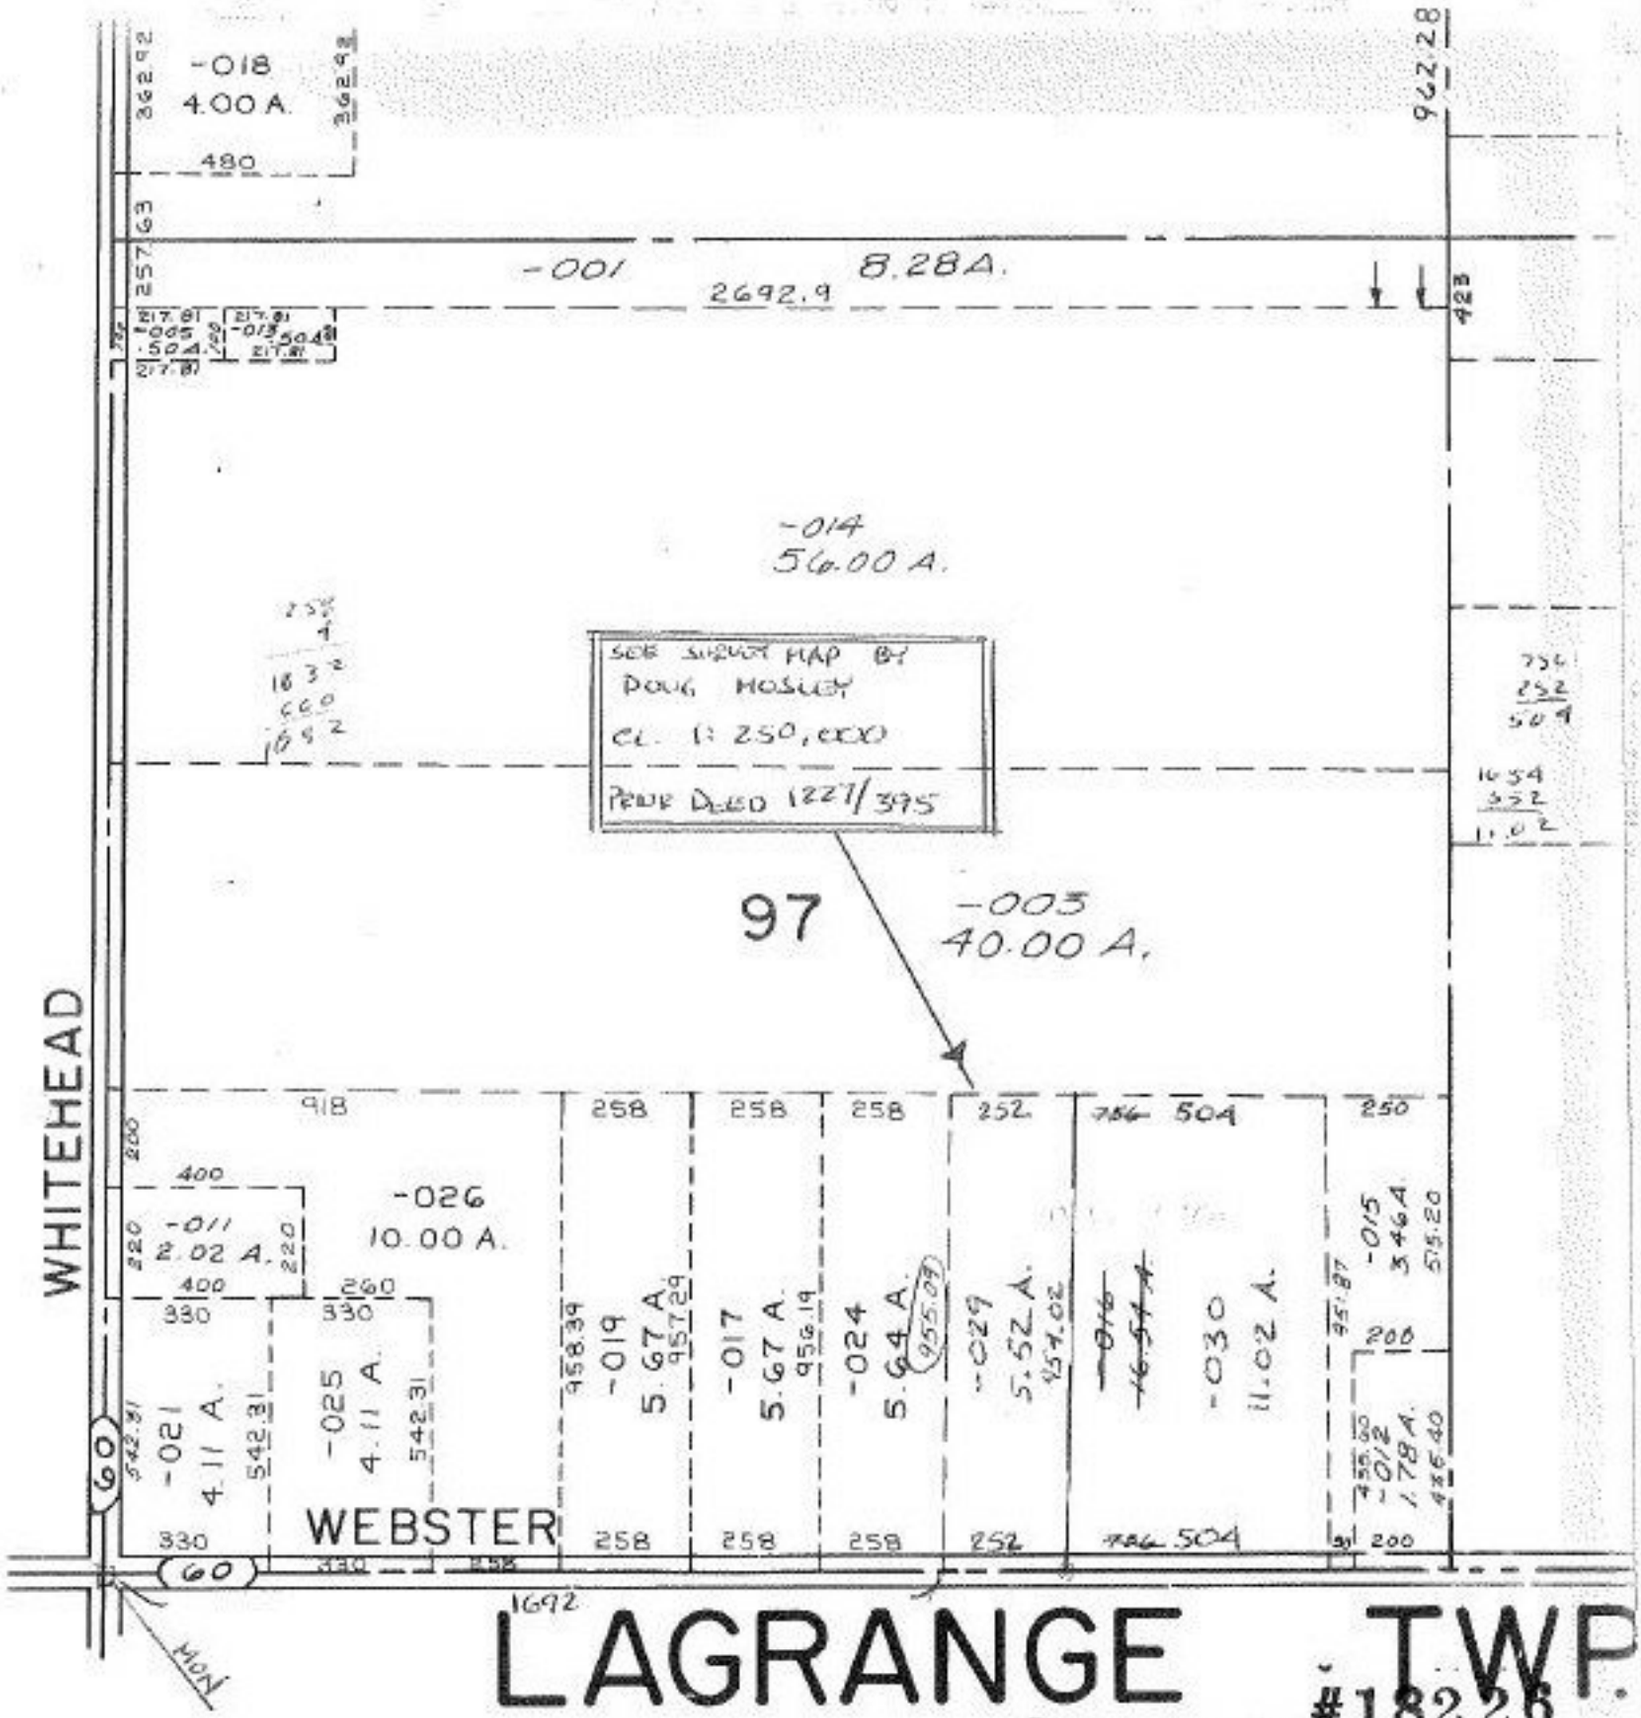
-018
4.00 A.
362.92
480
962.28
-001
8.28A.
2692.9
423
257
63
-014
56.00 A.
SEE SURVEY MAP BY
DOUG MOSLEY
CL. I: 250,000
PRVE DEED 1227/395
97
-005
40.00 A.
WHITEHEAD
-026
10.00 A.
-011
2.02 A.
-021
4.11 A.
-025
4.11 A.
-019
5.67 A.
-017
5.67 A.
-024
5.64 A.
-029
5.52 A.
-030
11.02 A.
-015
3.46A.
-012
1.78A.
WEBSTER
60
LAGRANGE TWP.
SCALE: 1" = 400'
#18226
APPROVED
LORAIN CO.
MAP DEPT.
DATE 11-22-88
PAGE 15-F
BY T. McMain
VOID AFTER 18226