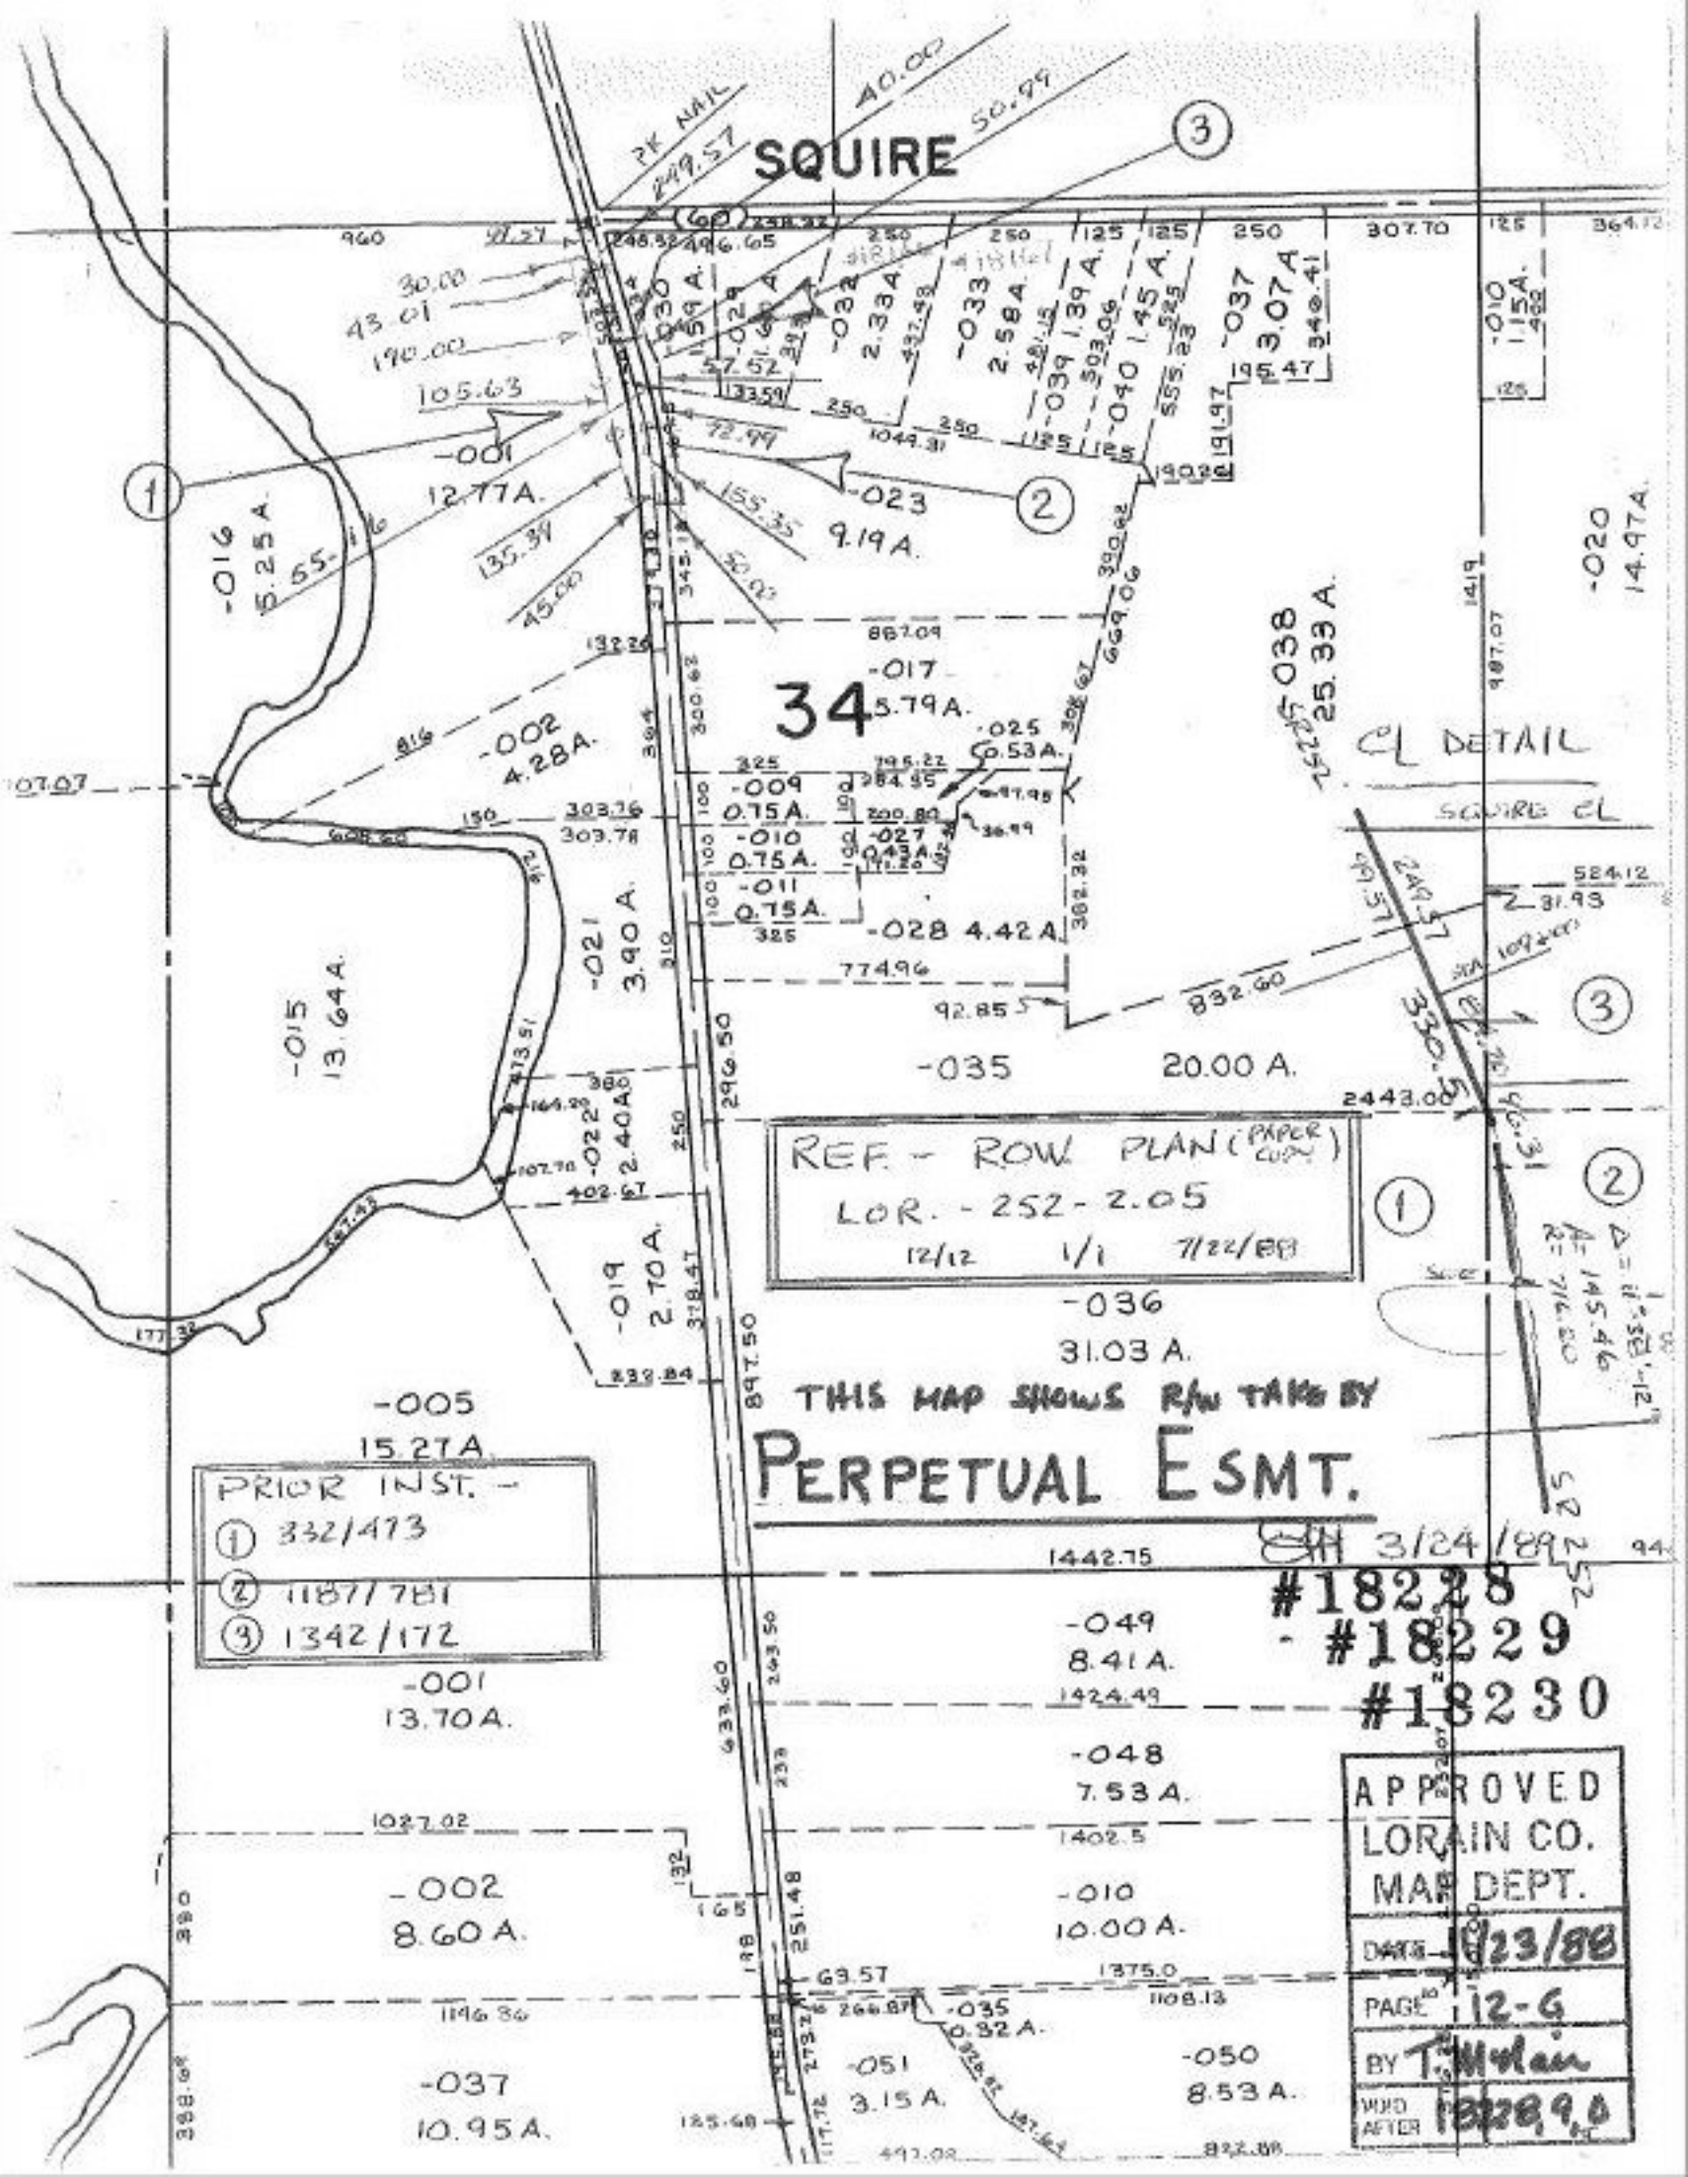
SQUIRE
PK NAIL
249.57
40.00
50.99
34
-016 5.25 A.
-001 12.77 A.
-023 9.19 A.
-017 5.79 A.
-002 4.28 A.
-009 0.75 A.
-010 0.75 A.
-011 0.75 A.
-028 4.42 A.
-021 3.90 A.
-015 13.64 A.
-022 2.40 A.
-019 2.70 A.
-035 20.00 A.
-036 31.03 A.
-005 15.27 A.
-001 13.70 A.
-002 8.60 A.
-037 10.95 A.
-049 8.41 A.
-048 7.53 A.
-010 10.00 A.
-035 0.32 A.
-051 3.15 A.
-050 8.53 A.
-020 14.97 A.
-038 25.33 A.
CL DETAIL
SQUIRE CL
REF. - ROW PLAN (PAPER COPY)
LOR. - 252 - 2.05
12/12 1/1 7/22/88
THIS MAP SHOWS R/W TAKE BY
PERPETUAL ESMT.
PRIOR INST. -
① 332/473
② 1187/781
③ 1342/172
3/24/89
#18228
#18229
#18230
APPROVED
LORAIN CO.
MAP DEPT.
DATE 11/23/88
PAGE 12-G
BY T. McLain
VOID AFTER 18228,9,0