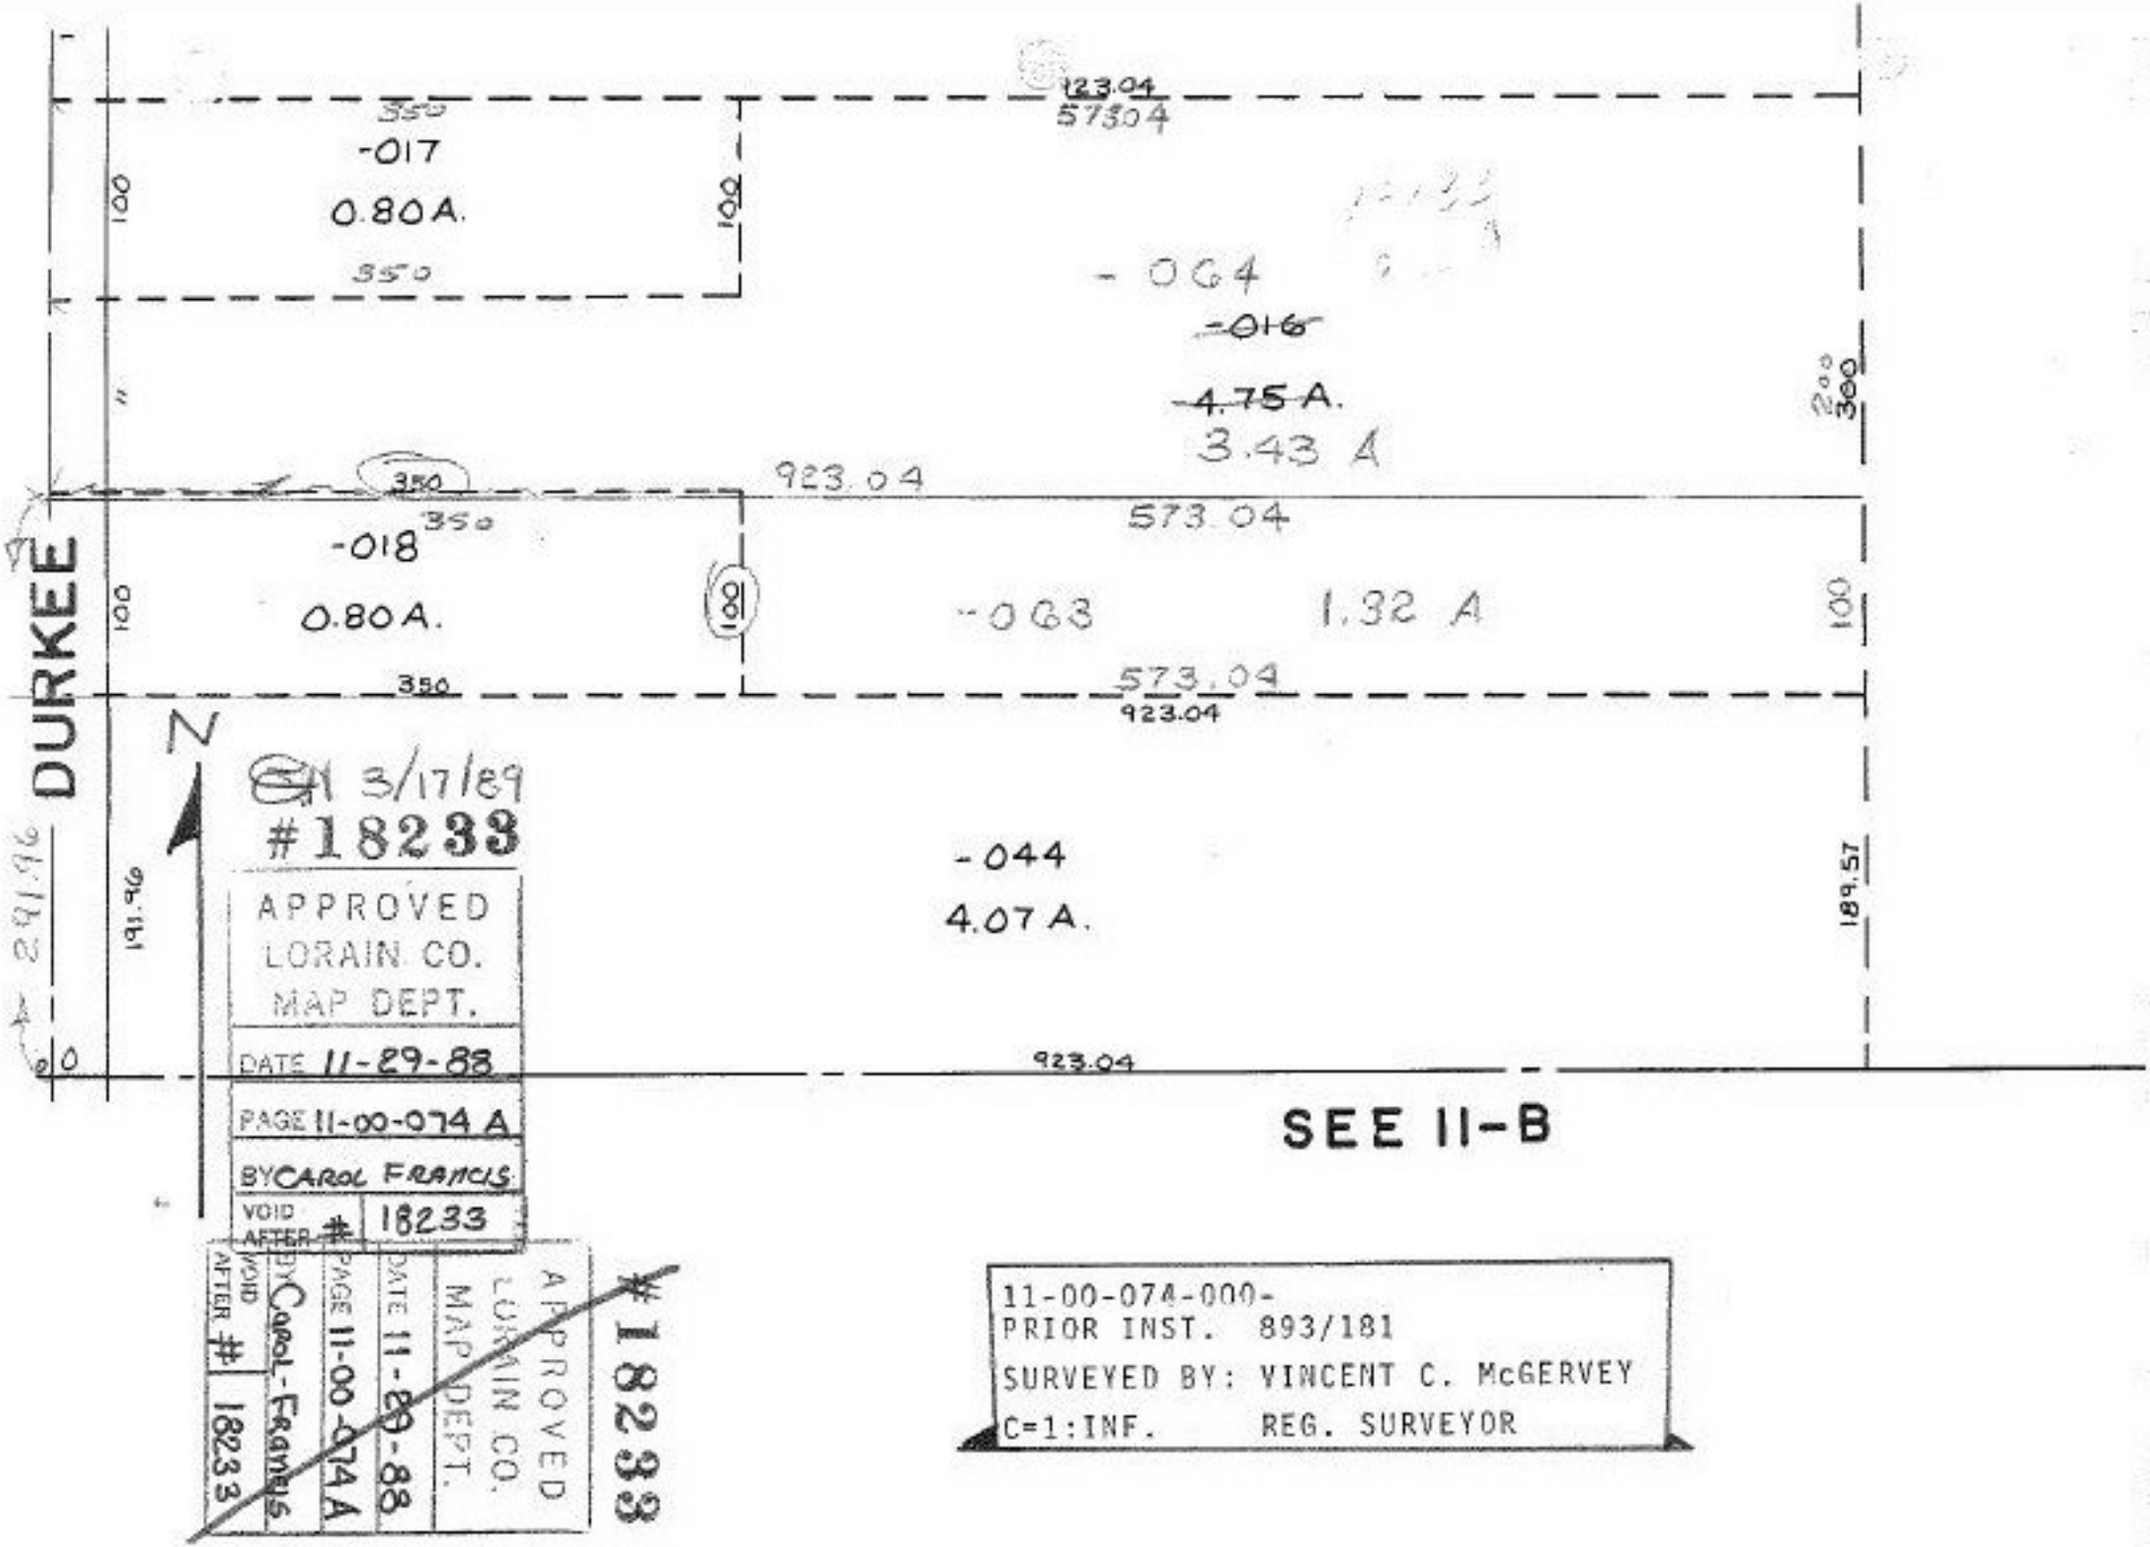
DURKEE
350
-017
0.80A.
100
100
350
123.04
573.04
-064
-016
4.75A.
3.43 A
200
300
923.04
350
350
-018
0.80A.
100
100
-063
1.32 A
573.04
573.04
923.04
N
3/17/89
#18233
APPROVED
LORAIN CO.
MAP DEPT.
DATE 11-29-88
PAGE 11-00-074 A
BY CAROL FRANCIS
VOID AFTER # 18233
-044
4.07 A.
191.96
291.96
189.57
923.04
SEE 11-B
#18233
APPROVED LORAIN CO. MAP DEPT.
DATE 11-29-88
PAGE 11-00-074 A
BY Carol Francis
VOID AFTER # 18233
11-00-074-000-
PRIOR INST. 893/181
SURVEYED BY: VINCENT C. McGERVEY
C=1:INF. REG. SURVEYOR
EATON T