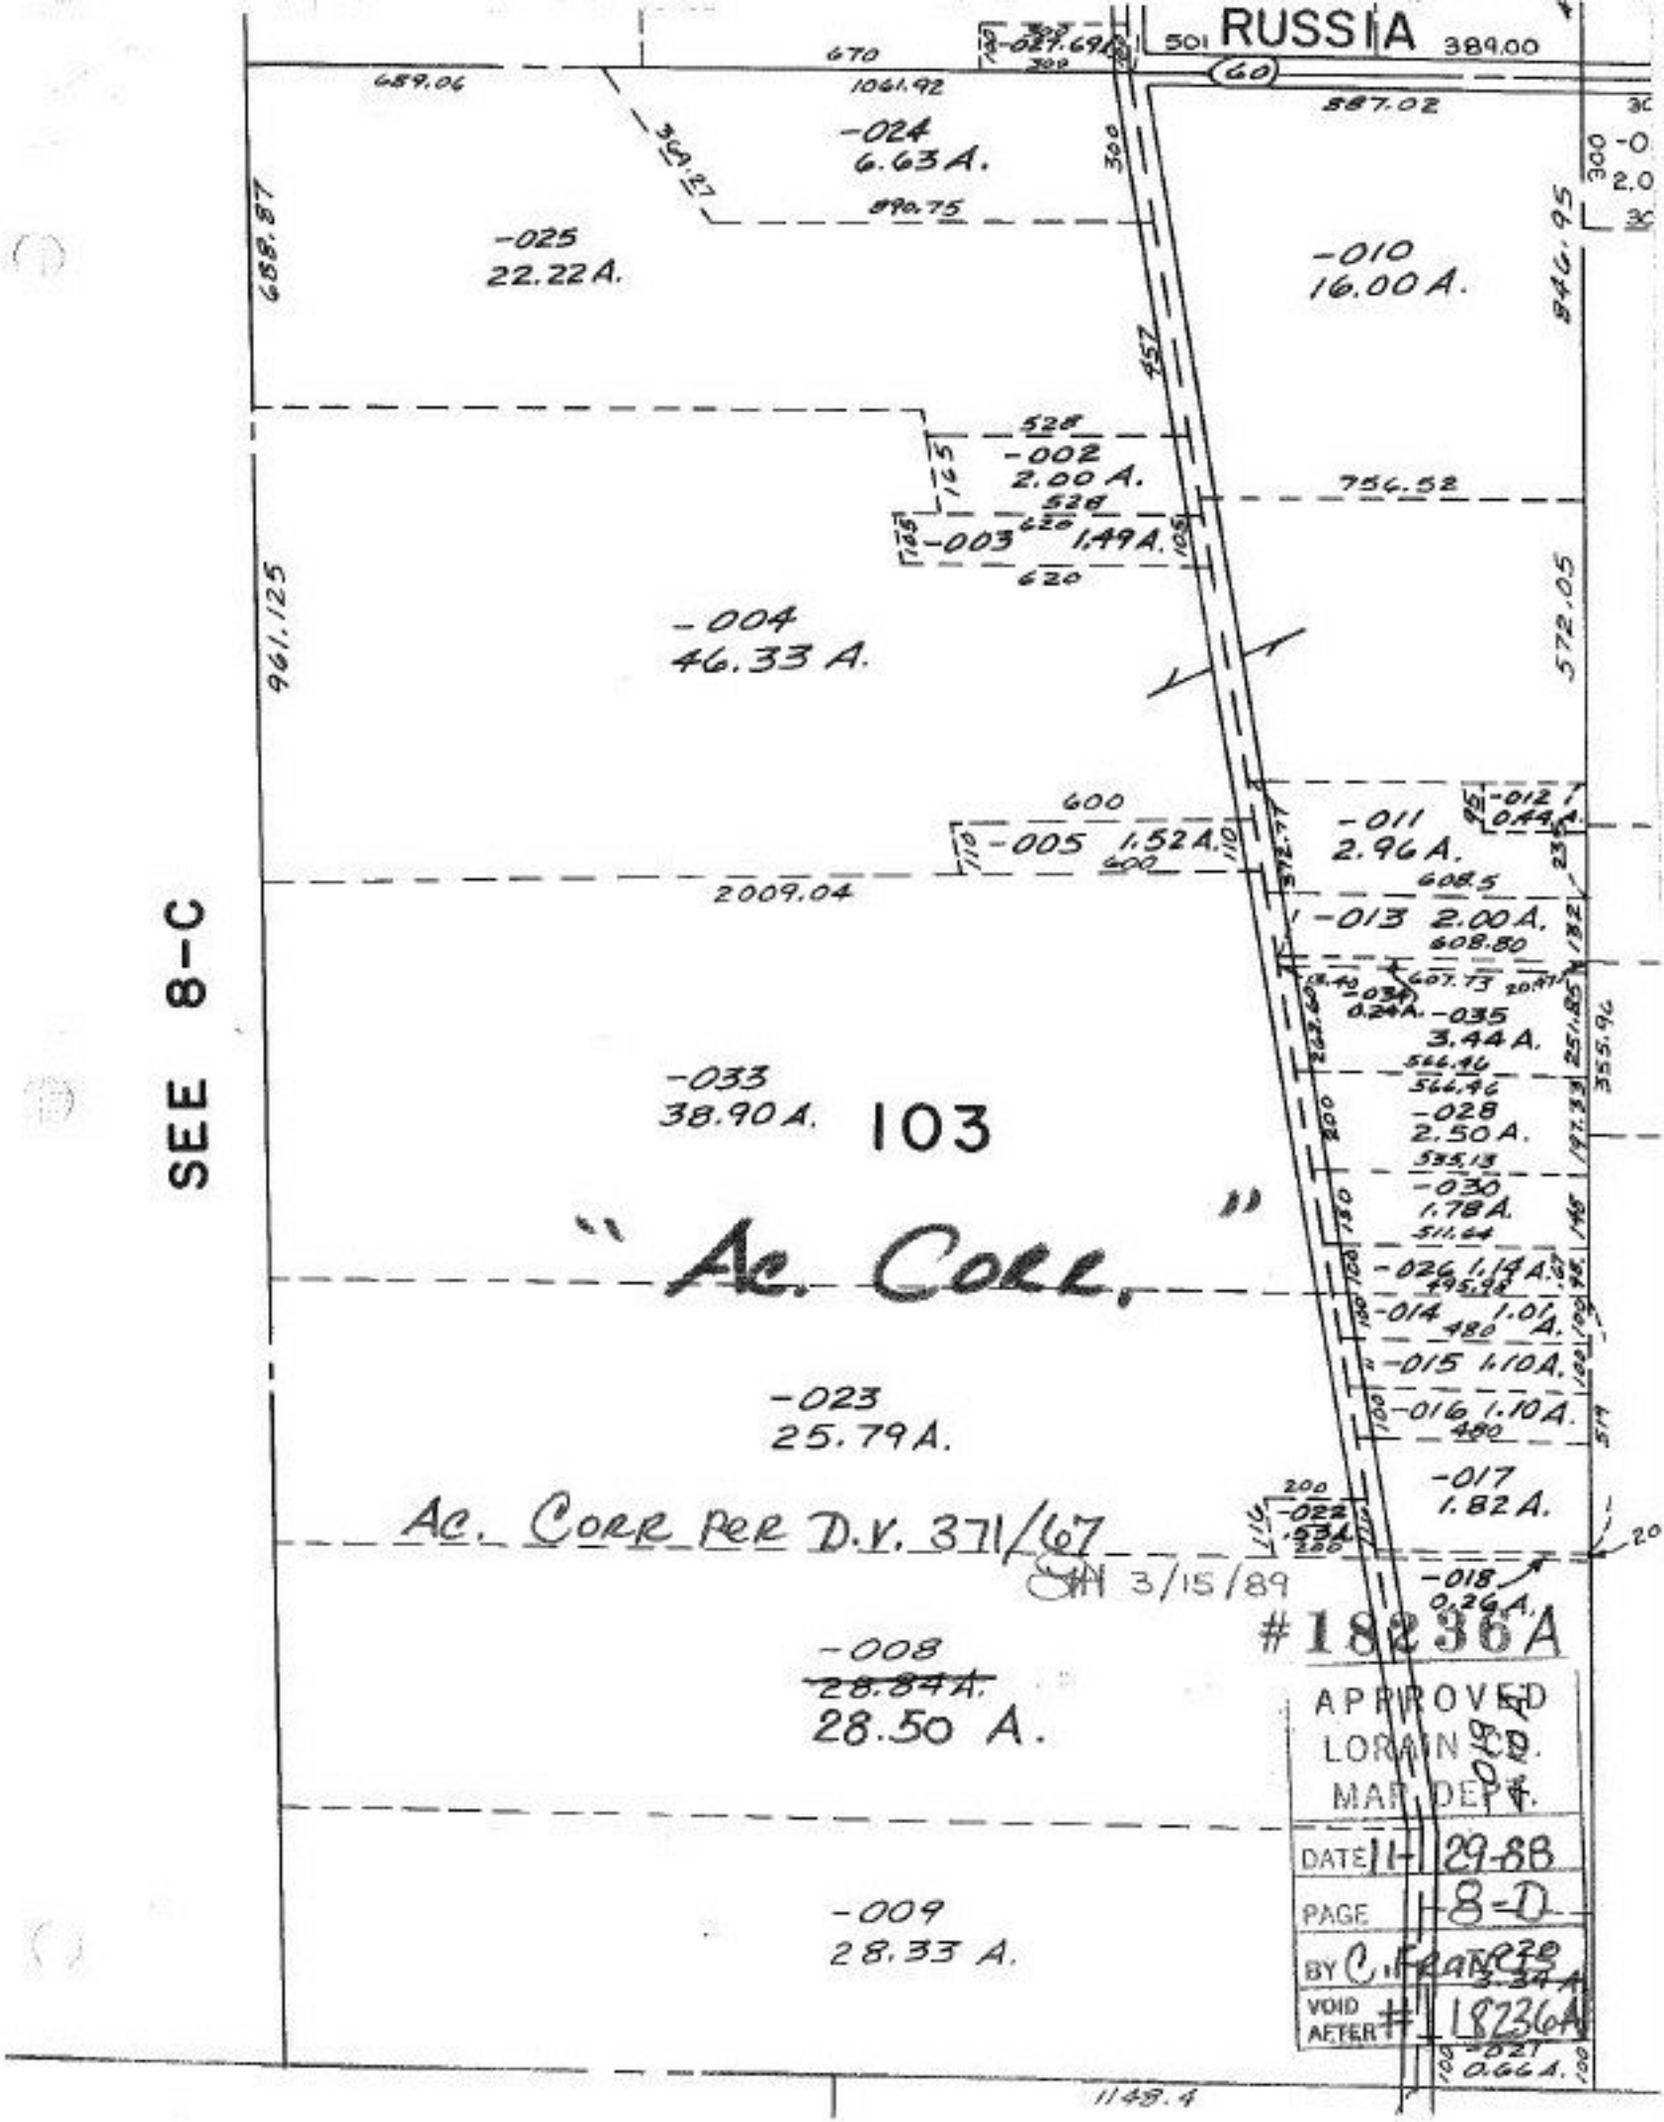
501 RUSSIA
60
389.00
689.06
1061.92
887.02
-024
6.63 A.
-025
22.22 A.
-010
16.00 A.
658.87
961.125
-002
2.00 A.
754.52
-003
1.49 A.
-004
46.33 A.
572.05
-012
0.44 A.
-011
2.96 A.
600
-005
1.52 A.
2009.04
-013
2.00 A.
608.80
-034
0.24 A.
-035
3.44 A.
-033
38.90 A.
103
-028
2.50 A.
-030
1.78 A.
"Ac. Corr."
-026
1.14 A.
-014
1.01 A.
-015
1.10 A.
-016
1.10 A.
-023
25.79 A.
-017
1.82 A.
-022
0.31 A.
-018
0.26 A.
Ac. Corr Per D.V. 371/67
3/15/89
-008
28.84 A.
28.50 A.
-009
28.33 A.
-021
0.66 A.
1148.4
SEE 8-C
#18236A
APPROVED
LORAIN CO.
MAP DEPT.
DATE 11-29-88
PAGE 8-D
BY C. FRANCIS
VOID AFTER # 18236A