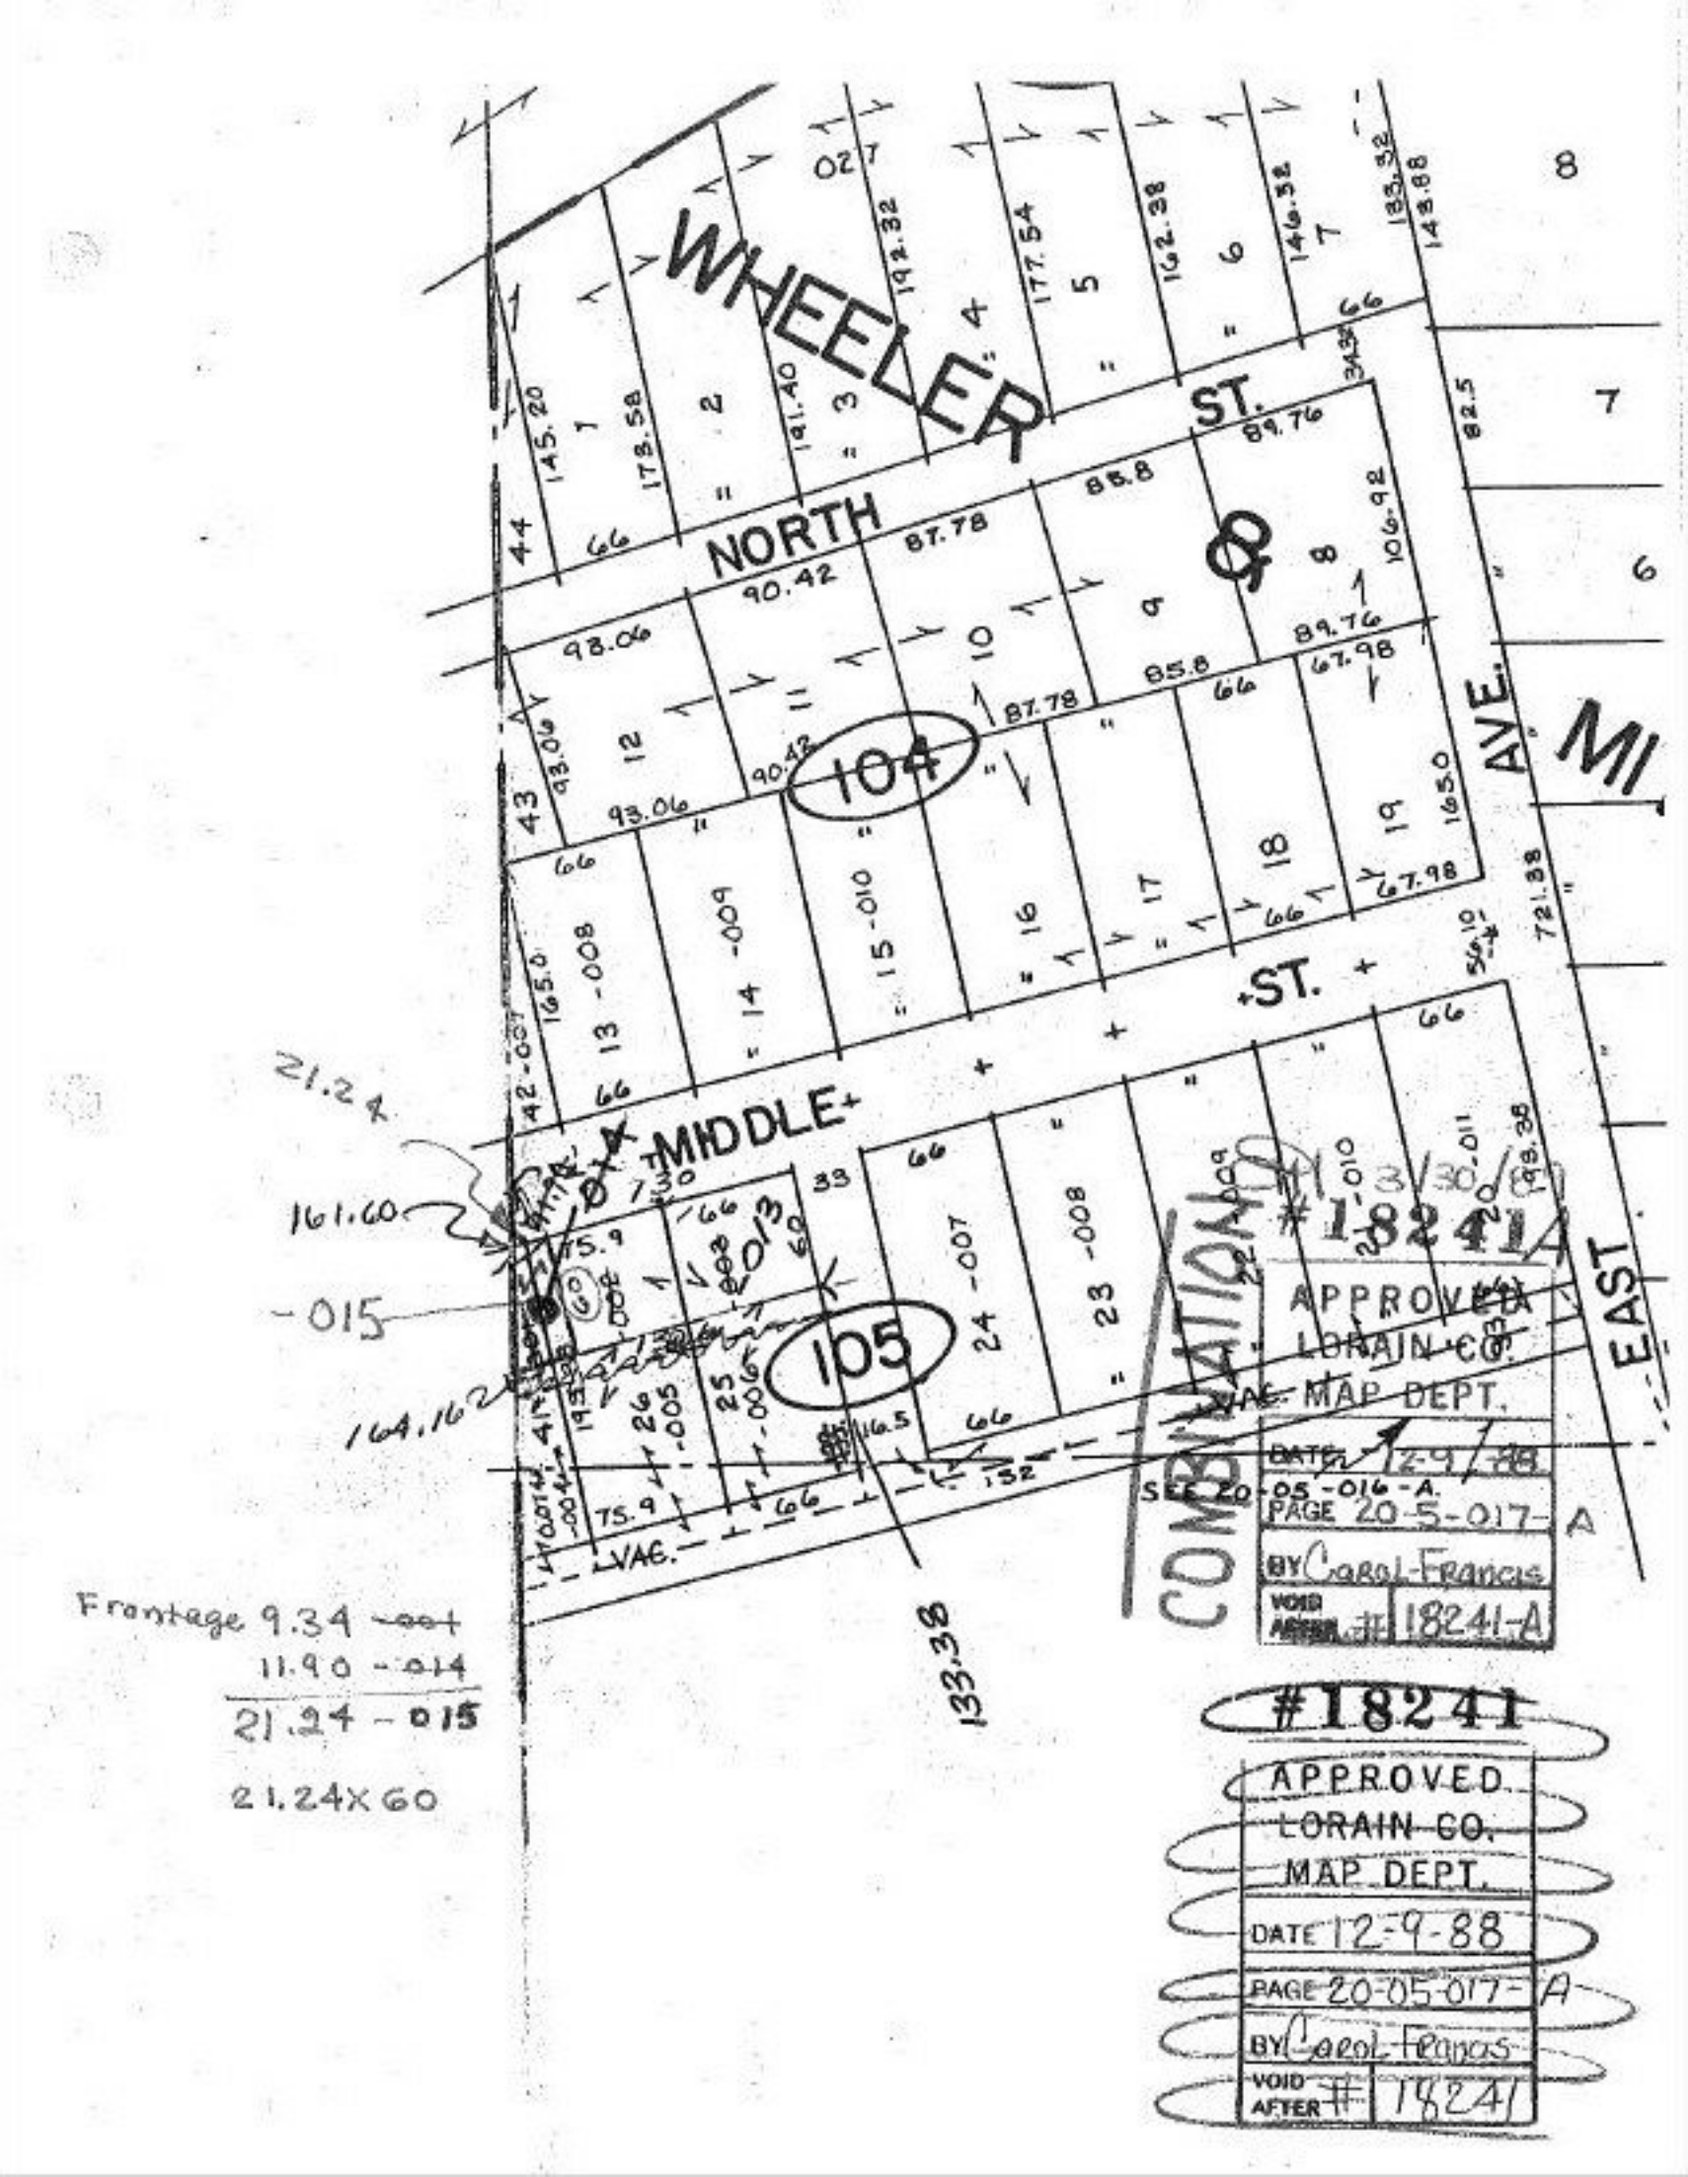

Frontage 9.34 ~~oot~~
11.90 - 014
21.24 - 015

21.24 X 60