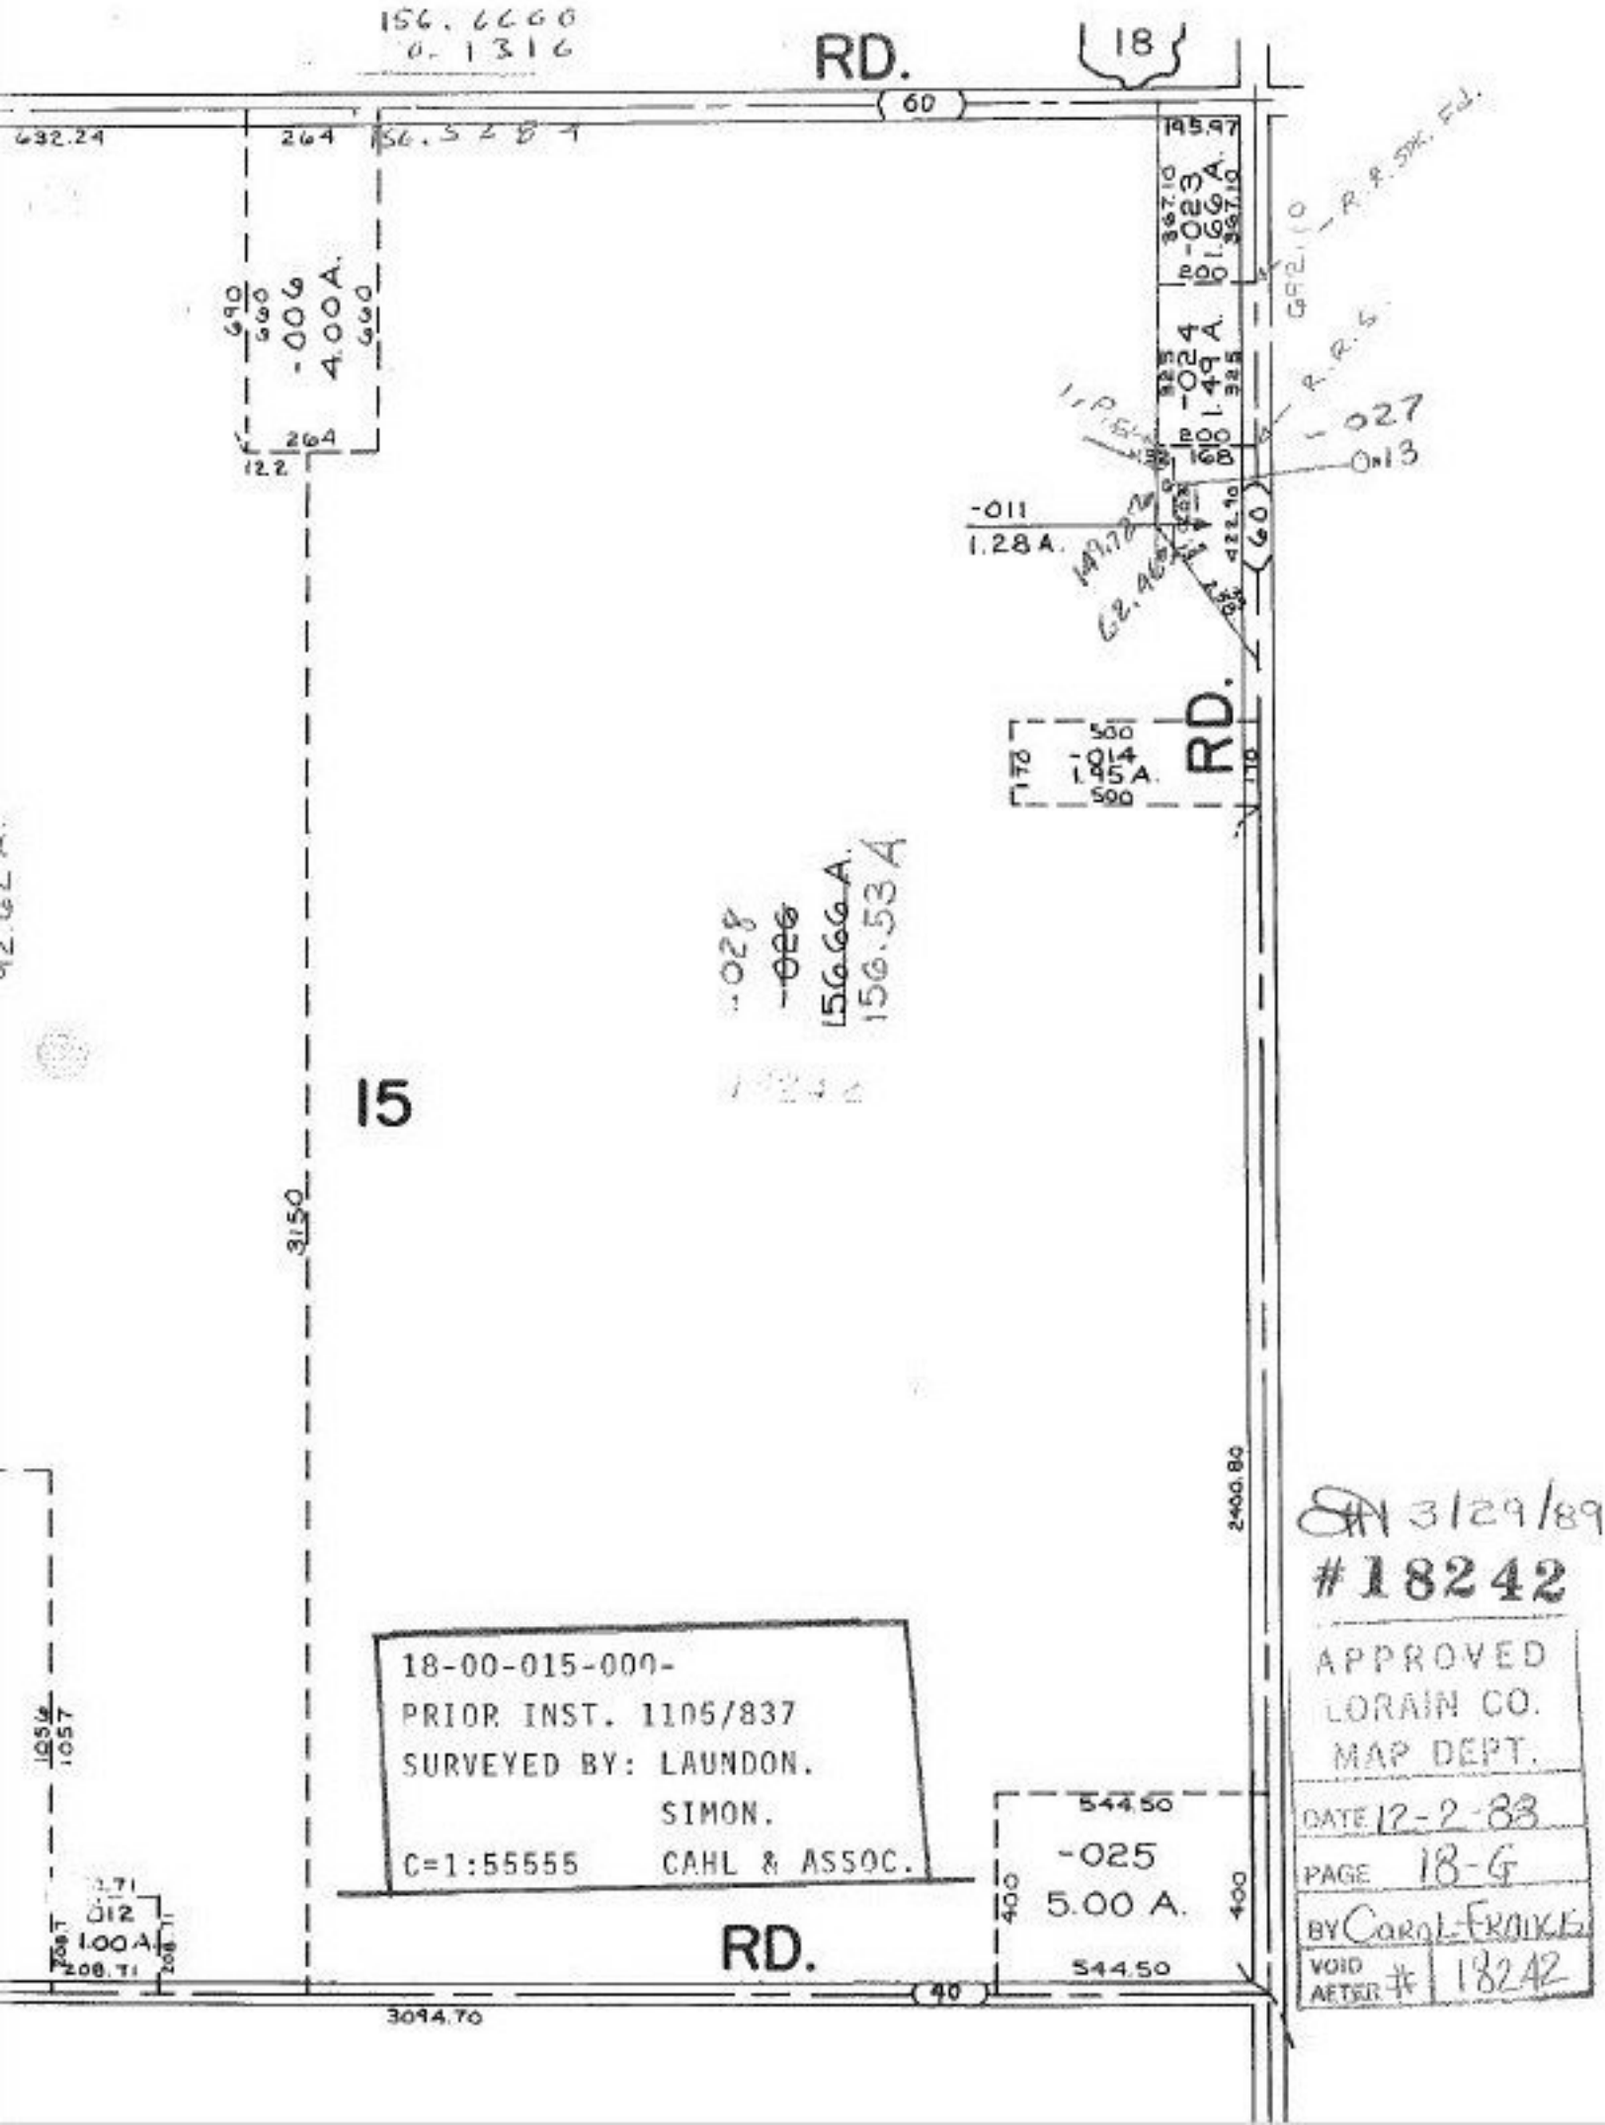
156.6660
0.1316
RD.
18
60
632.24
264
156.5284
195.97
-023
1.66A.
-024
1.49A.
-027
ON 13
-011
1.28A.
-006
4.00A.
690
660
264
122
-014
1.45A.
500
590
170
RD.
156.66A.
150.53A
-028
-026
15
3150
2400.80
544.50
-025
5.00 A.
400
544.50
RD.
3094.70
40
18-00-015-000-
PRIOR INST. 1105/837
SURVEYED BY: LAUNDON.
SIMON.
C=1:55555 CAHL & ASSOC.
3/29/89
#18242
APPROVED
LORAIN CO.
MAP DEPT.
DATE 12-2-88
PAGE 18-G
BY Carol Frauke
VOID AFTER # 18242