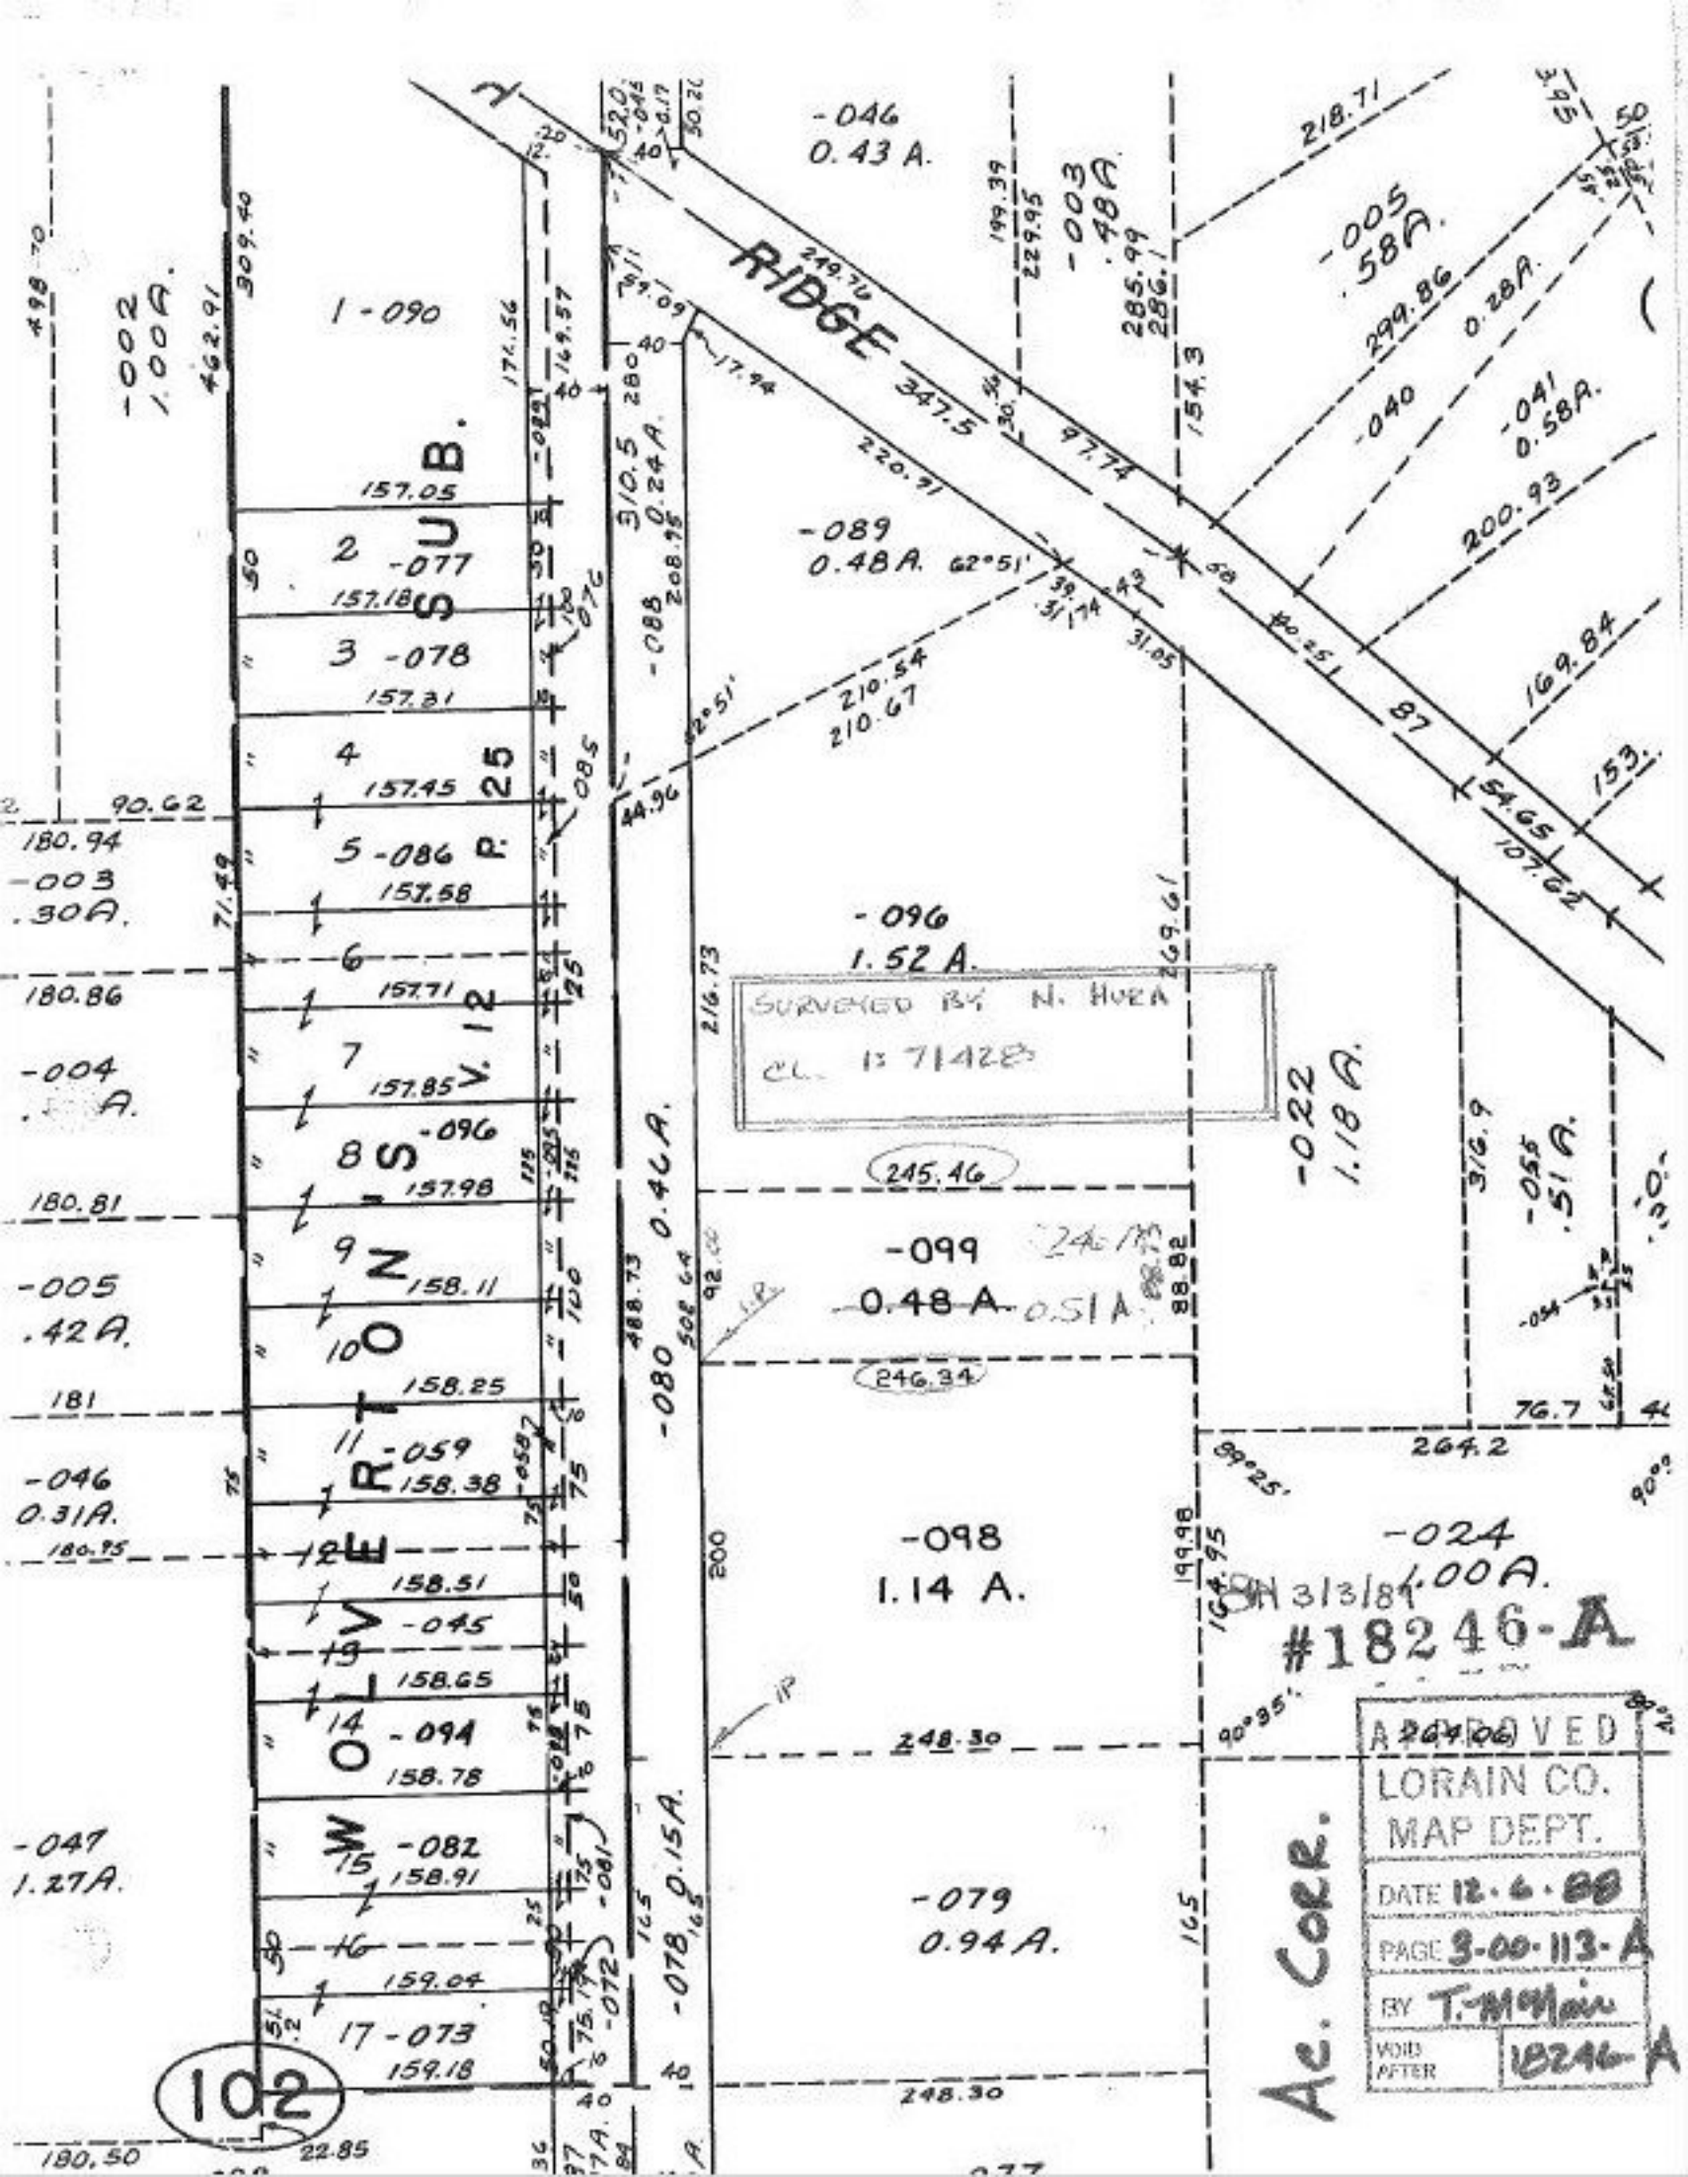
RIDGE
-046
0.43 A.
-003
.48A.
-005
.58A.
-002
1.00A.
1-090
-089
0.48A.
-088
0.24A.
-096
1.52 A.
SURVEYED BY N. HURA
-022
1.18 A.
-099
0.48 A.
-080
0.46A.
-098
1.14 A.
-024
1.00A.
-079
0.94A.
-047
1.27A.
-041
0.58A.
0.28A.
2 -077
3 -078
4
5 -086
6
7
8 -096
9
10
11 -059
12
13 -045
14 -094
15 -082
16
17 -073
#18246-A
APPROVED
LORAIN CO.
MAP DEPT.
DATE 12-6-88
PAGE 3-00-113-A
BY T. McMain
VOID AFTER 18246-A
Ac. Corr.
102