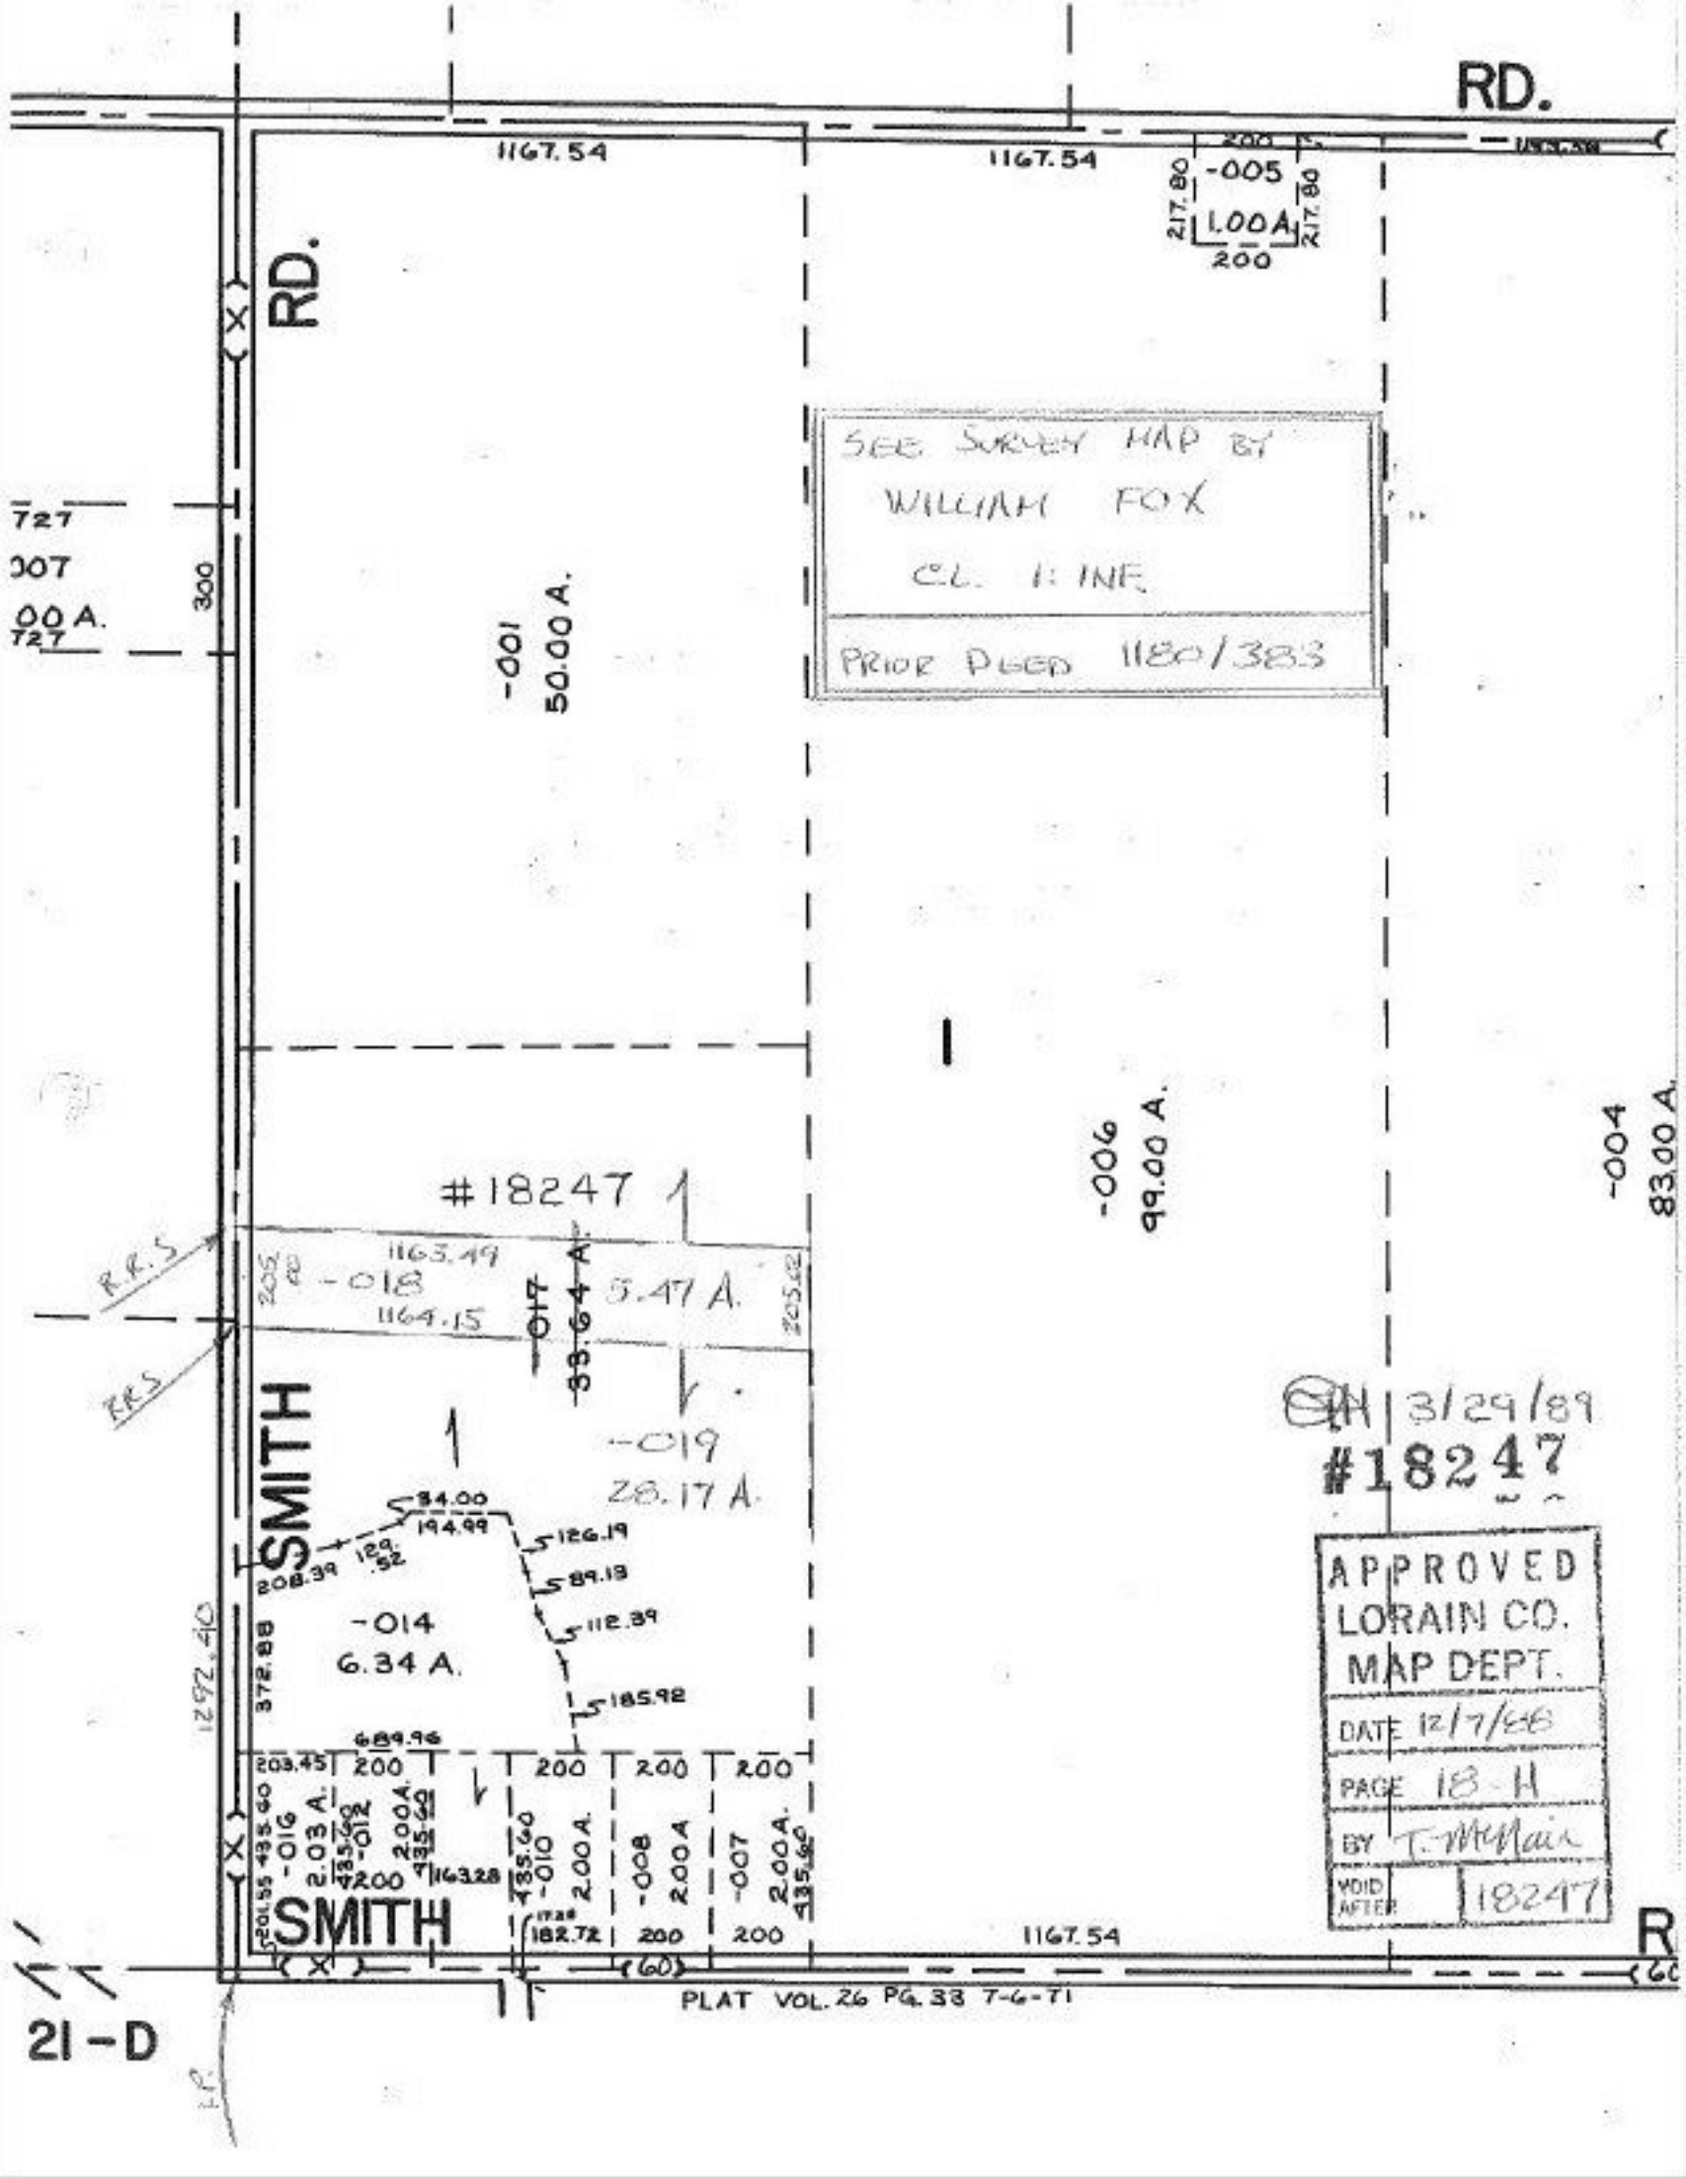
RD.
1167.54
1167.54
-005
1.00 A.
217.80
217.80
200
RD.
SEE SURVEY MAP BY
WILLIAM FOX
C.L. 1: INF.
PRIOR DEED 1180/383
727
007
00 A.
727
300
-001
50.00 A.
-006
99.00 A.
-004
83.00 A.
#18247
R.R.S
R.R.S
1163.49
-018
1164.15
-017
33.64 A.
5.47 A.
205.02
205.02
-019
28.17 A.
SMITH
34.00
194.99
126.19
89.13
112.39
185.92
208.39
129.52
-014
6.34 A.
372.88
1292.40
689.96
203.45
200
200
200
200
-016
2.03 A.
-012
2.00 A.
435.60
435.60
435.60
435.60
-010
2.00 A.
-008
2.00 A.
-007
2.00 A.
435.60
201.55
200
163.28
182.72
200
200
SMITH
1167.54
R
PLAT VOL. 26 PG. 33 7-6-71
21-D
3/29/89
#18247
APPROVED
LORAIN CO.
MAP DEPT.
DATE 12/7/88
PAGE 18-H
BY T. McNair
VOID AFTER 18247