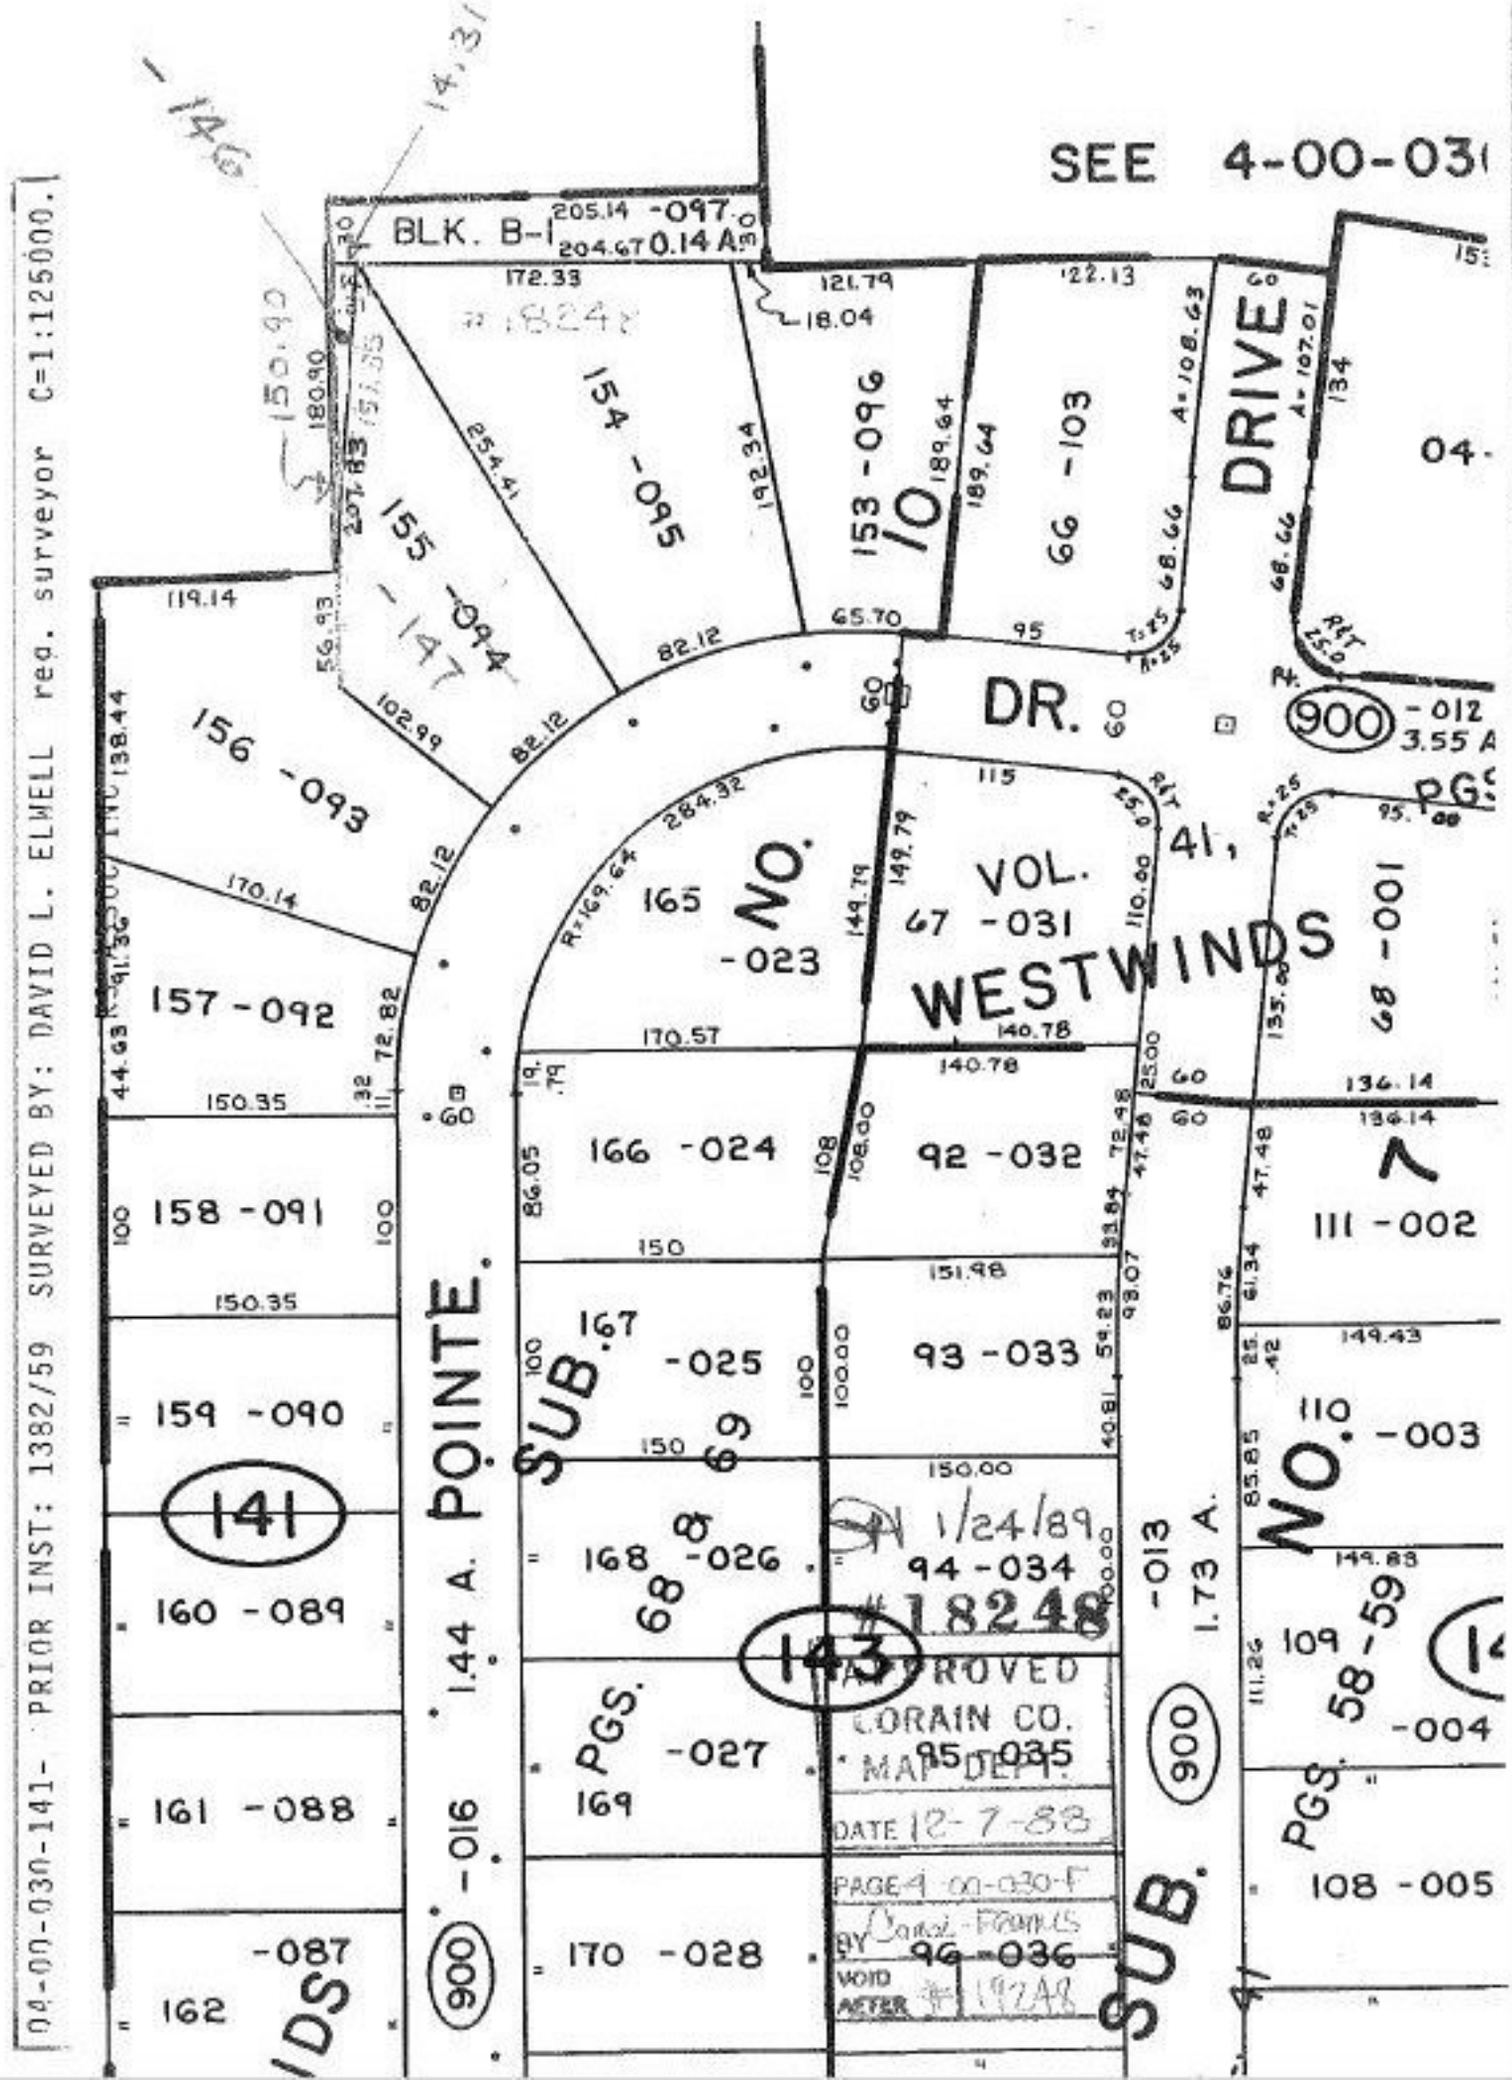
04-00-030-141- PRIOR INST: 1382/59 SURVEYED BY: DAVID L. ELWELL reg. surveyor C=1:125000.
SEE 4-00-030
BLK. B-1
205.14 -097
204.67 0.14 A
154 -095
153 -096
66 -103
155 -094
-147
156 -093
157 -092
158 -091
159 -090
160 -089
161 -088
162 -087
165 -023
166 -024
167 -025
168 -026
169 -027
170 -028
92 -032
93 -033
94 -034
95 -035
96 -036
67 -031
68 -001
111 -002
110 -003
109 -004
108 -005
DRIVE
DR.
VOL. 41,
WESTWINDS
NO. 10
SUB.
POINTE
1.44 A.
1.73 A.
PGS. 68 & 69
PGS. 58-59
PGS. 169
141
143
900 -016
900 -012
3.55 A
900 -013
1/24/89
#18248
APPROVED
LORAIN CO.
MAP DEPT.
DATE 12-7-88
PAGE 4-00-030-F
BY Carol Francis
VOID AFTER #19248