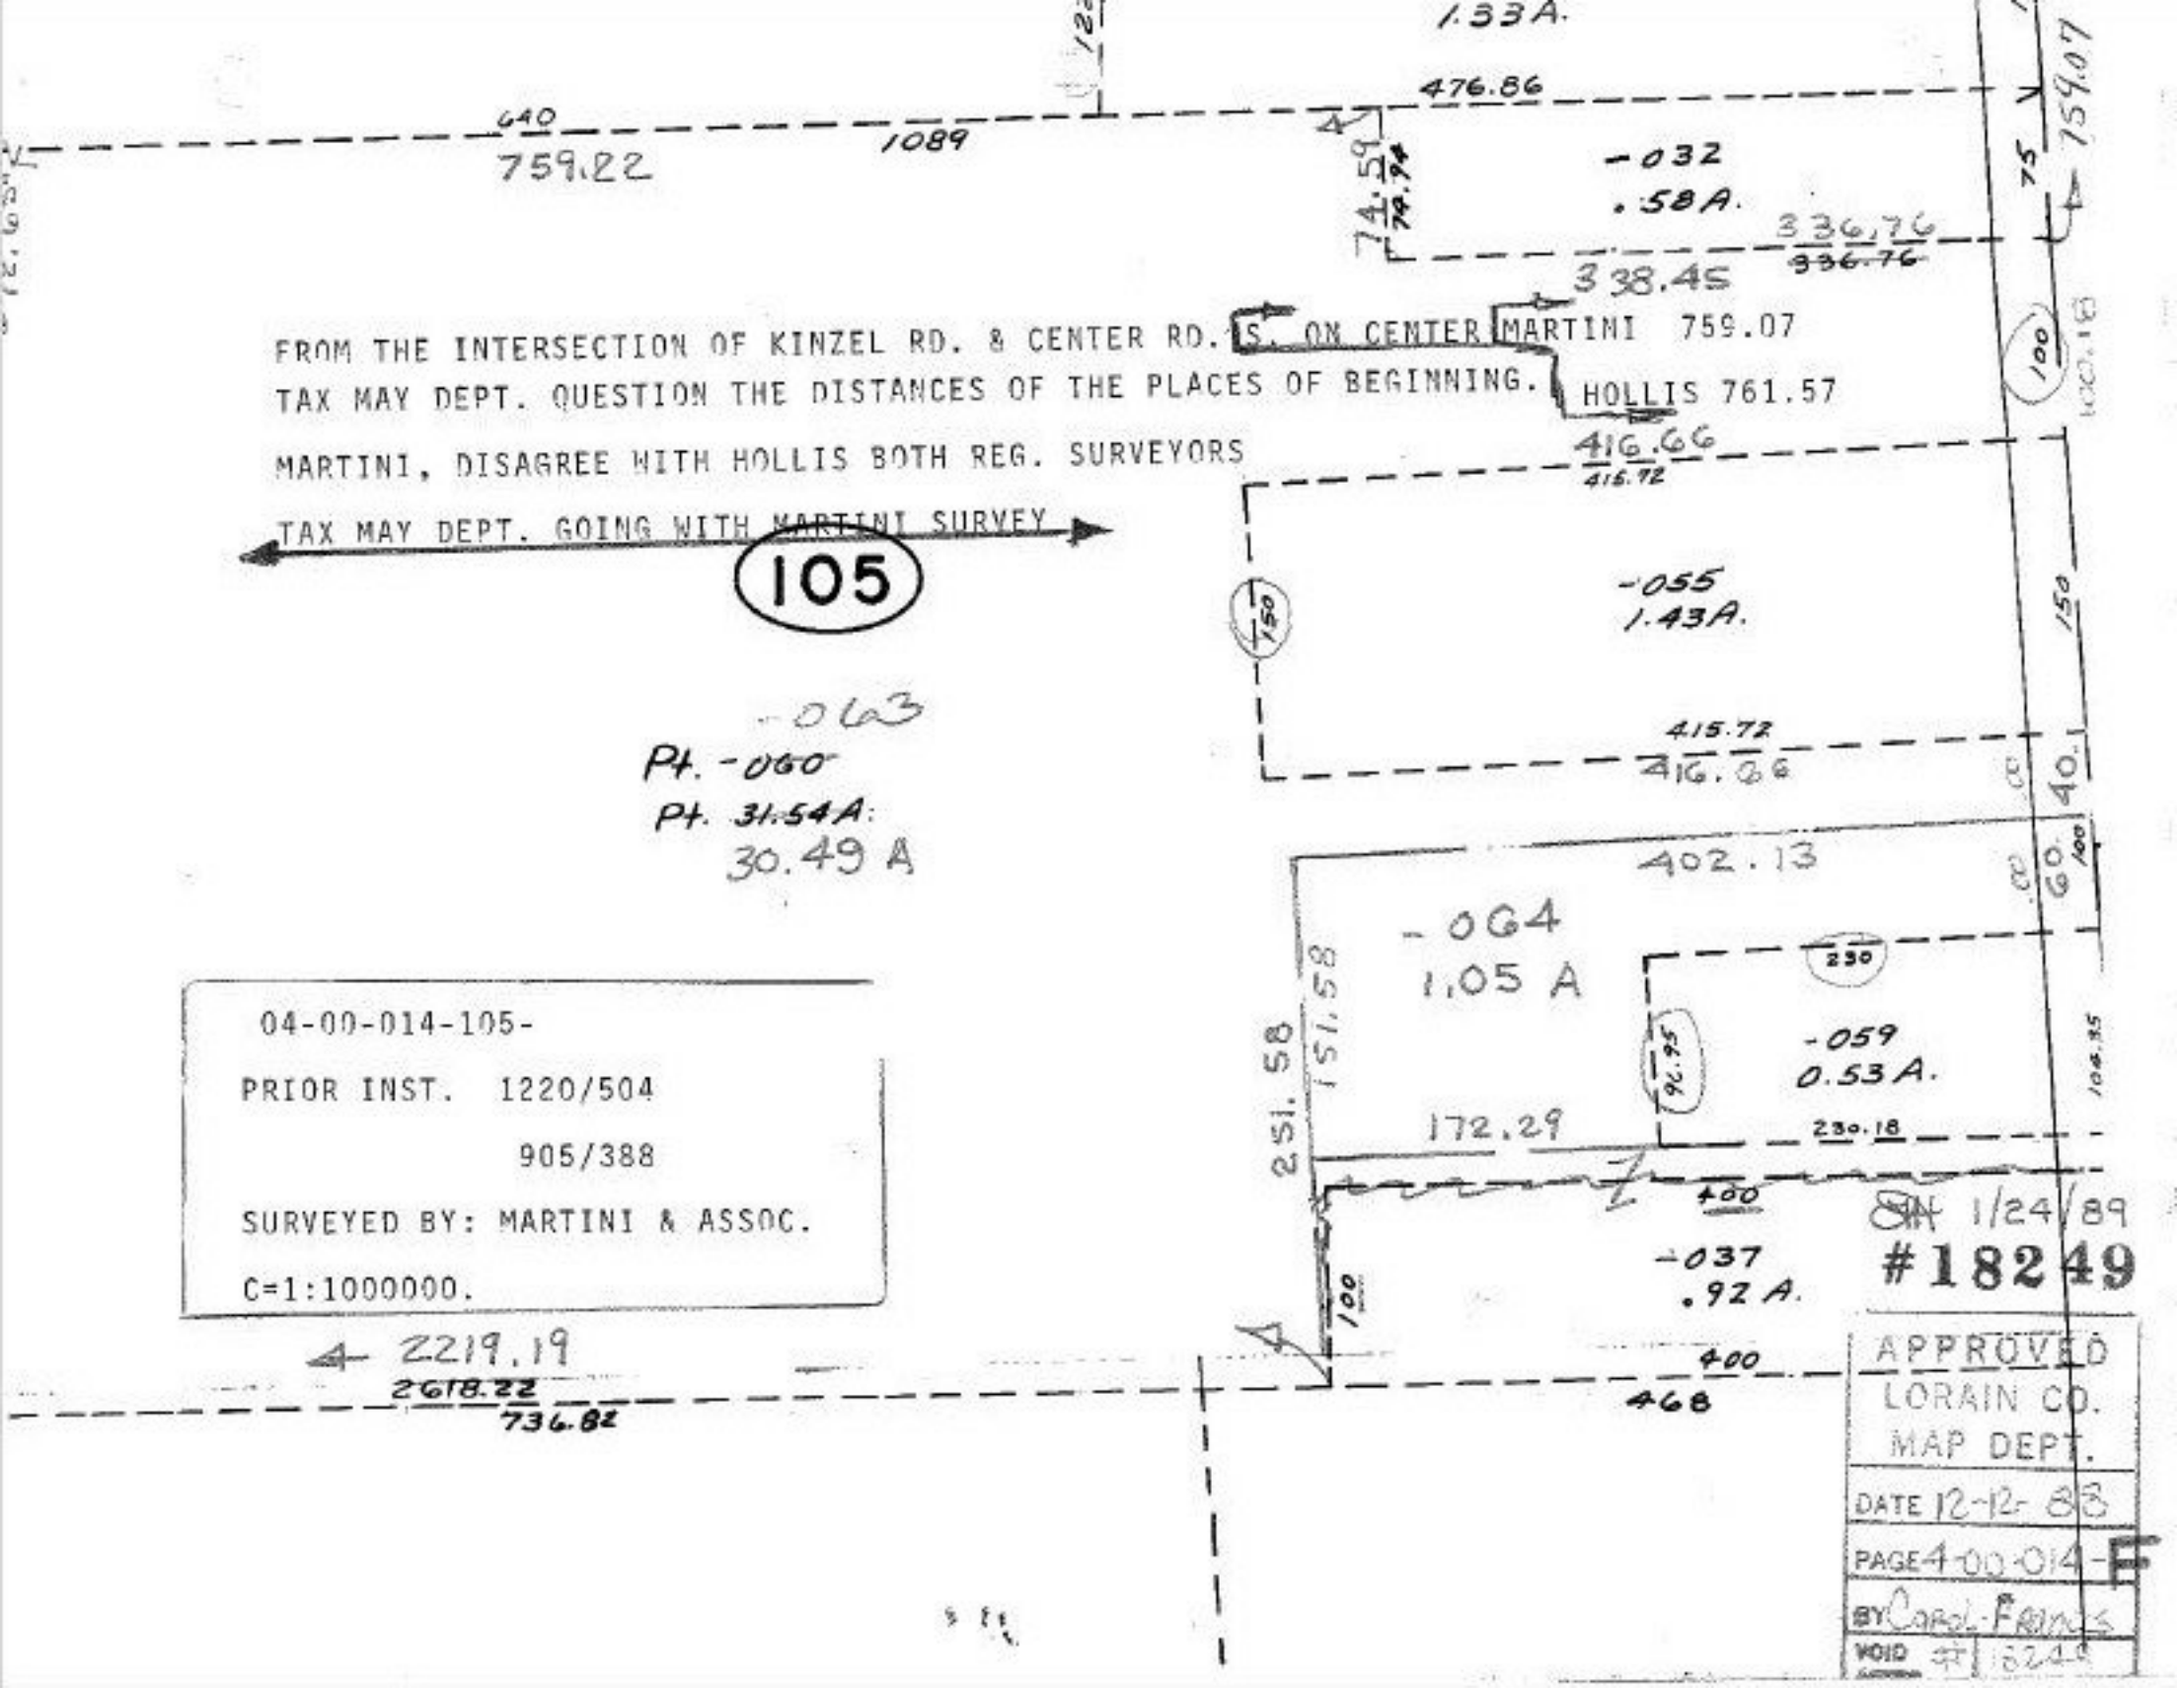

04-00-014-105-

PRIOR INST. 1220/504

905/388

SURVEYED BY: MARTINI & ASSOC.

C=1:1000000.