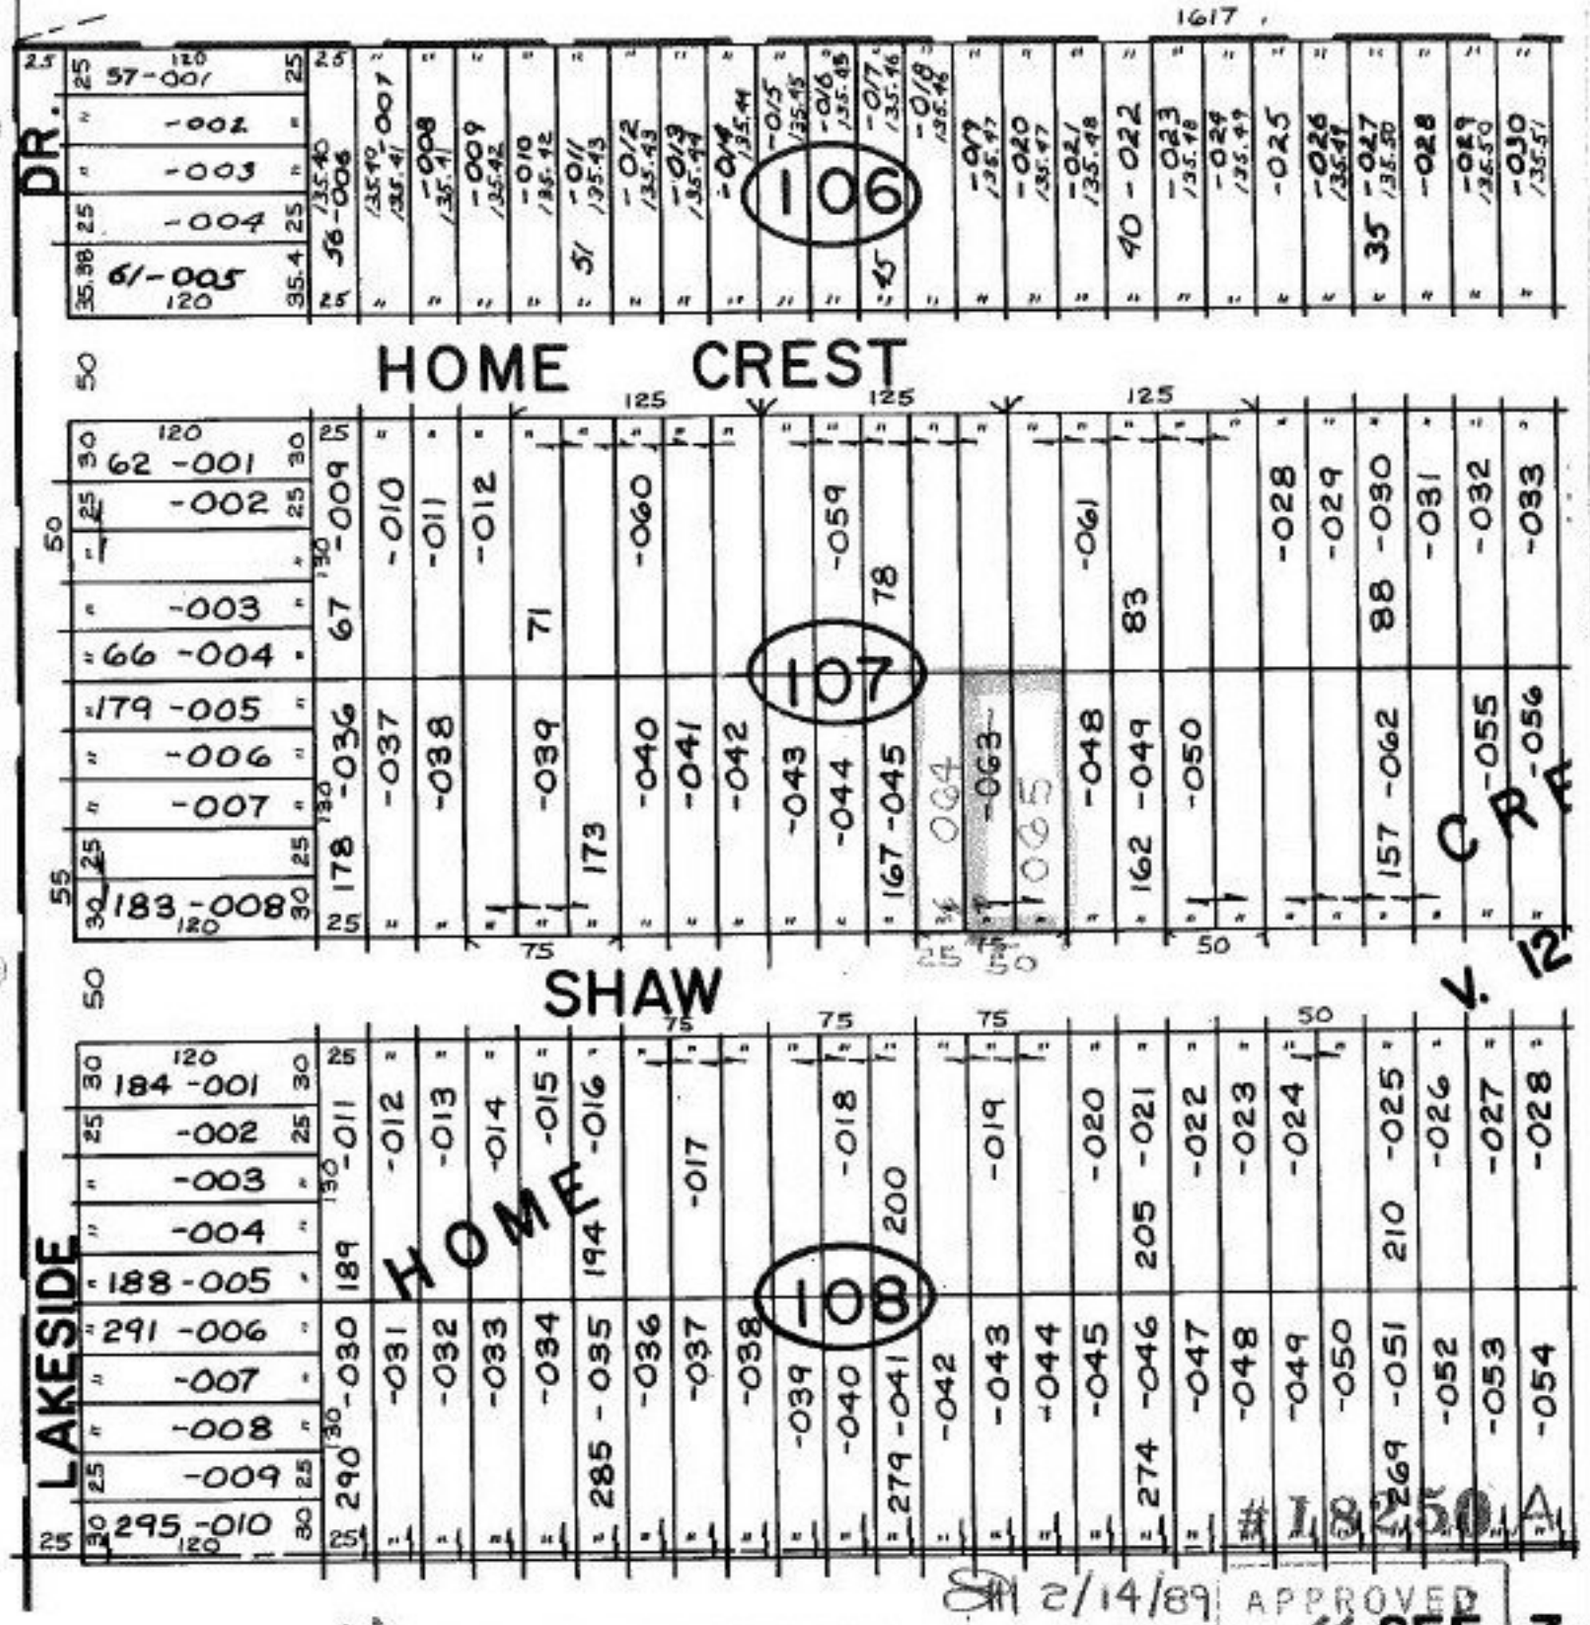

"UNCOMBINATION"

THIS IS A REQUEST TO UNCOMBINE THIS PARCEL NUMBER
REASON: WHEN THIS WAS COMBINED THERE WAS AN ERROR
MADE ON OWNERSHIP ON THE DUPLICATE. THE ERROR WAS
BY THE TRANSFER DEPARTMENT.