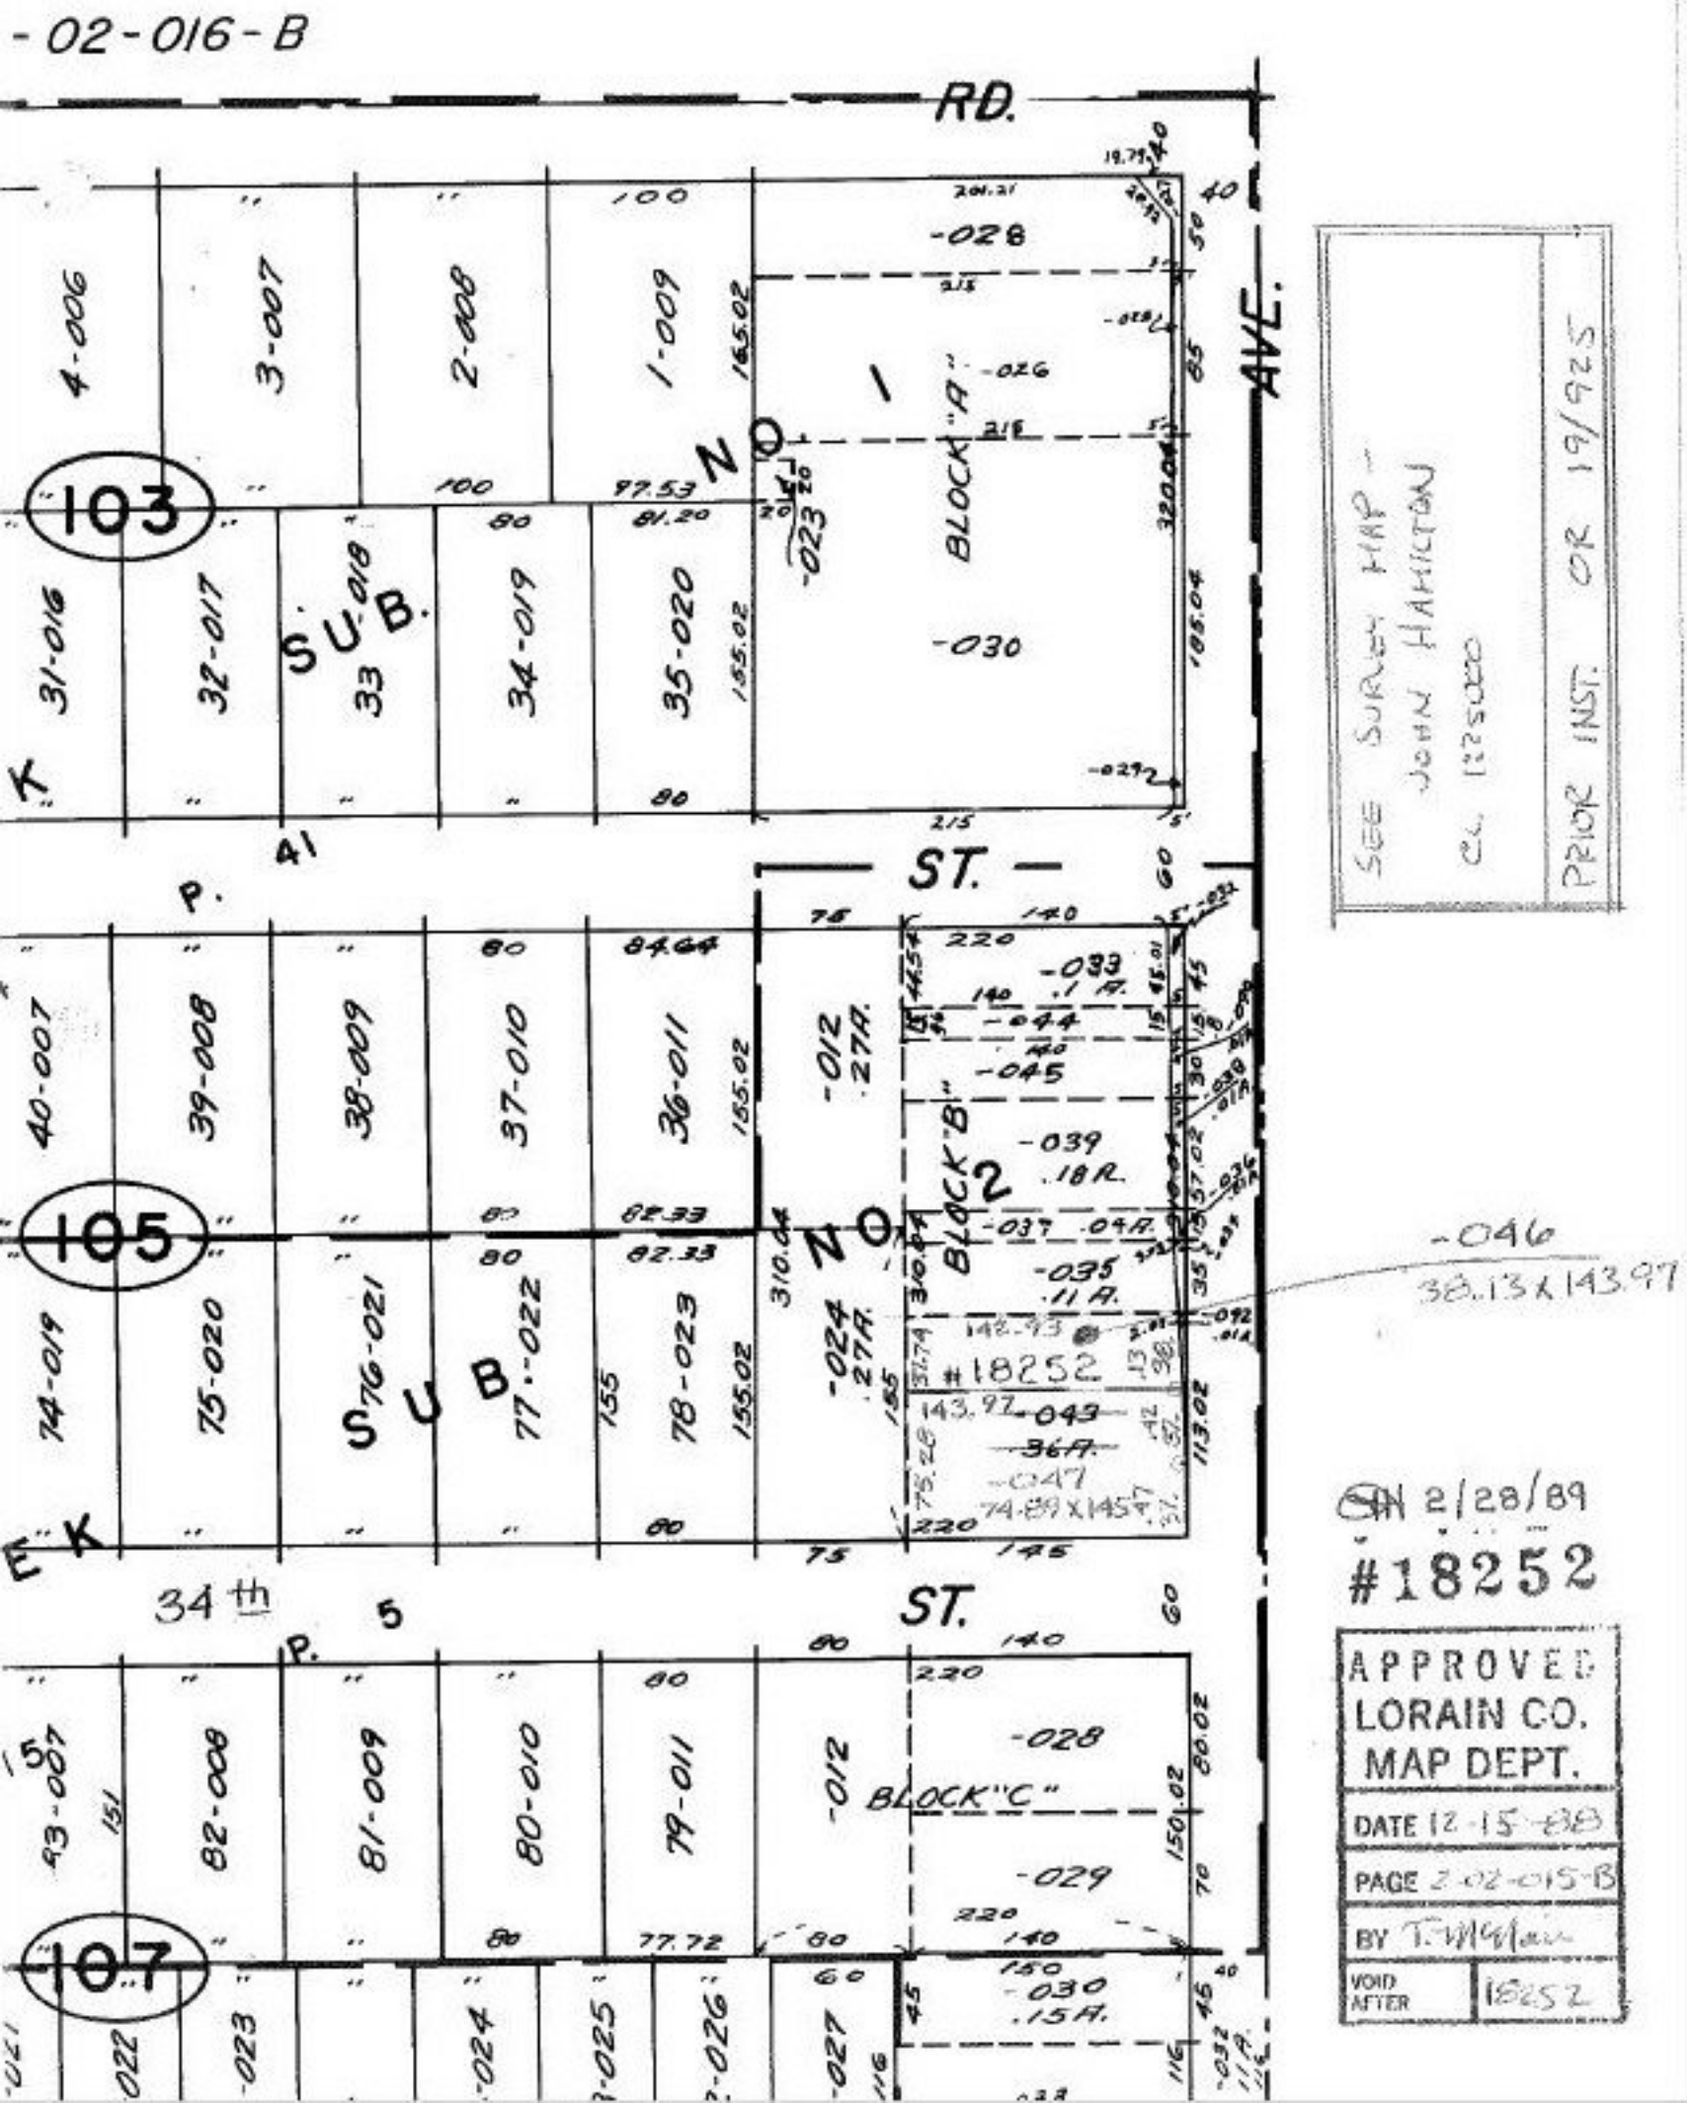
-02-016-B
RD.
AVE.
ST.
103
105
107
SUB.
NO 1
NO 2
BLOCK "A"
BLOCK "B"
BLOCK "C"
34th
#18252
-046
38.13 x 143.97
SEE SURVEY MAP - JOHN HAMILTON CL. 1225000
PRIOR INST. OR 19/925
2/28/89
#18252
APPROVED
LORAIN CO.
MAP DEPT.
DATE 12-15-88
PAGE 2-02-015-B
BY
VOID AFTER 18252