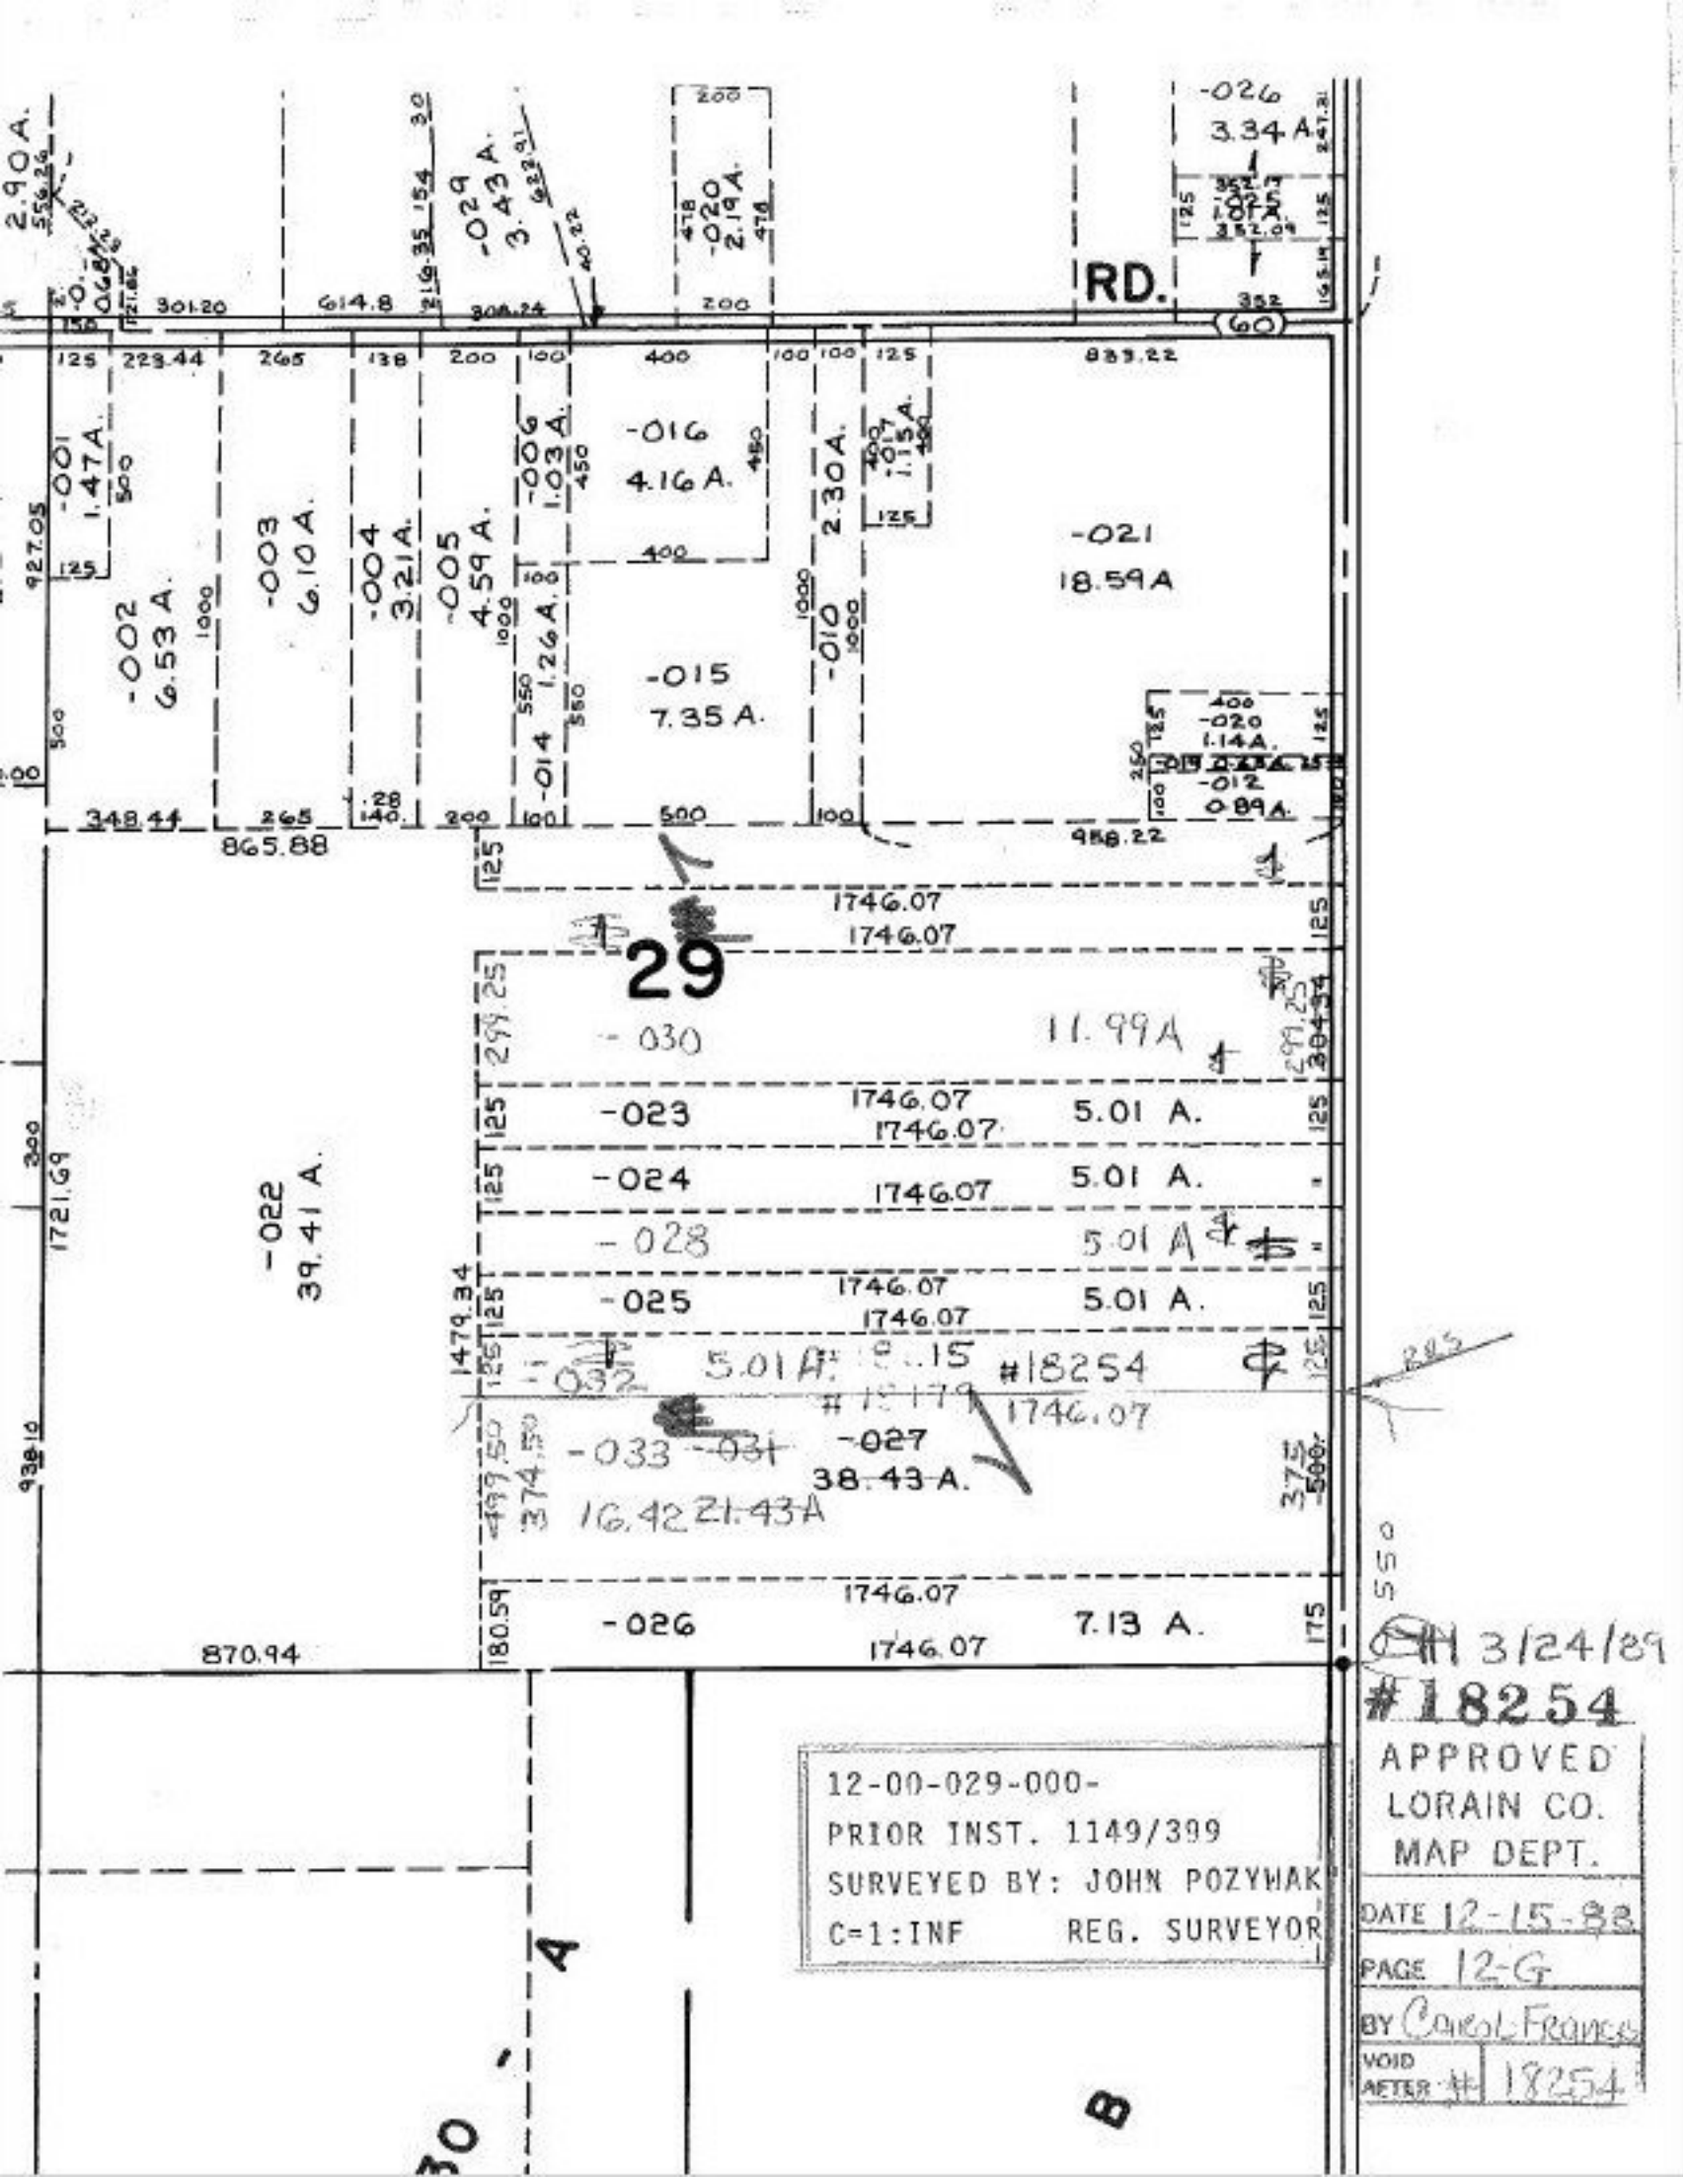

12-00-029-000-
PRIOR INST. 1149/399
SURVEYED BY: JOHN POZYWAK
C=1:INF REG. SURVEYOR

3/24/89
#18254
APPROVED
LORAIN CO.
MAP DEPT.
DATE 12-15-88
PAGE 12-G
BY Carol Frances
VOID
AFTER #: 18254